DIST. NO.	STATE	FED. RD. PROJ. NO.	FISCAL YEAR	SHEET NO.	TOTAL SHEETS
9	VT	100-H	1936	9	65

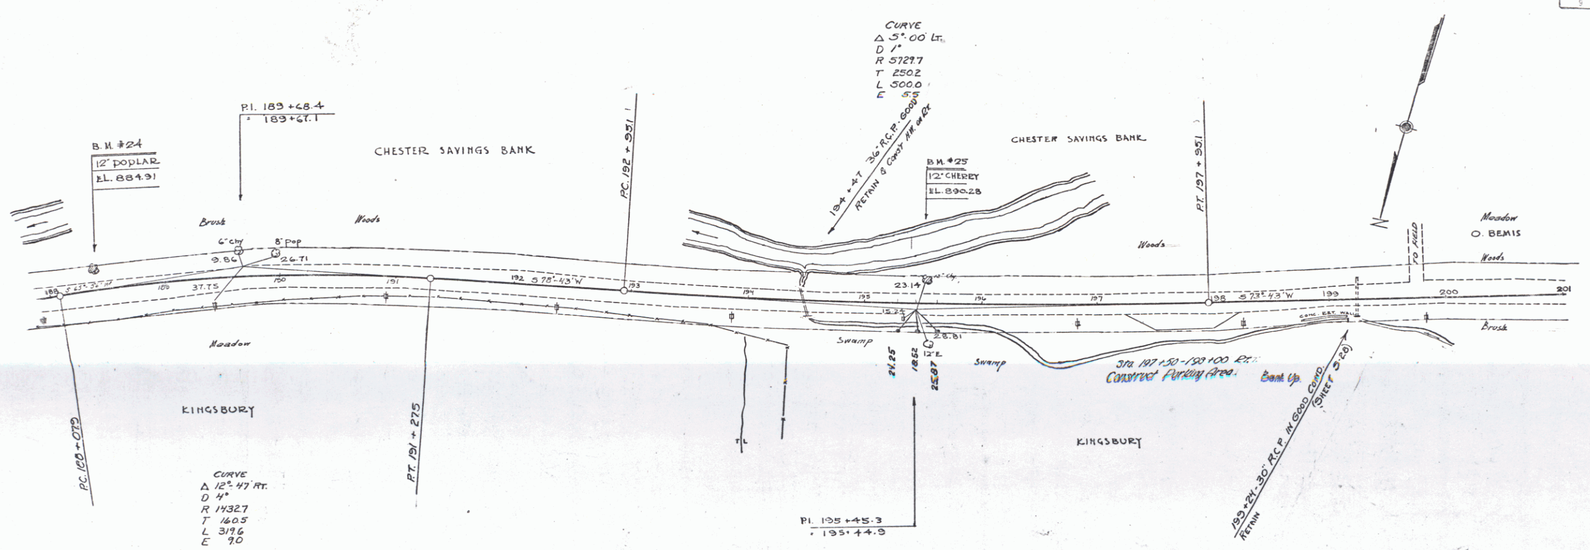

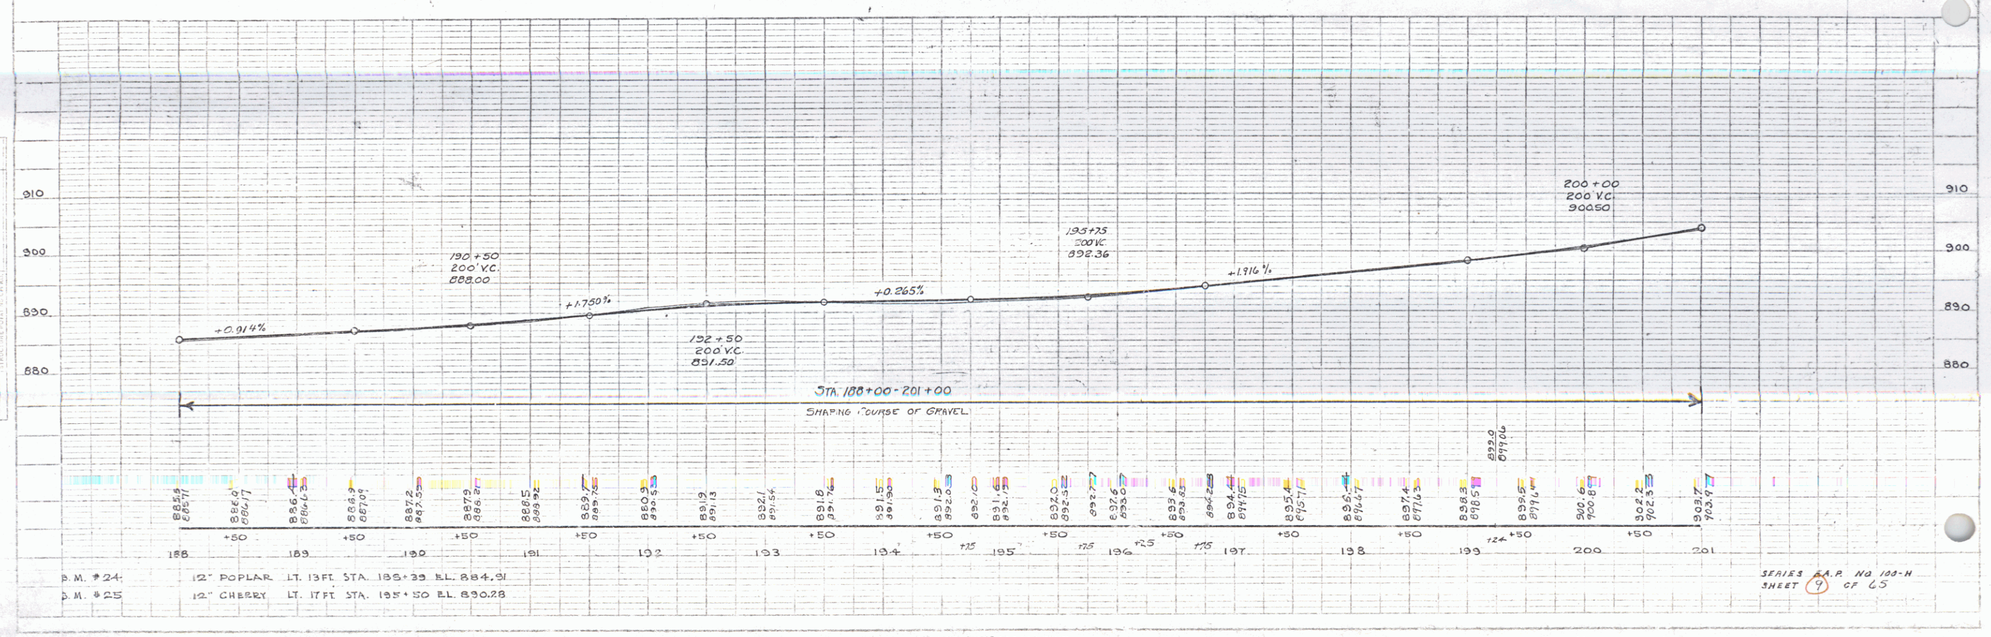

B.M. #24 12" POPLAR LT. 13 FT. STA. 189+39 EL. 884.91

B.M. #25 12" CHERRY LT. 17 FT. STA. 195+50 EL. 890.28

SERIES B.A.R. NO. 100-H
SHEET 9 OF 65

7