FED. ROAD DIST. NO.	STATE	FED. AID PROJ. NO.	FISCAL YEAR	SHEET NO.	TOTAL SHEETS
5	VT.	100-H	1936	11	65

FED. ROAD DIST. NO.	STATE	FED. AID PROJ. NO.	FISCAL YEAR	SHEET NO.	TOTAL SHEETS

Parcel	Kind of Instrument	Date of Instrument	Grantor	Grantee	Recorded Chester Book	Page	Date	Remarks
A, B, C, D	Q.C.D.	12-29-34	Oscar Bemis	St. of Vt.	32	218	1-5-35	Sec 100 P
A'	W.D.	7-31-36	" "	" " "	32	354	8-6-36	
A''	Q.C.D.	7-31-36	" "	" " "	32	355	8-6-36	
A''''	W.D.	7-26-35	O.H. Bemis	St. of Vt.	32	126	9-15-35	Sec E100 G

~Note~
Existing Guard Rail
Sta 220+20 — 222+18 Lt.
" 220+58 — 222+32 Rt.
" 222+945 — 224+19 Lt.
" 223+08 — 223+30 Rt.
Guard rail to remain the property of the State and is to be removed and reset (Item 67-8)

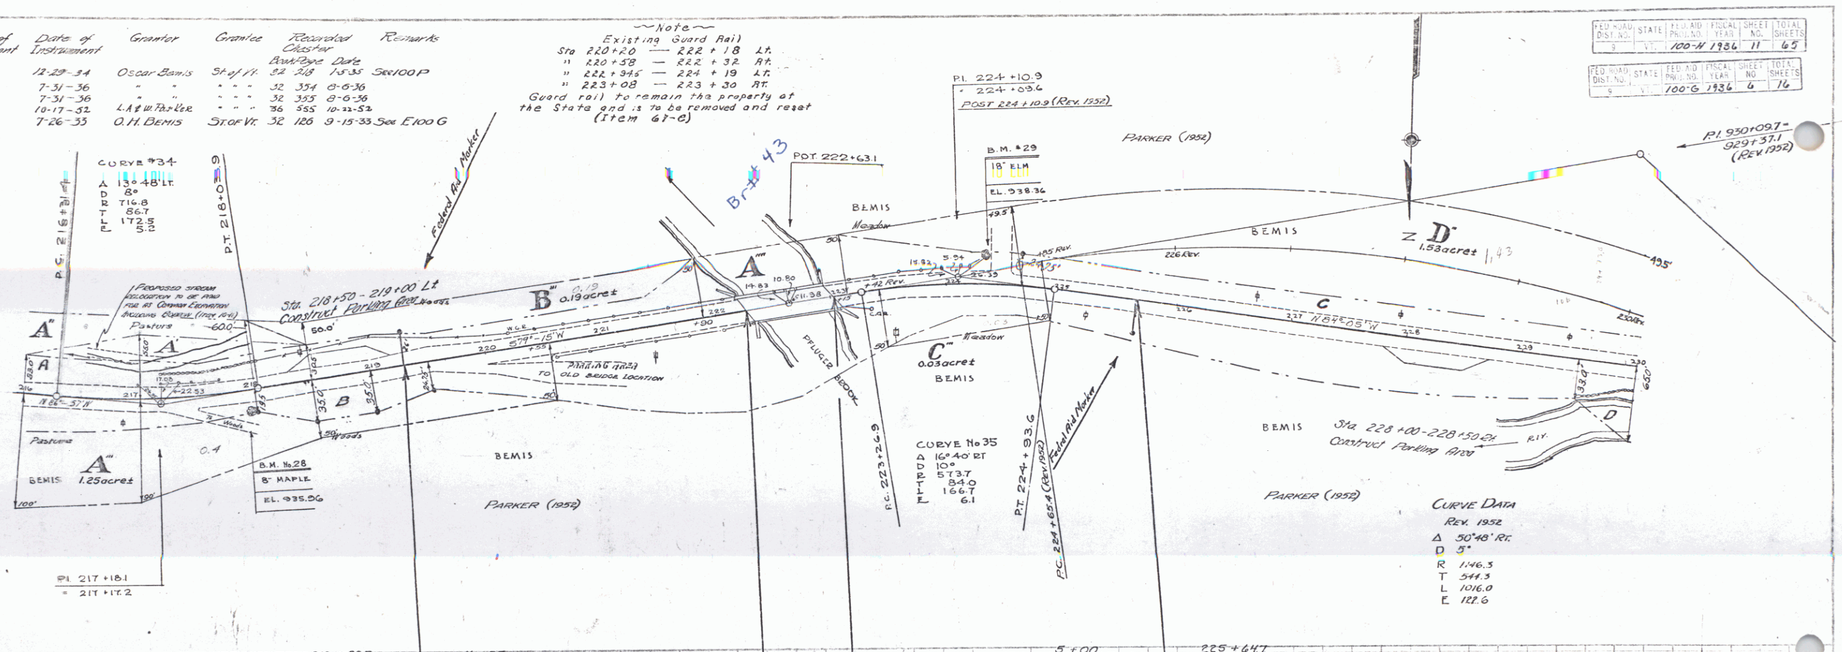

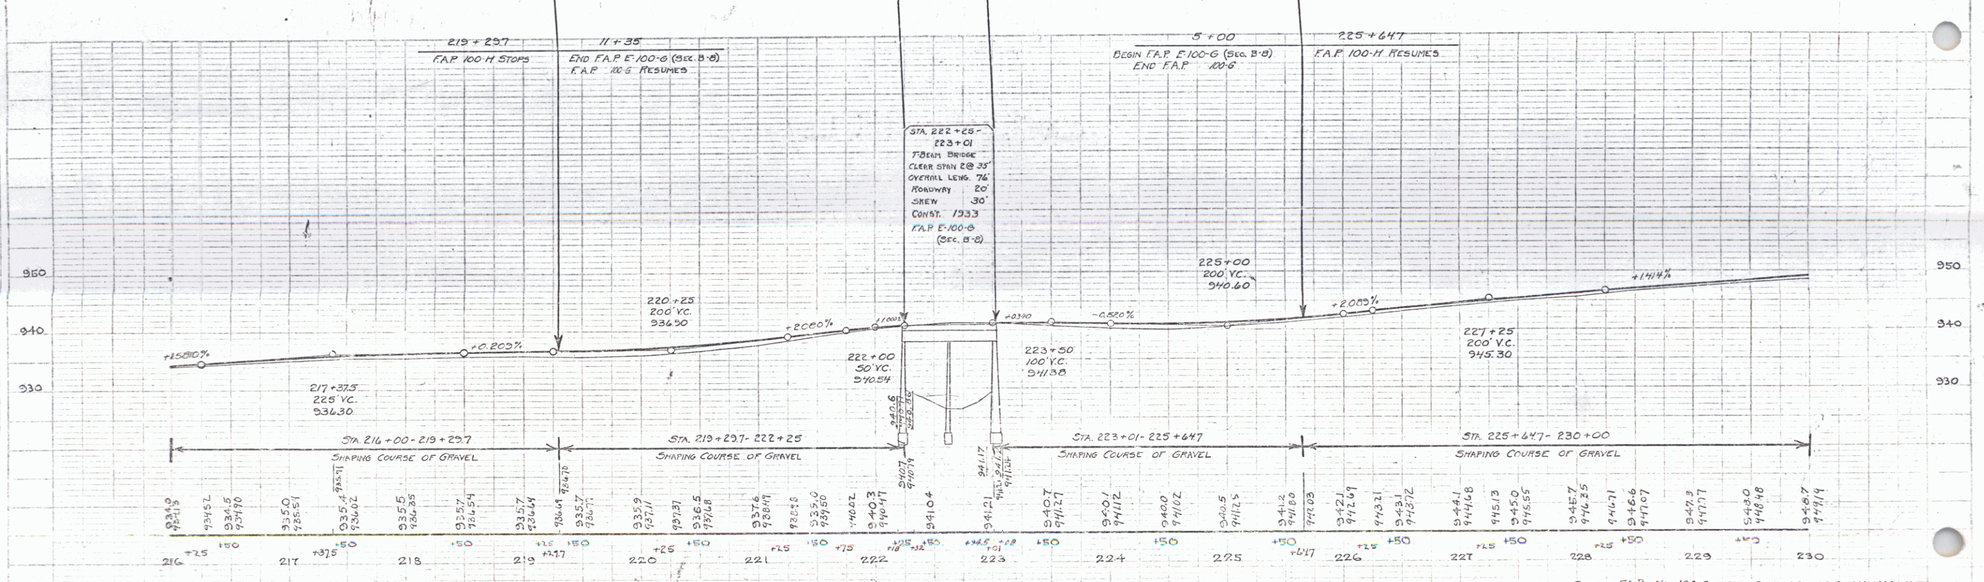

B.M. #28 3" FL. EL. 1.1 ROOT 5" MAPLE. RT. 15 FT. STA. 217+95 EL. 935.96
B.M. #29 " " " 18" ELM LT. 13 FT. STA. 224+32 EL. 938.36

SERIES F.A.P. No. 100-G SHEET 6 OF 16

SERIES F.A.P. No. 100-H SHEET 11 OF 65

9