FED. ROAD DIST. NO.	STATE	FED. AID PROJECT NO.	SHEET NO.	TOTAL SHEETS
		100-H 1936	16	65

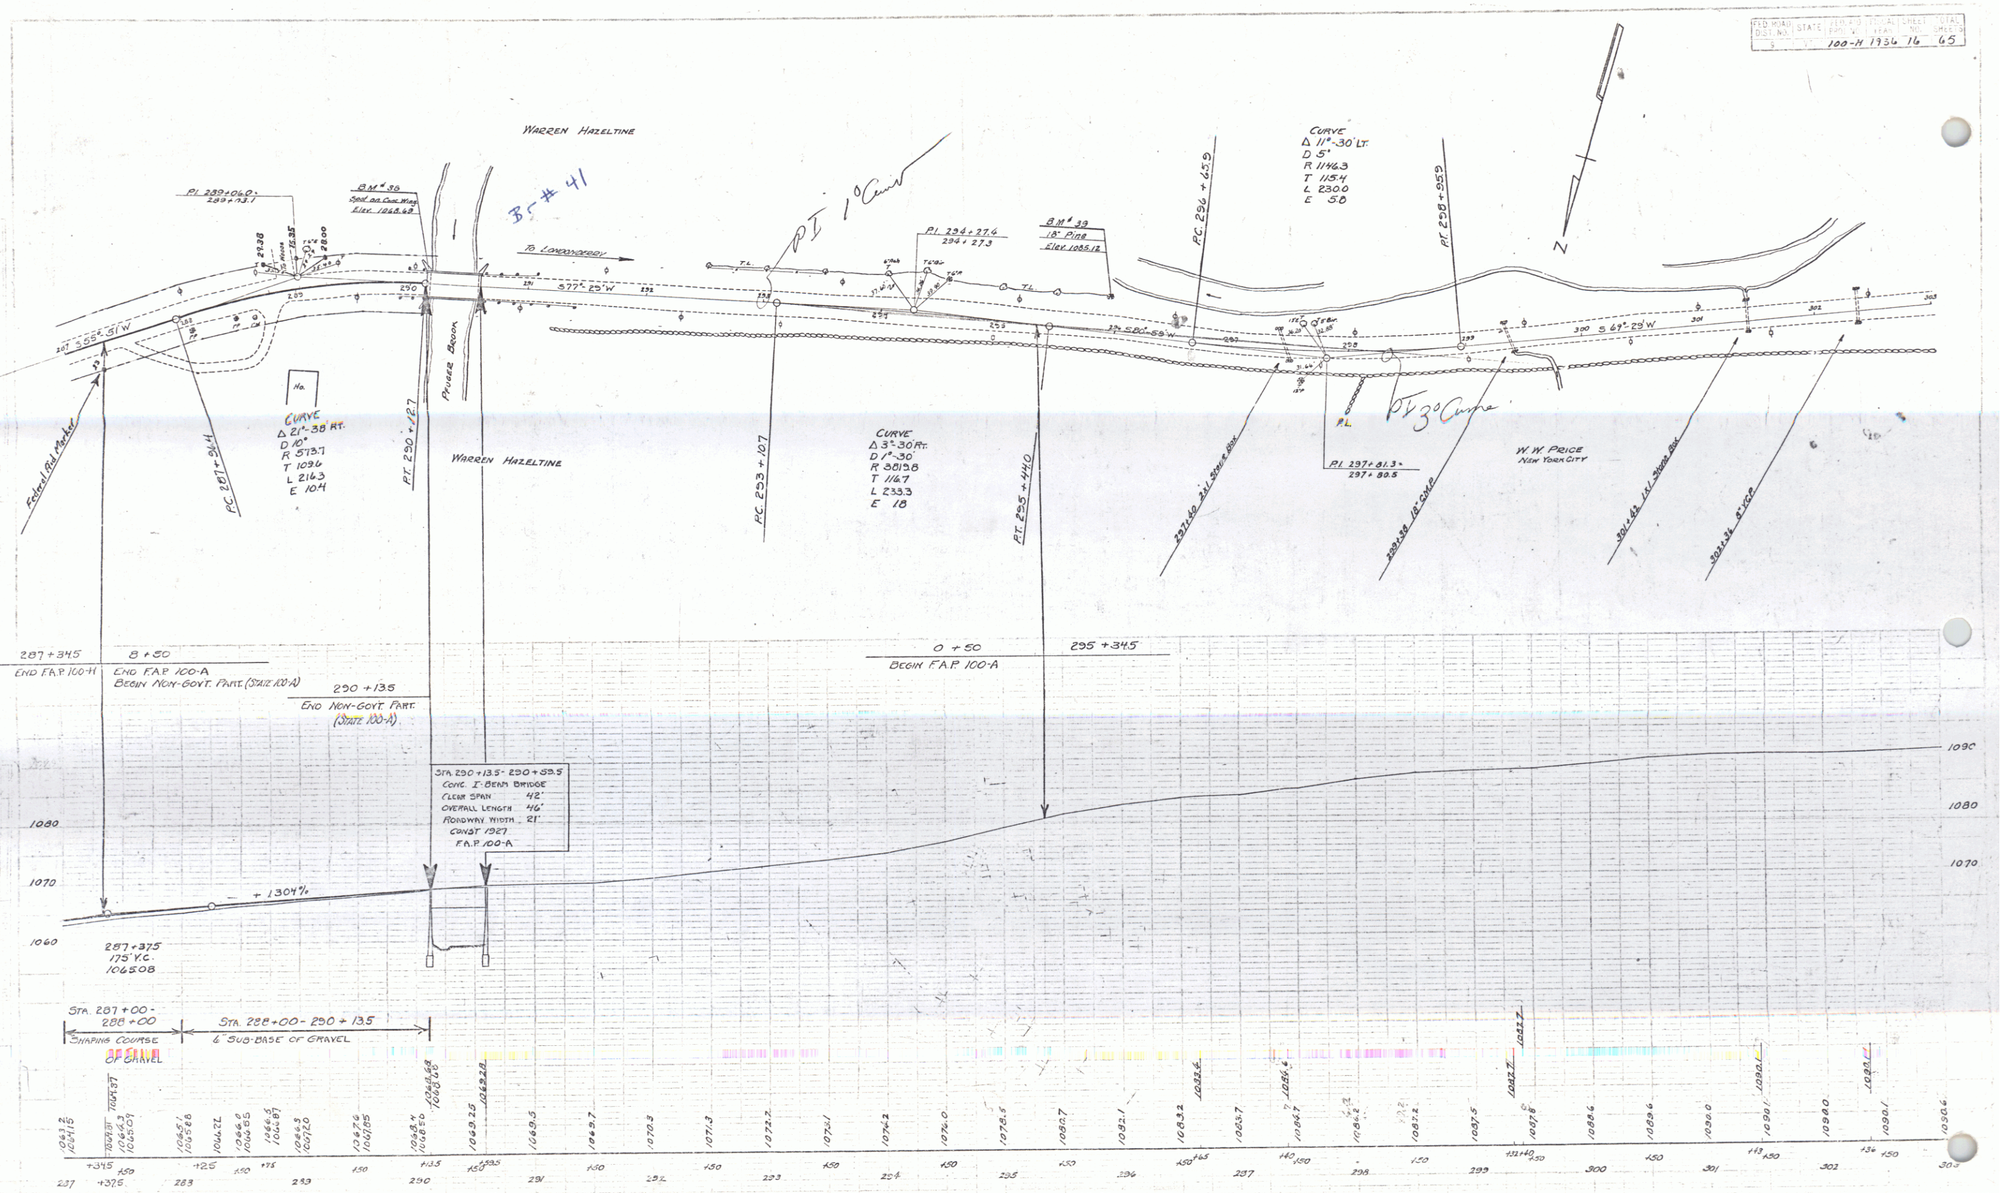

B.M. # 38 SPOT ON CONC. BRIDGE WING 12 FT. LT. OF STA. 290+14 ELEV. 1068.69 (U.S.B.M. 1069)
B.M. # 39 SPIKE IN ROOT OF 18" PINE 30 FT. LT. OF STA. 293+93 ELEV. 1085.12

SERIES F.A.P. No. 100-H
Sheet 16 OF 65

14