N.R.S.
1933 6 26

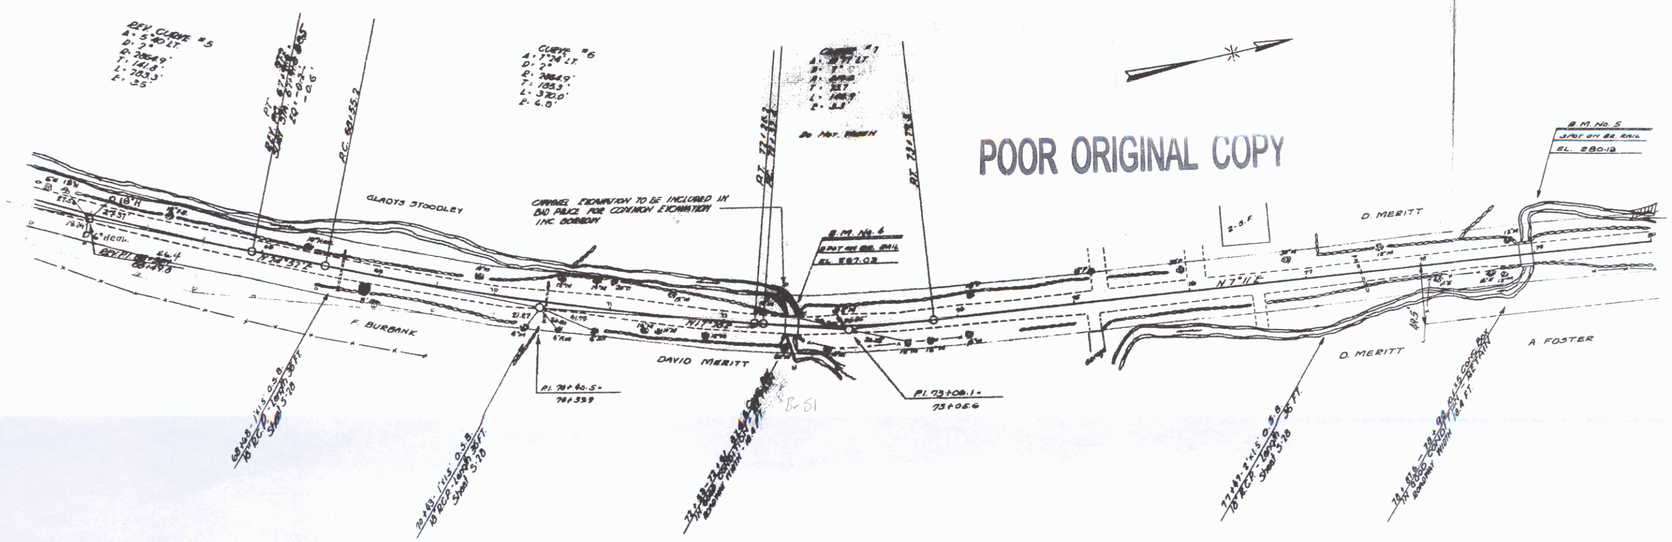

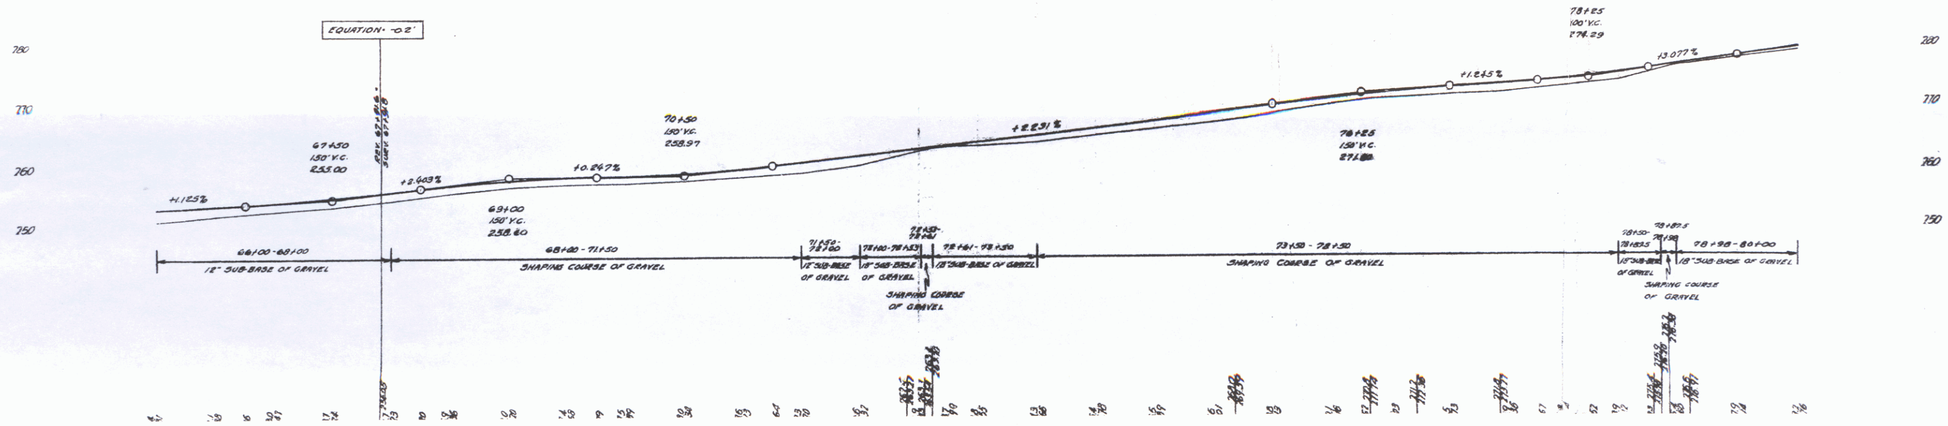

6