Seeding Item 611
Fertilizer Item 615
Top Soil Item 621

Cutting & Removing Trees
Item 110
3'19 Rt - Stump

Note: UTILITIES LEGEND
— w — water pipe
— s — sanitary sewer
Locations of sanitary sewer and water systems are approximate
Gradient of sanitary sewer is Approx. -0.5% westerly

Construct Drives
0+38 Lt 0+21 Lt
0+99 Lt
2+34 Lt
3+18 Lt
~~3+92 Rt~~
3+97 Lt
4+49 Lt
~~4+25 Rt~~
5+25 Lt

LEGEND
Remove Tree
Tree cut by the C.V. Power Corp.

Concrete Gravity Curb
Concrete Class B Item 401 B
0+72 - 0+92 Lt 4+61 - 5+50 Lt.
0+50 - 0+90 Lt
1+14 - 1+09 - 2+62 Lt
2+44 - 2+42 - 3+09 Lt
3+35 ~~3+33~~ 3+83 Lt
4+12 - 4+33 Lt
~~4+62~~ - 6+00 Lt
5+80 Garage Lt

Rev. Curve
Δ 1° 17' Lt
D 0° 30'
R 11,459.2
T 1283
L 2567
E 0.7
Do not bank

Rev. Curve
Δ 0° 42' Rt
D 0° 30'
R 11,459.2
T 100
L 1400
E 0.2
Do not Bank

40
0+80 - 3+65 Rt Item #589
Relocate Log Fence to ROW Line @ 2.4-2.6 ft. rt of ℄ of Existing roadway. (Removing & Resetting Fence, Item 589)

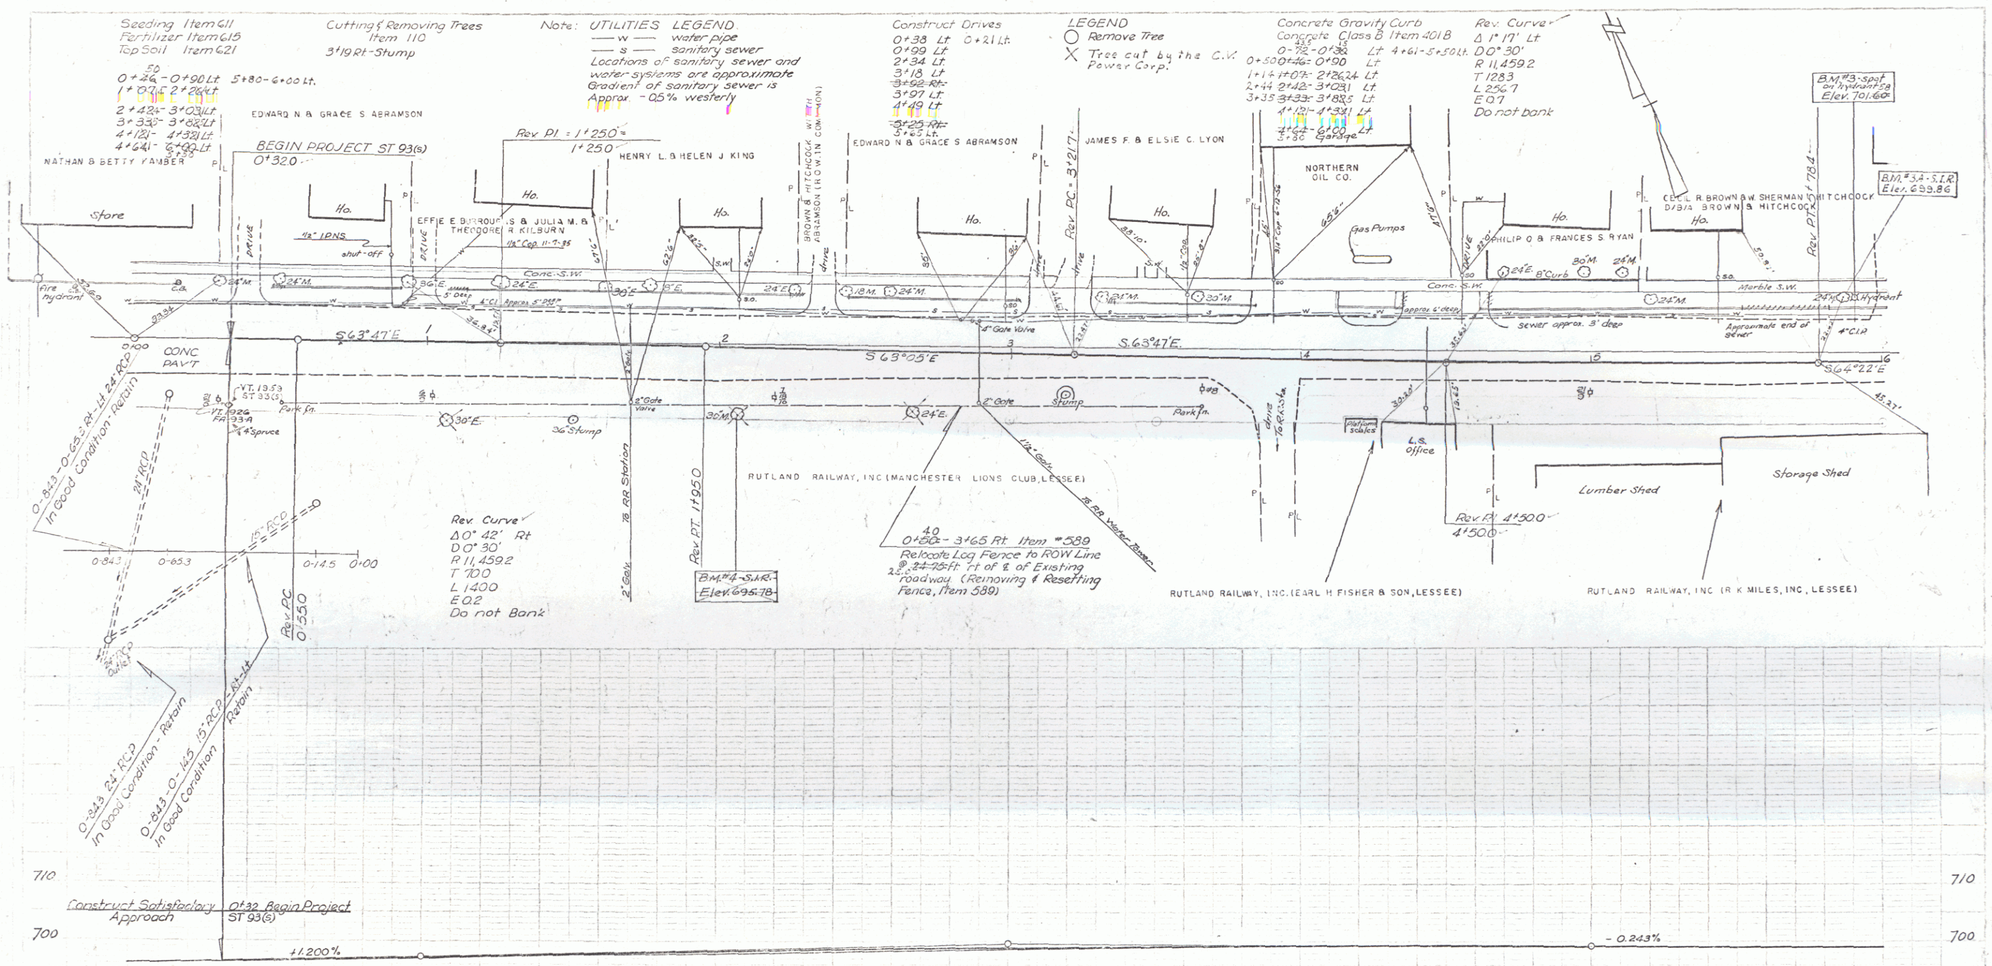

~~B.M. #4 - S.I.R. 30" M. - 24 Rt - Sta. 2+06.5 - Elevation 695.78~~

B.M. #3A - S.I.R. 24" M. - 19 Lt - Sta. 5+87 - Elevation 699+86
B.M. #3 spot on hydrant - 19 Lt - Sta. 5+00 - Elevation 701.60

MANCHESTER
Project No. ST 93(S)
Sheet No. 6 of 36

2