


A.S. Barnett  
 G.E. Allen  
 Tracer  
 MUM

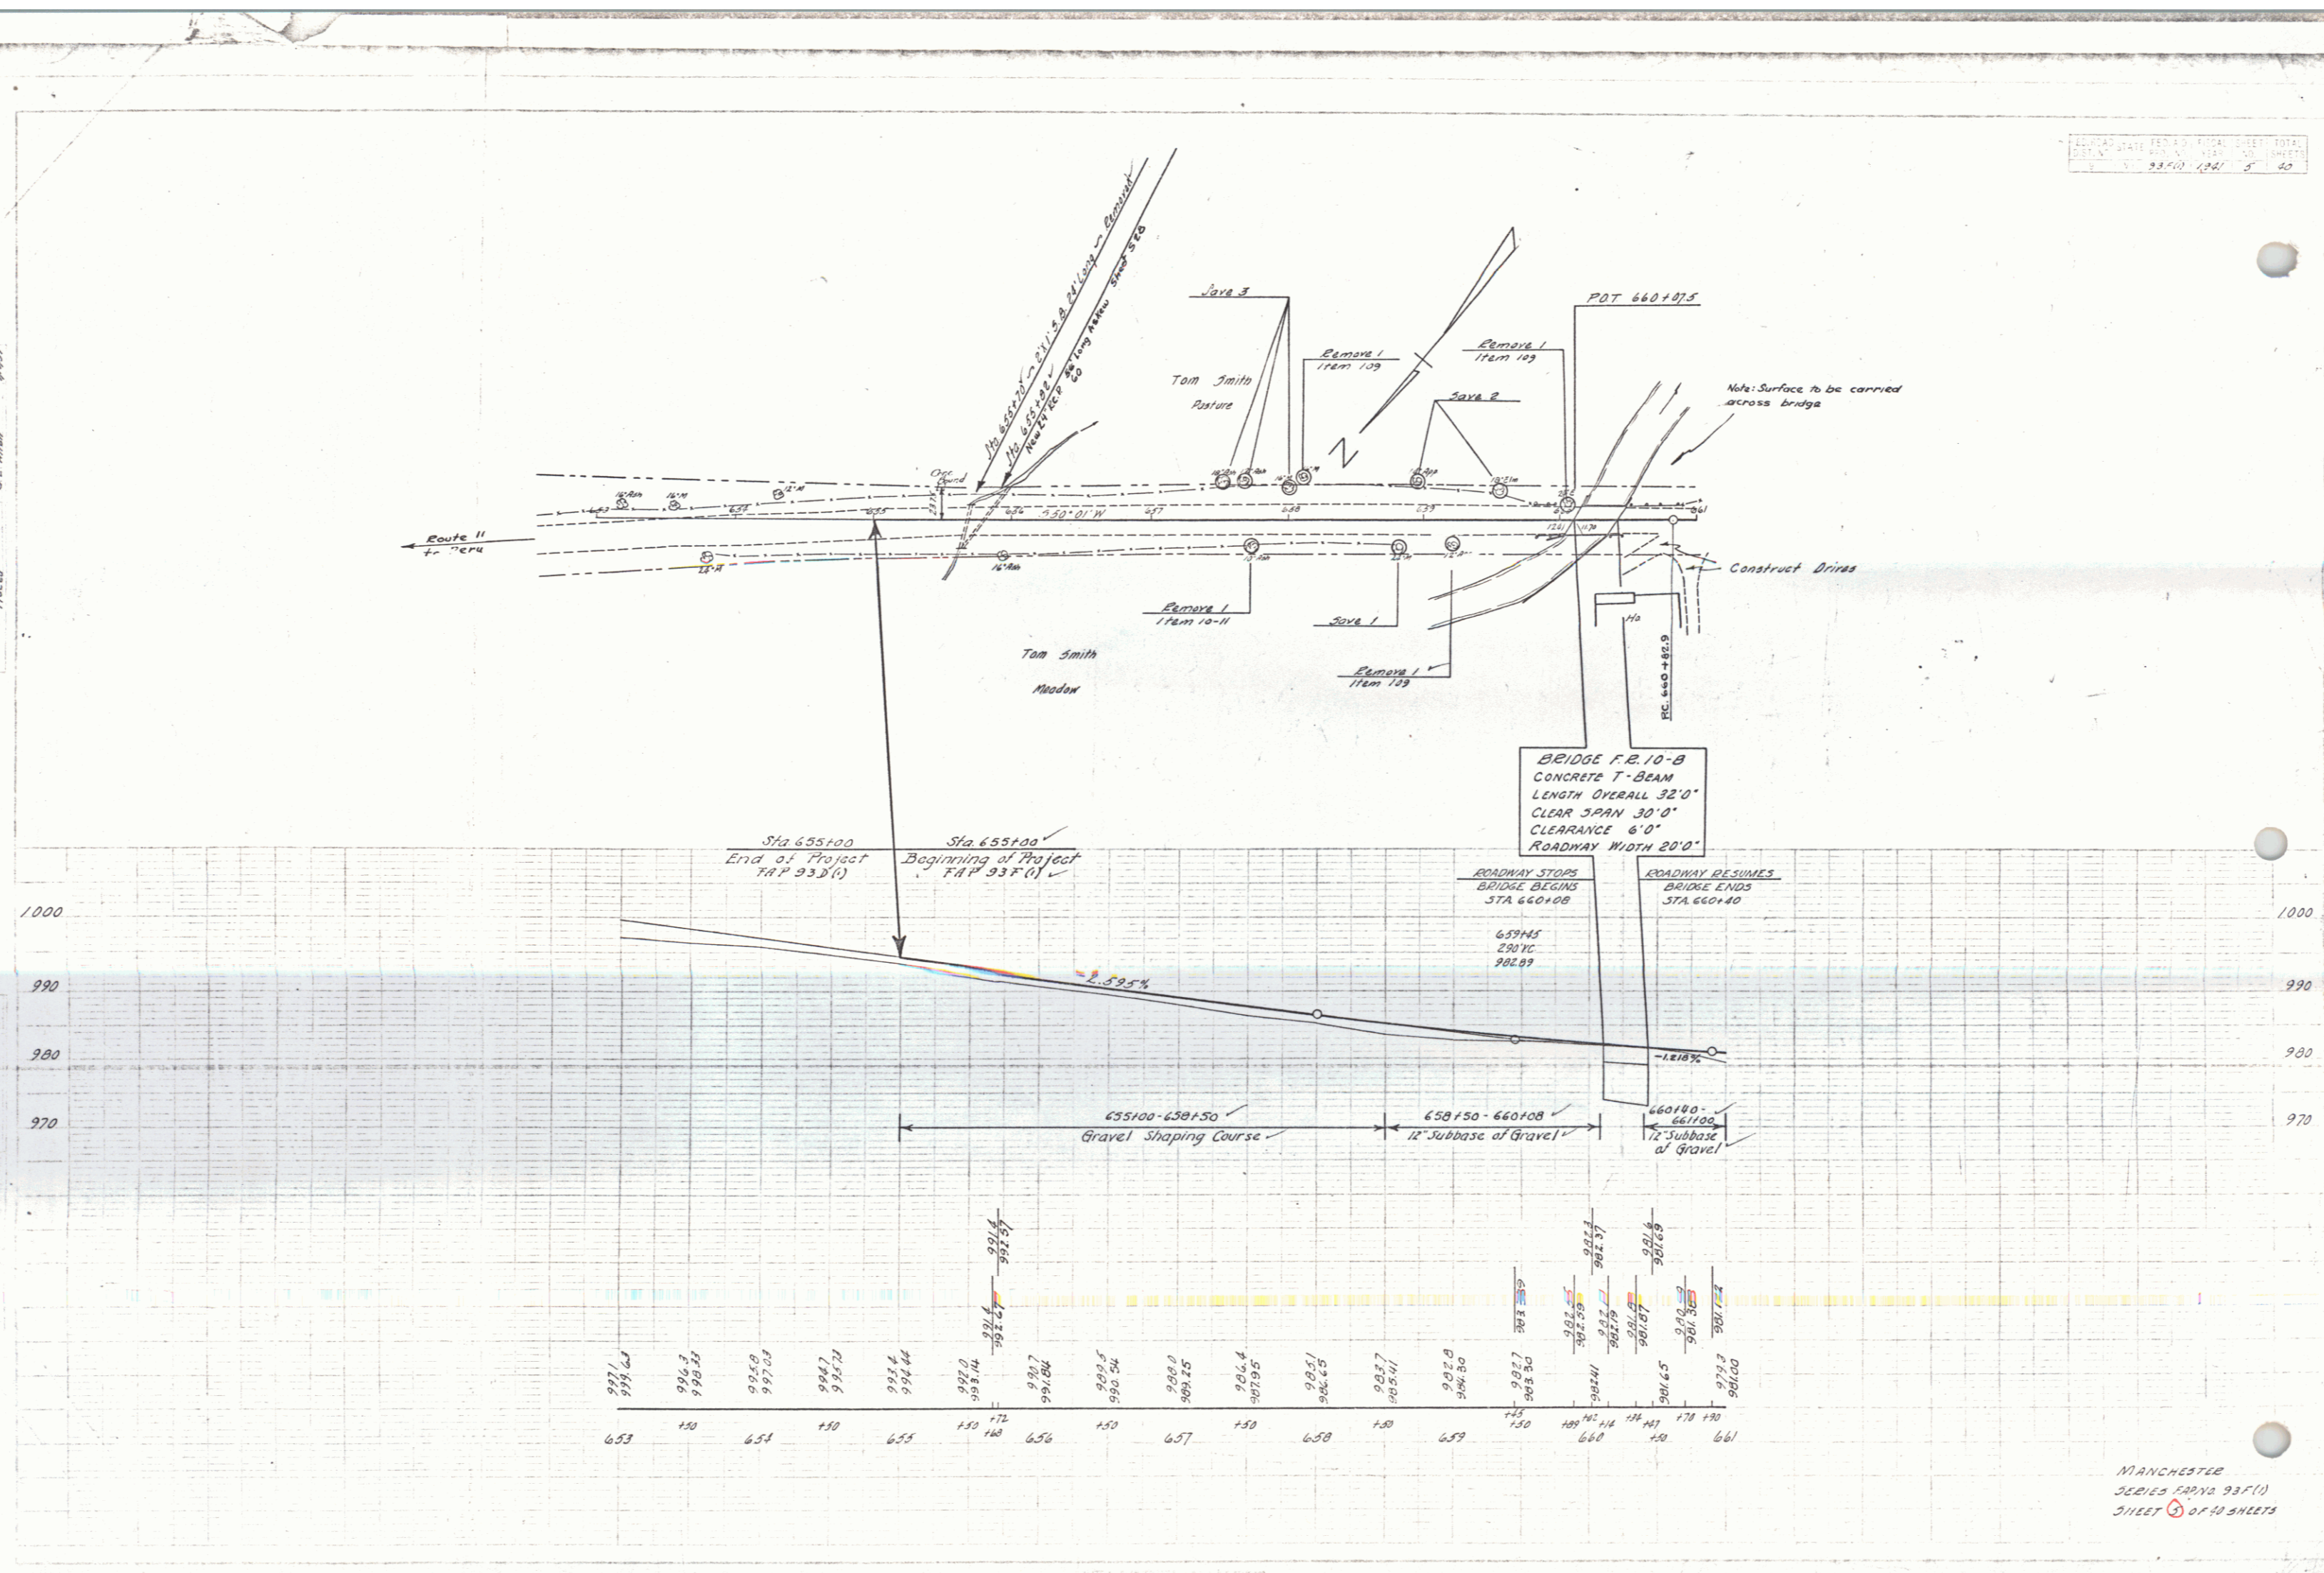

**BRIDGE F.R. 10-B**  
 CONCRETE T-BEAM  
 LENGTH OVERALL 32'-0"  
 CLEAR SPAN 30'-0"  
 CLEARANCE 6'-0"  
 ROADWAY WIDTH 20'-0"

ROADWAY STOPS  
 BRIDGE BEGINS  
 STA 660+08

659+5  
 20' VC  
 982.89

ROADWAY RESUMES  
 BRIDGE ENDS  
 STA 660+40

-1.218%

655+00 - 658+50  
 Gravel Shaping Course

658+50 - 660+08  
 12" Subbase of Gravel

660+08 - 661+00  
 12" Subbase of Gravel

653	654	655	656	657	658	659	660	661							