


PARCEL INSTRUMENT	DATE	GRANTOR	GRANTEE	RECORDED	REMARKS
F	Q.C.D.	9-16-39	CHARLES E TAYLOR	ST & VI 899K 13 85	DATE 9-21-39 1 C.M.

Forest Highway Project No. 2-A
 DIST. NO. STATE YEAR SHEET
 1940 8 27

POOR ORIGINAL COPY

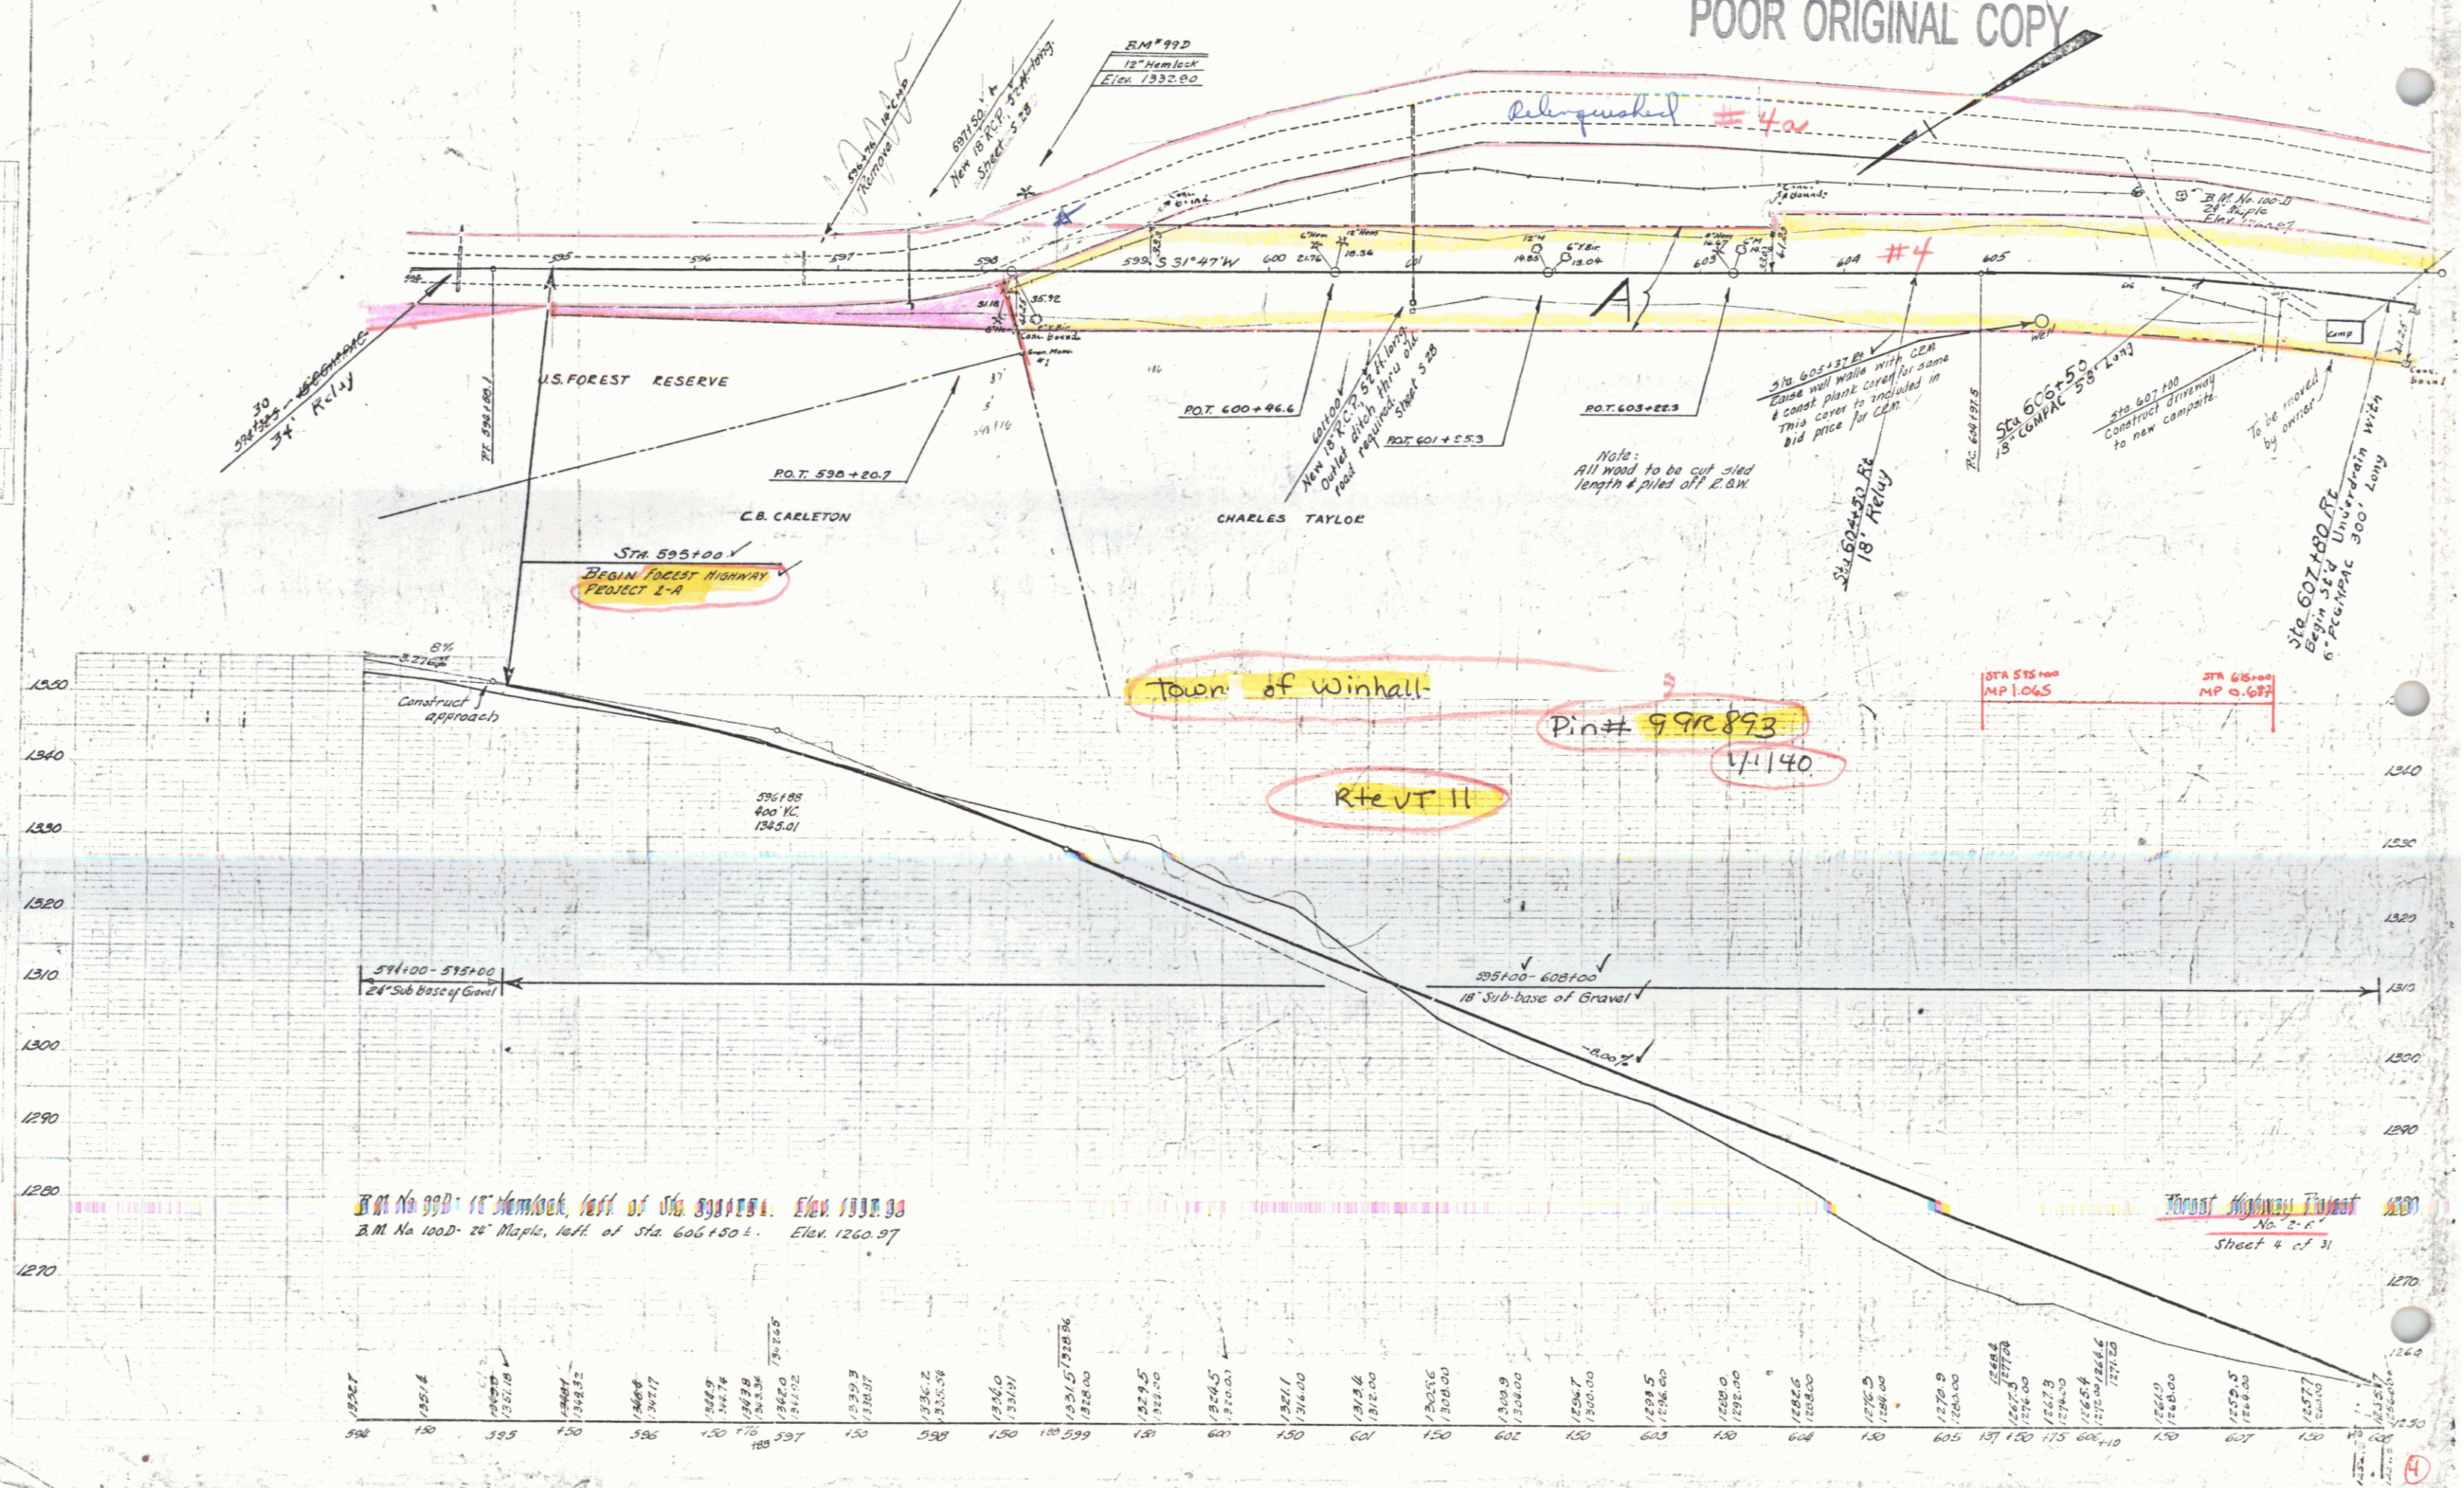

B.M. No 99D: 12" Hemlock, left of Sta 595+00. Elev. 1332.00
 B.M. No 100D: 24" Maple, left of Sta. 606+50. Elev. 1260.97

STEARNS R. JENKINS