POOR ORIGINAL COPY

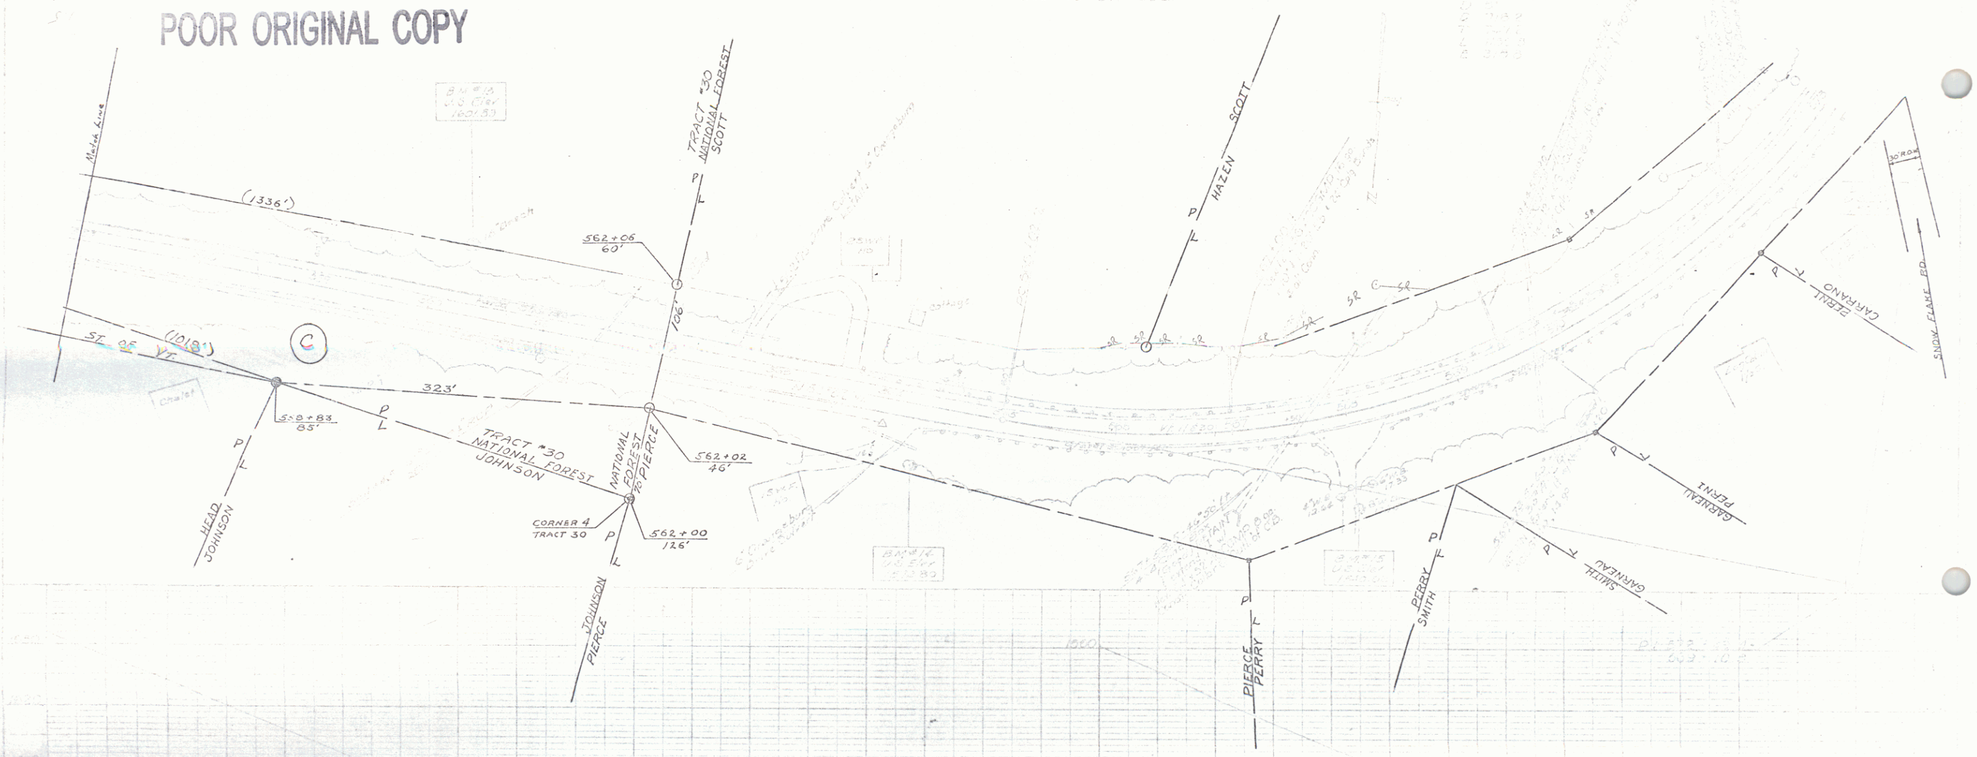

12

13