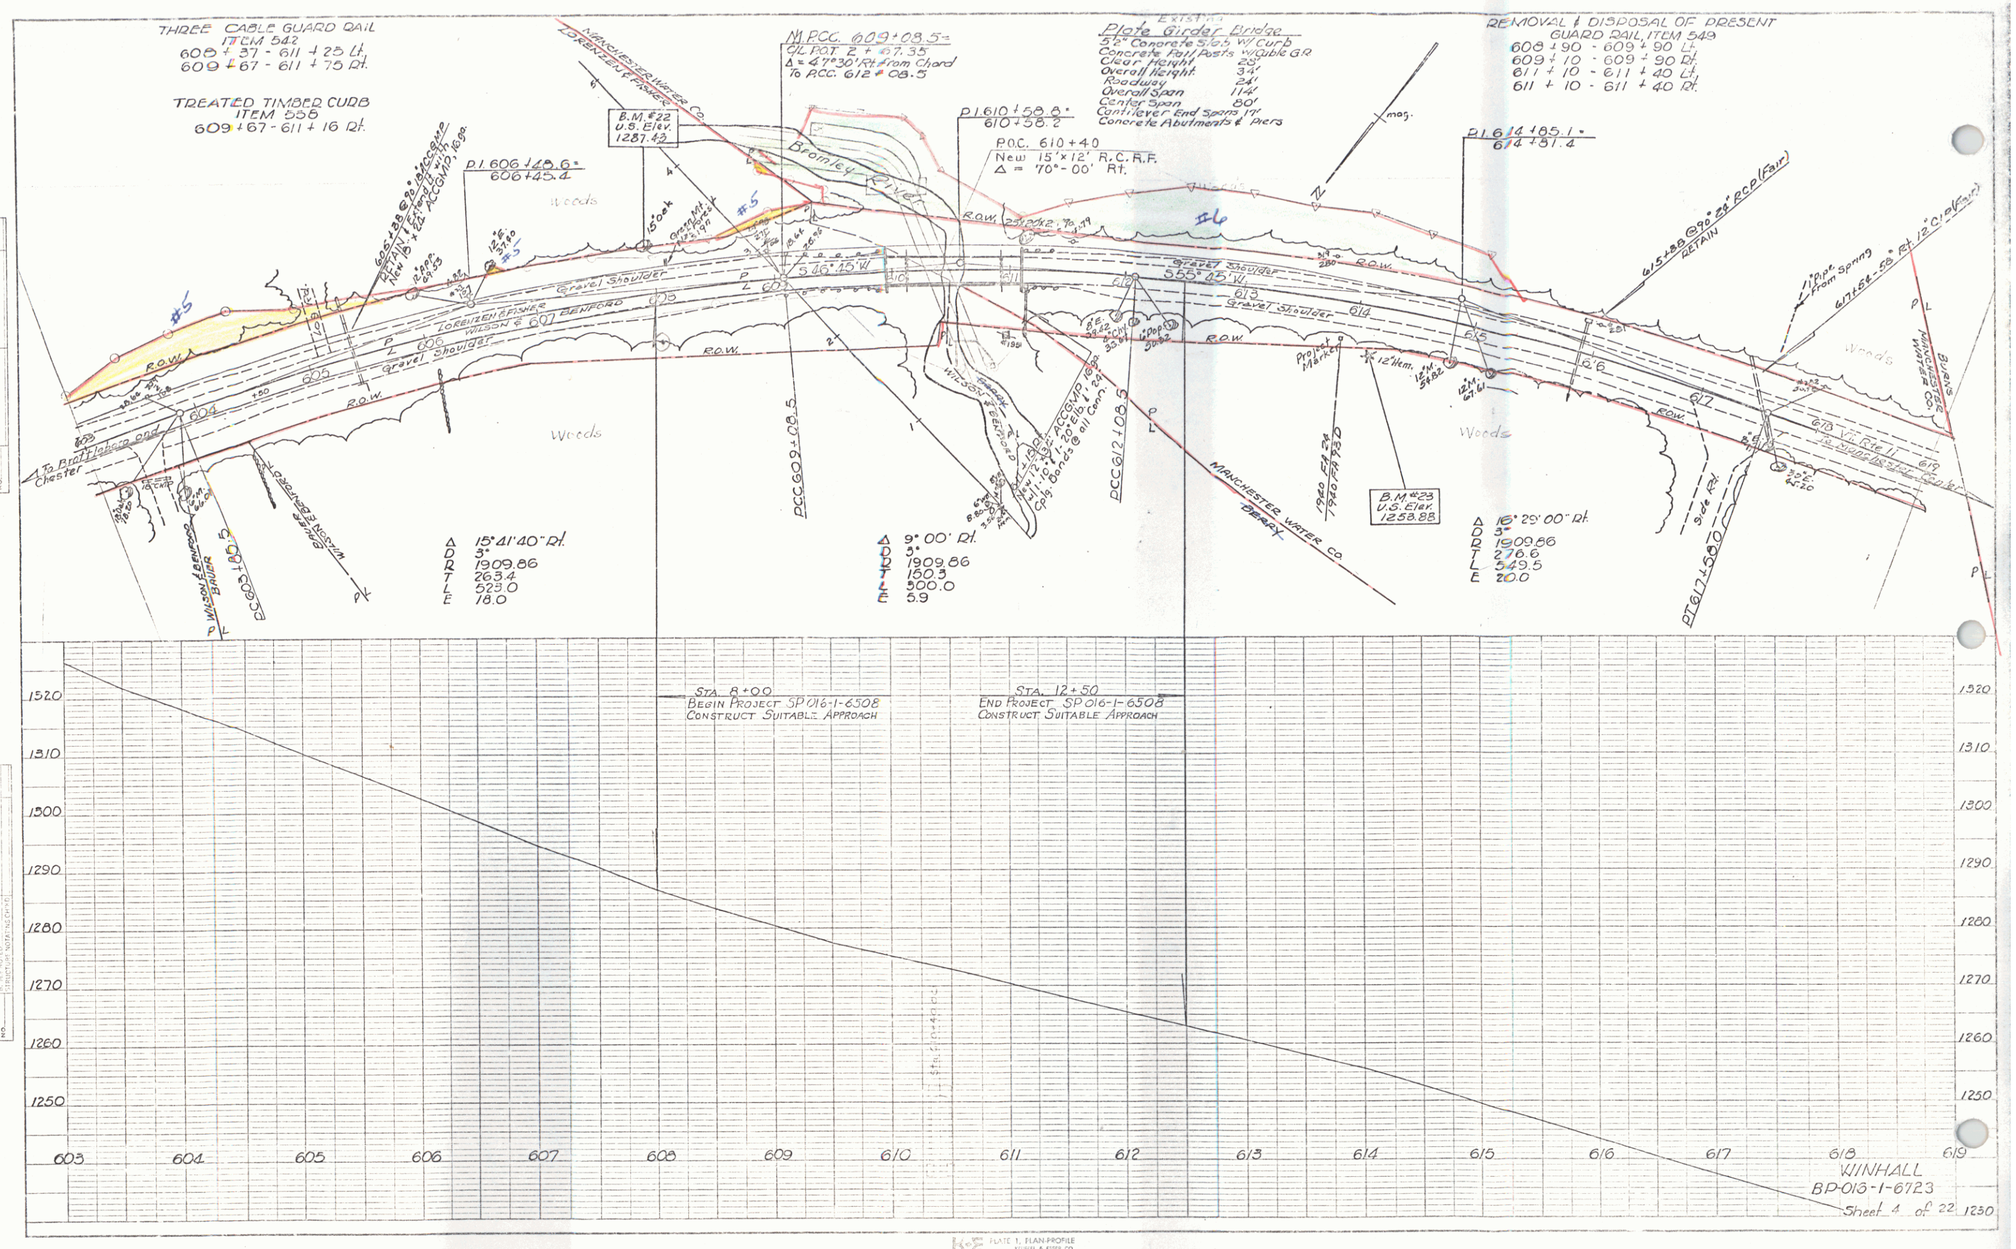

PLAN

PROFILE

PLATE 1, PLAN-PROFILE
KEUFFEL & ESSER CO.

18