PARCEL	INSTRUMENT	DATE	GRANTOR	GRANTEE	RECORDED WINHALL BOOK	PAGE	DATE	REMARKS
R. B. 16	DEED	12-1-45	BERTHA WALKER	ST. OF VT.	15	441-448	12-3-45	
R' B' 15	WDGE	12-11-45	BERTHA WALKER	ST. OF VT.	15	391-393	12-4-45	

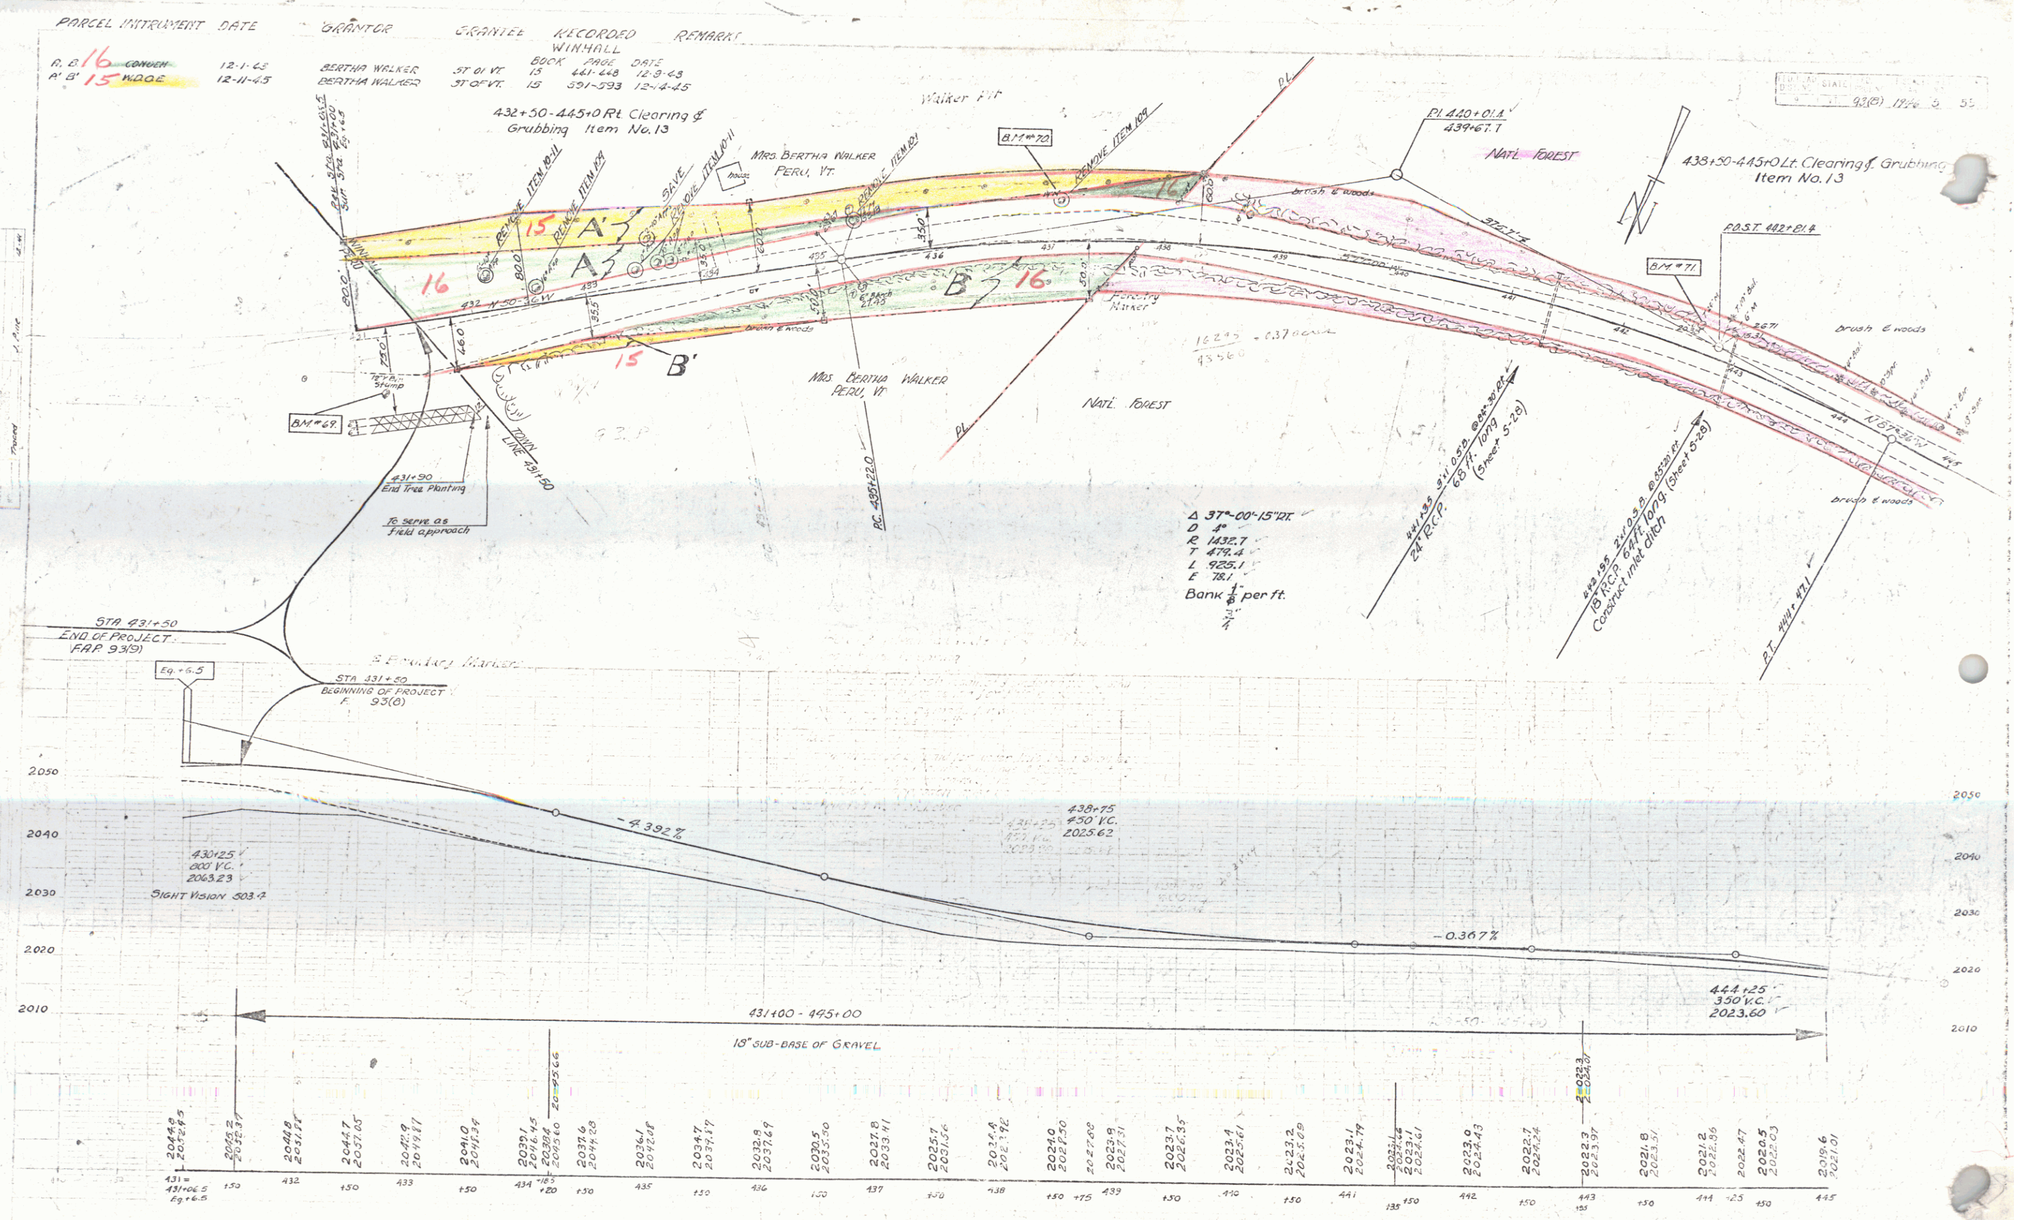

B.M. #69 S.I. Trunk 12" V. Brch 29' Rt. Sta. 431+14 Elev. 2050.84
B.M. #70. S.I.R. 14" Maple 22' Lt. Sta. 437+14 Elev. 2026.10
B.M. #71. S.I.F. 24" Maple 185' Lt. Sta. 443+84 Elev. 2023.39

Winhall F. 93-(8)
FAP 93(9)
Sheet 5 of 53