POOR ORIGINAL COPY

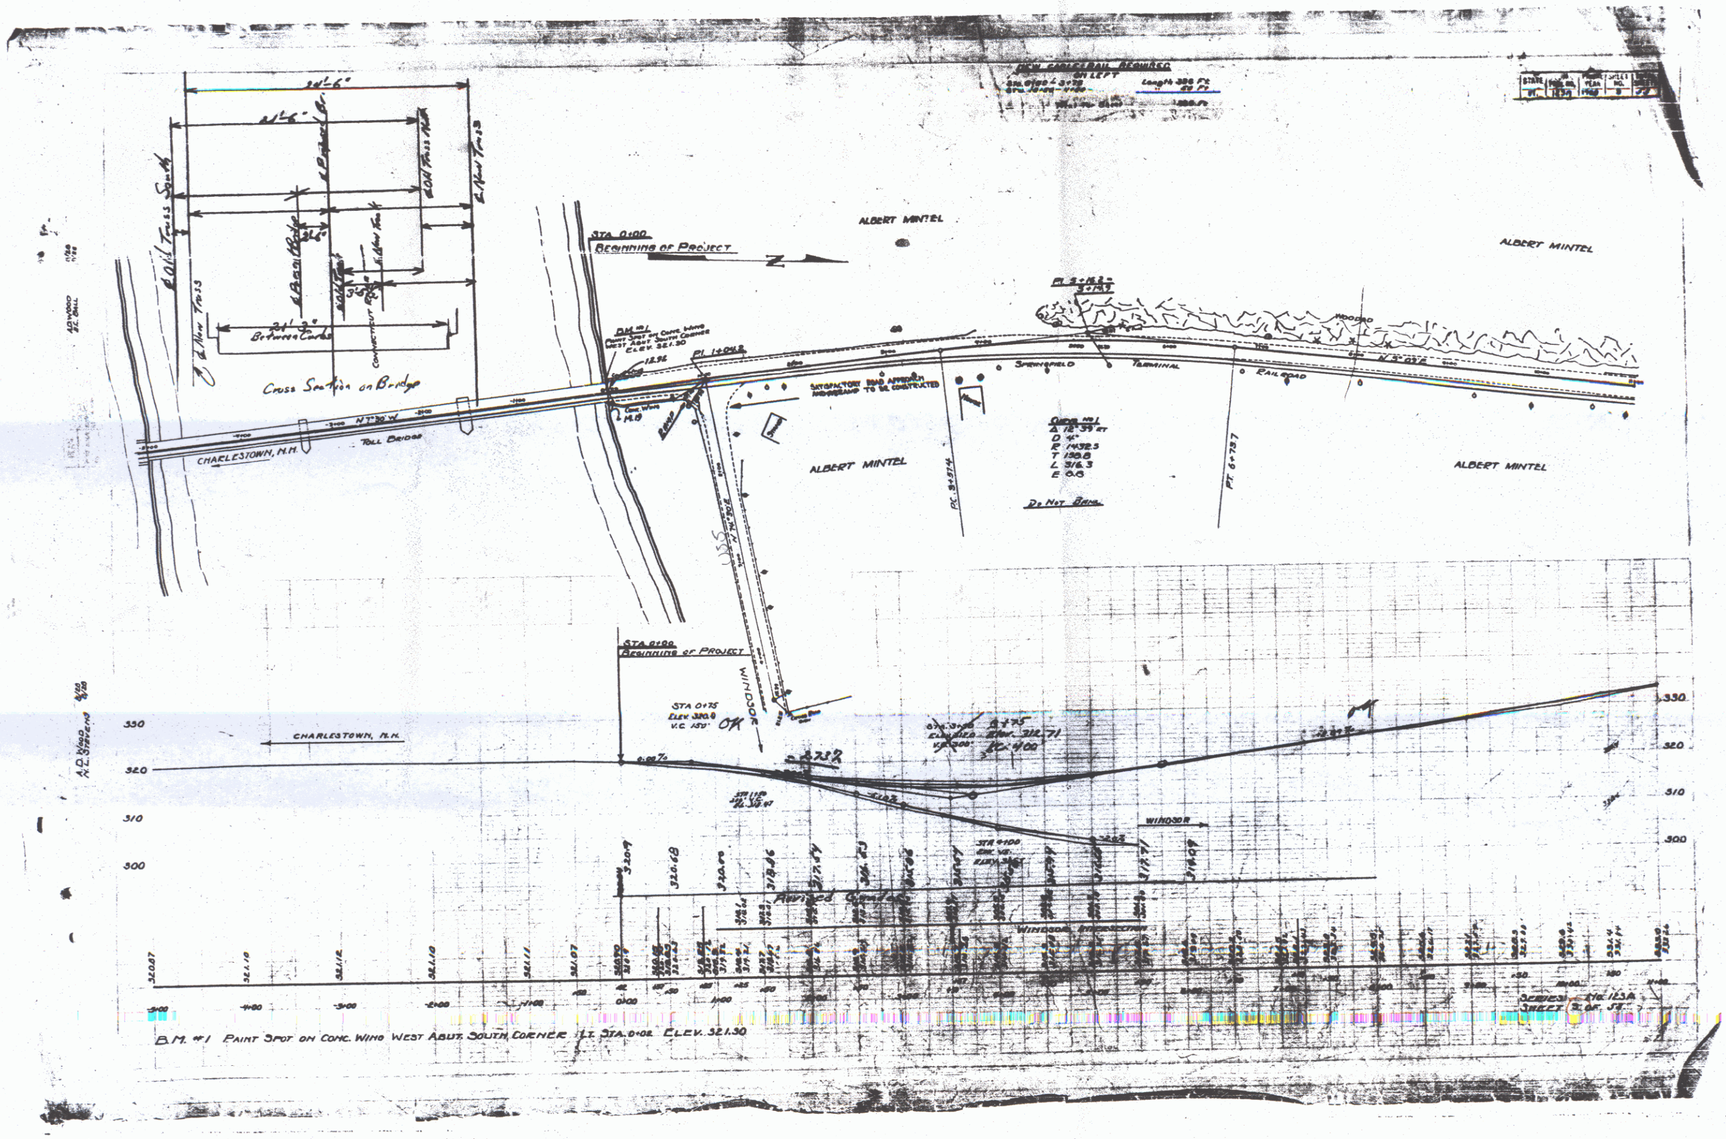


3