POOR ORIGINAL COPY

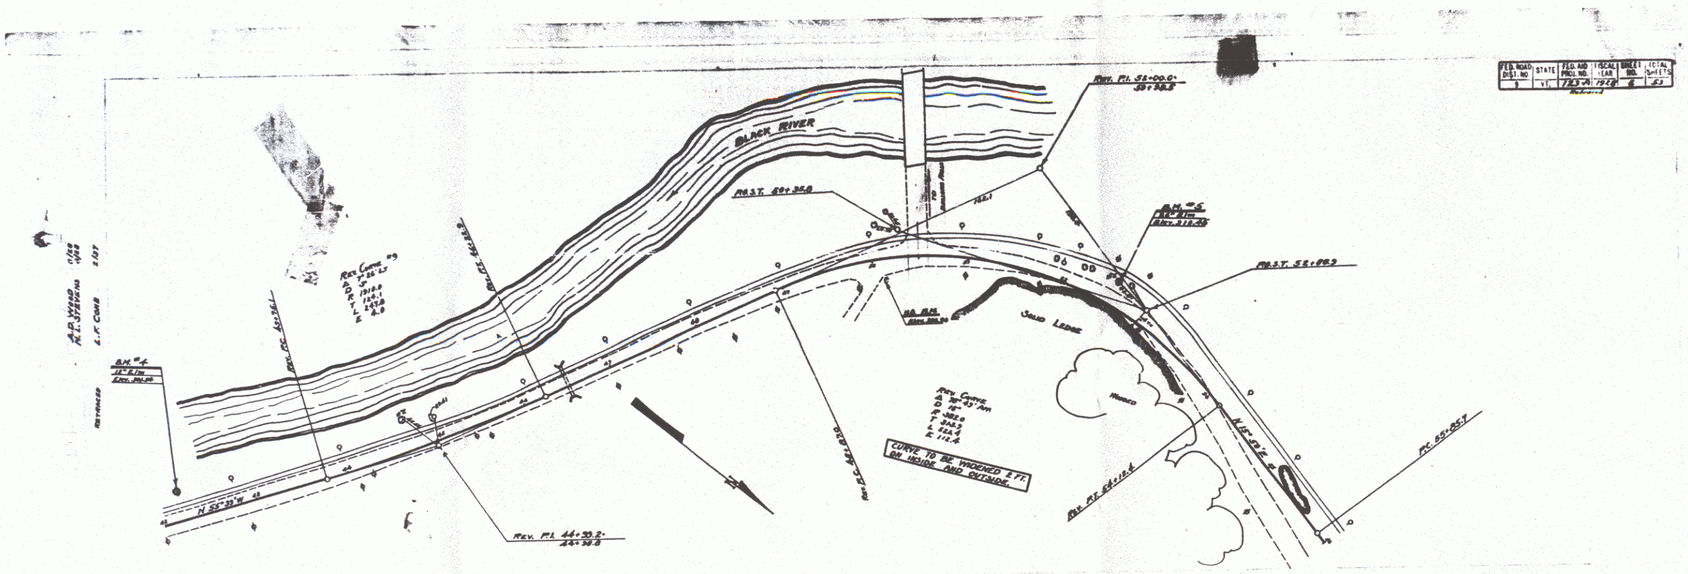

SERIES NO. 123-A
SHEET 6 OF 53

6