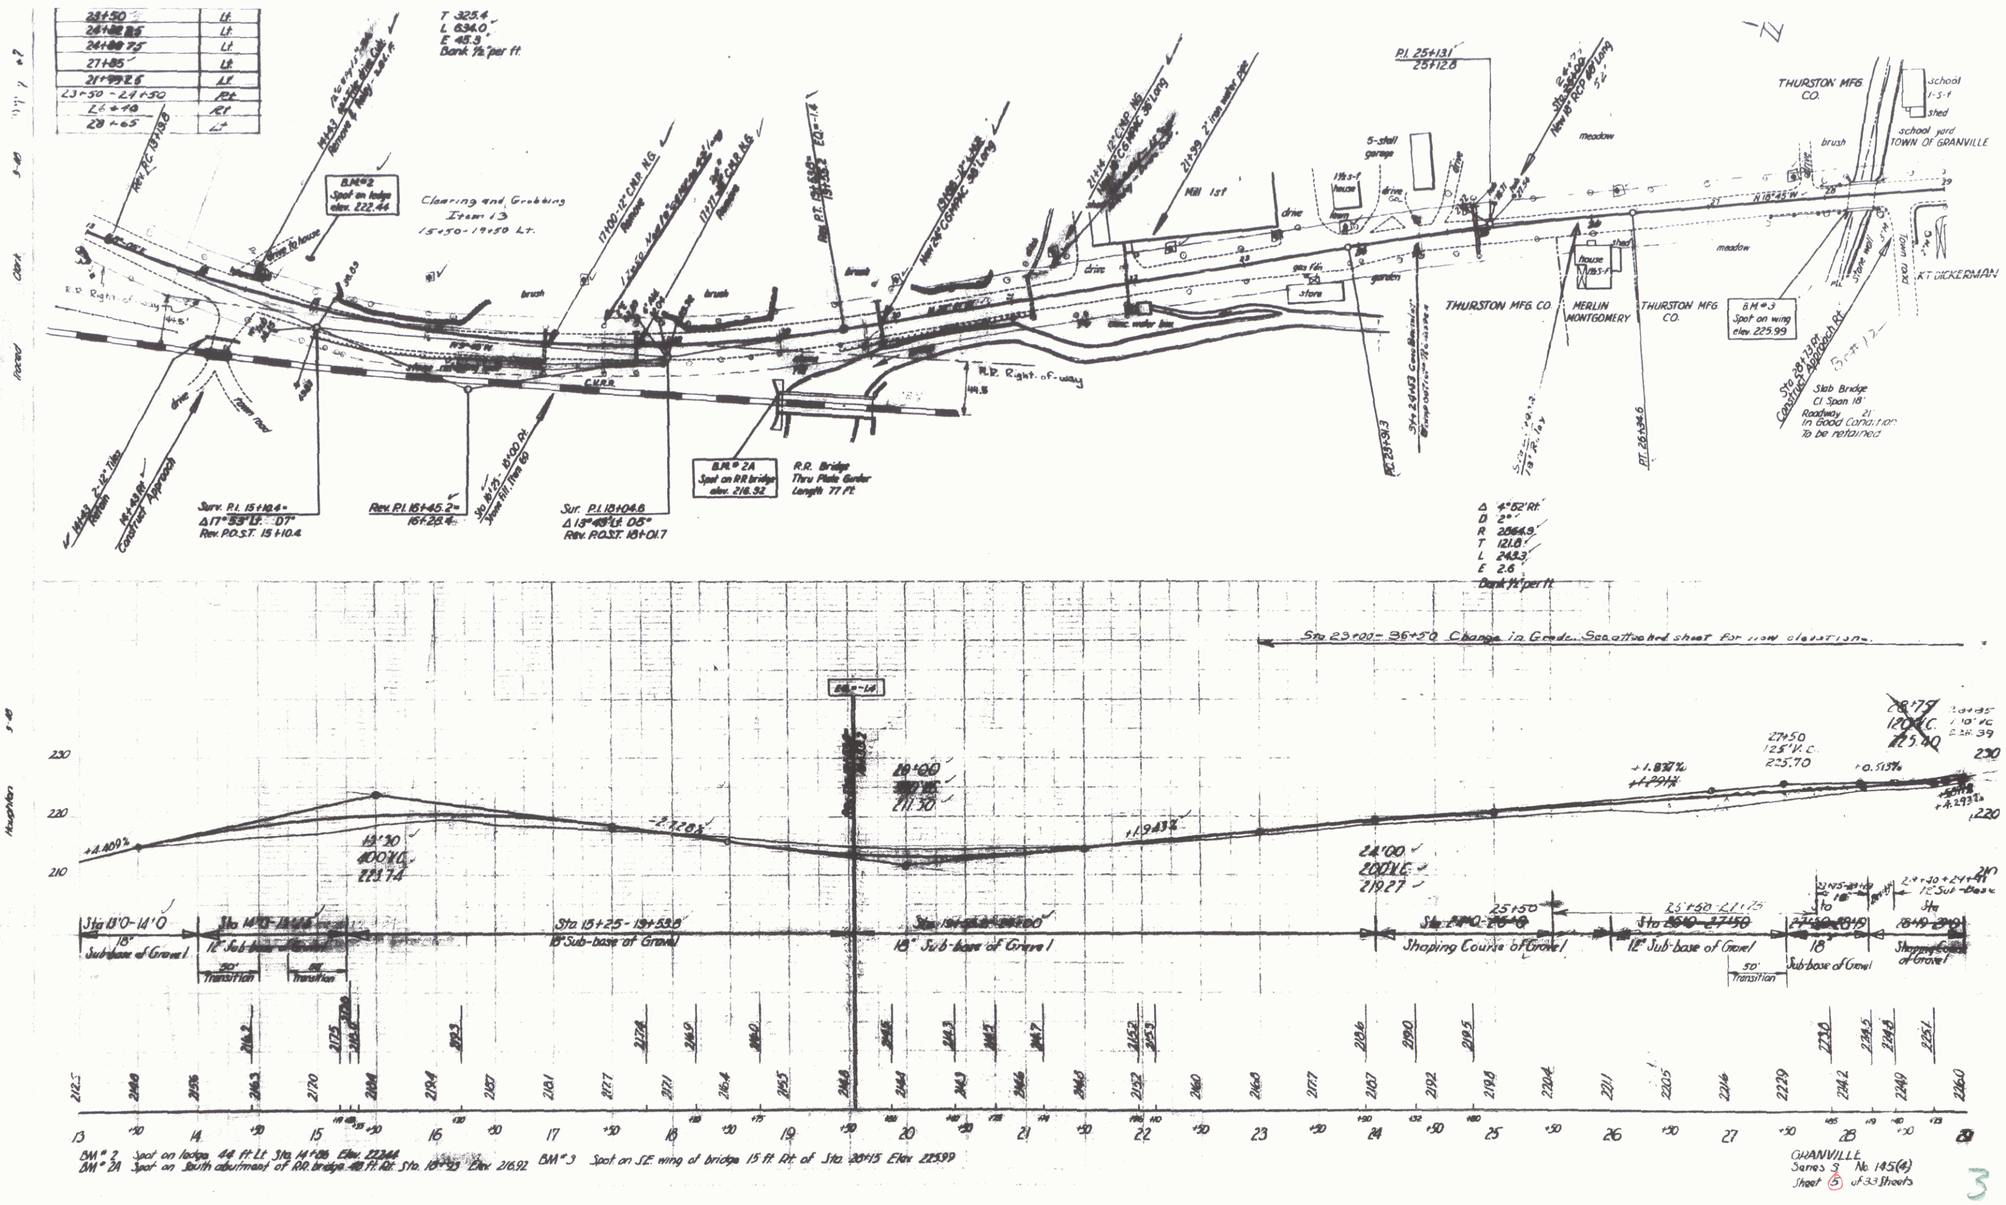
Clearing and Grubbing
Items 13
15+50 - 19+50 Lt.
T 325.4
L 634.0
E 45.9
Bank 1½ per ft.
B.M.#2
Spot on lodge
elev. 222.44
B.M.#2A
Spot on RR bridge
elev. 216.92
R.R. Bridge
Thru Plate Girder
Length 77 ft.
Surv. P.I. 15+10.4
Δ 17°53' Lt. D7°
Rev. P.O.S.T. 15+10.4
Rev. P.I. 16+45.2
16+28.4
Sur. P.I. 18+04.6
Δ 13°49' Lt. D8°
Rev. P.O.S.T. 18+01.7
R.R. Right-of-way
Hill 1st
P.I. 25+13.1
25+12.8
5-stall garage
meadow
THURSTON MFG CO.
MERLIN MONTGOMERY
THURSTON MFG CO.
school
1-S-1
shed
school yard
TOWN OF GRANVILLE
B.M.#3
Spot on wing
elev. 225.99
Slab Bridge
Cl Span 18'
Roadway 21'
In Good Condition
To be retained
Δ 4°52' Rt.
D 2°
R 2864.9
T 121.8
L 243.3
E 2.6
Bank ½" per ft.
Sta 23+00 - 36+50 Change in Grade. See attached sheet for new elevations.
Sta 13'0 - 14'0
18" Subbase of Gravel
Sta 15+25 - 19+53.8
18" Sub-base of Gravel
18" Sub-base of Gravel
Shaping Course of Gravel
12" Sub-base of Gravel
Sub-base of Gravel
Shaping Course of Gravel
BM#2 Spot on lodge 44 ft. Lt. Sta. 14+06 Elev. 222.44
BM#2A Spot on South abutment of RR bridge 48 ft. Rt. Sta. 18+23 Elev. 216.92
BM#3 Spot on S.E. wing of bridge 15 ft. Rt. of Sta. 20+15 Elev. 225.99
GRANVILLE
Series 3 No. 145(4)
Sheet 5 of 33 Sheets