F.E.D. ROAD DIST. NO.	STATE	S PROJ. NO.	FISCAL YEAR	SHEET NO.	TOTAL SHEETS
9	VT.	1204	1947	10	33

TREES
○ = Remove, Item 109

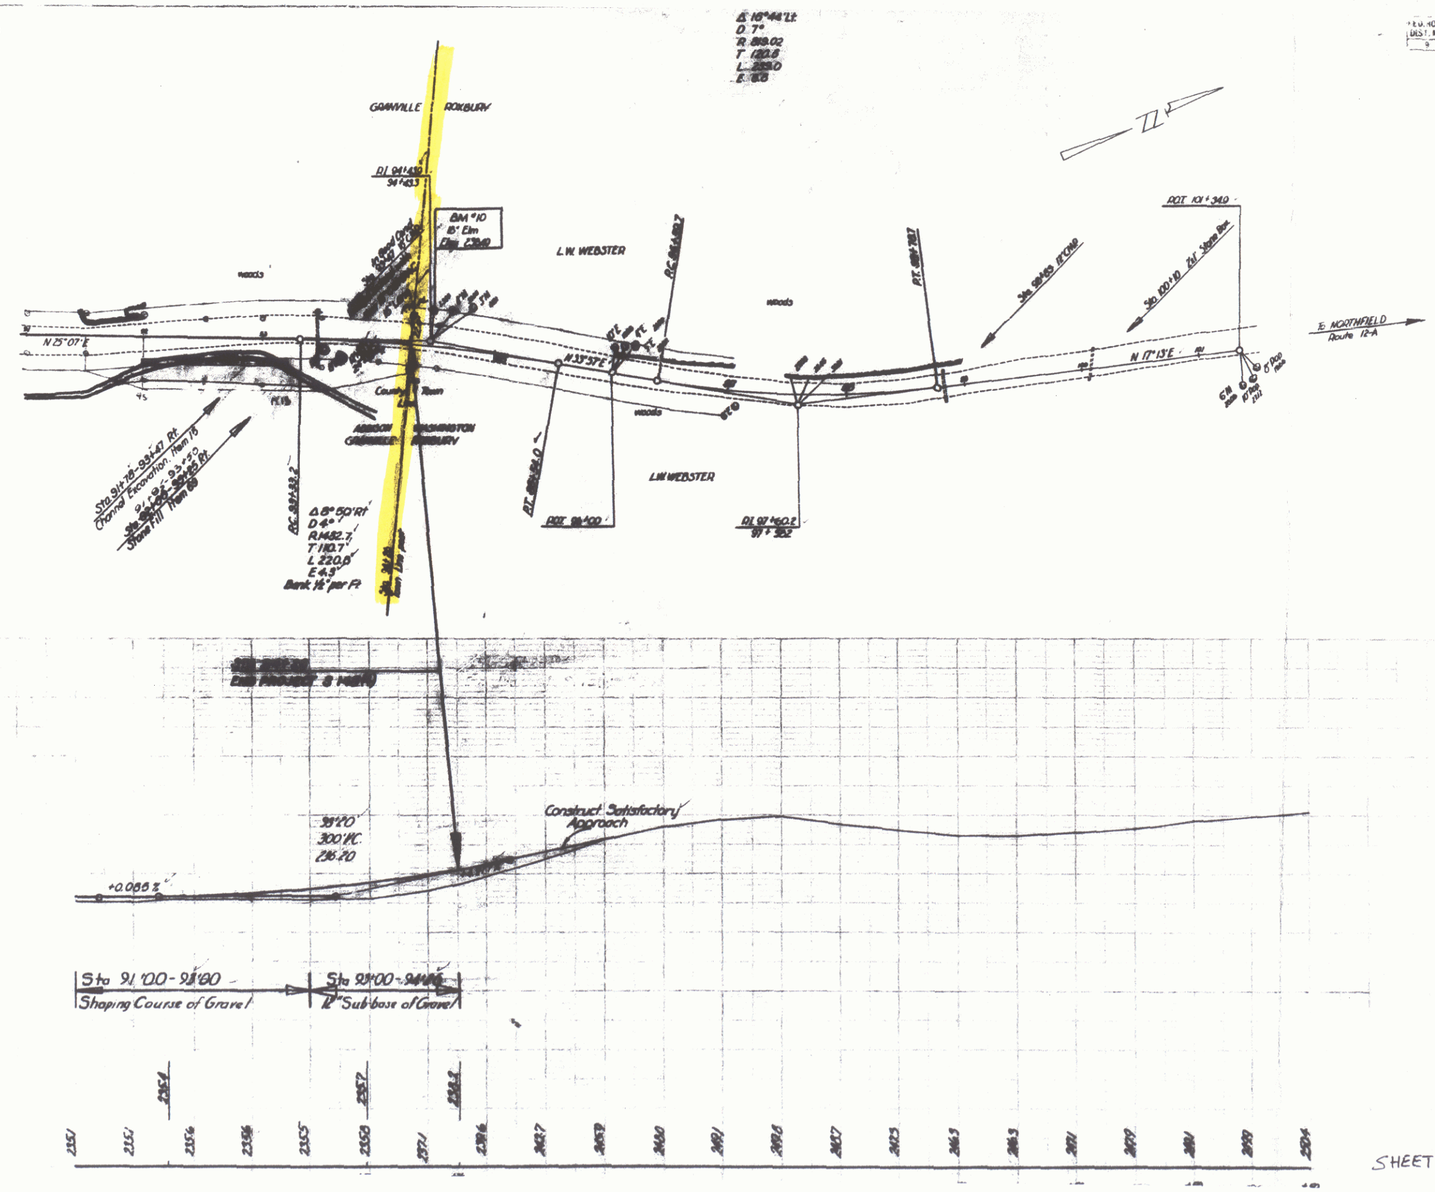

SHEET 10

8