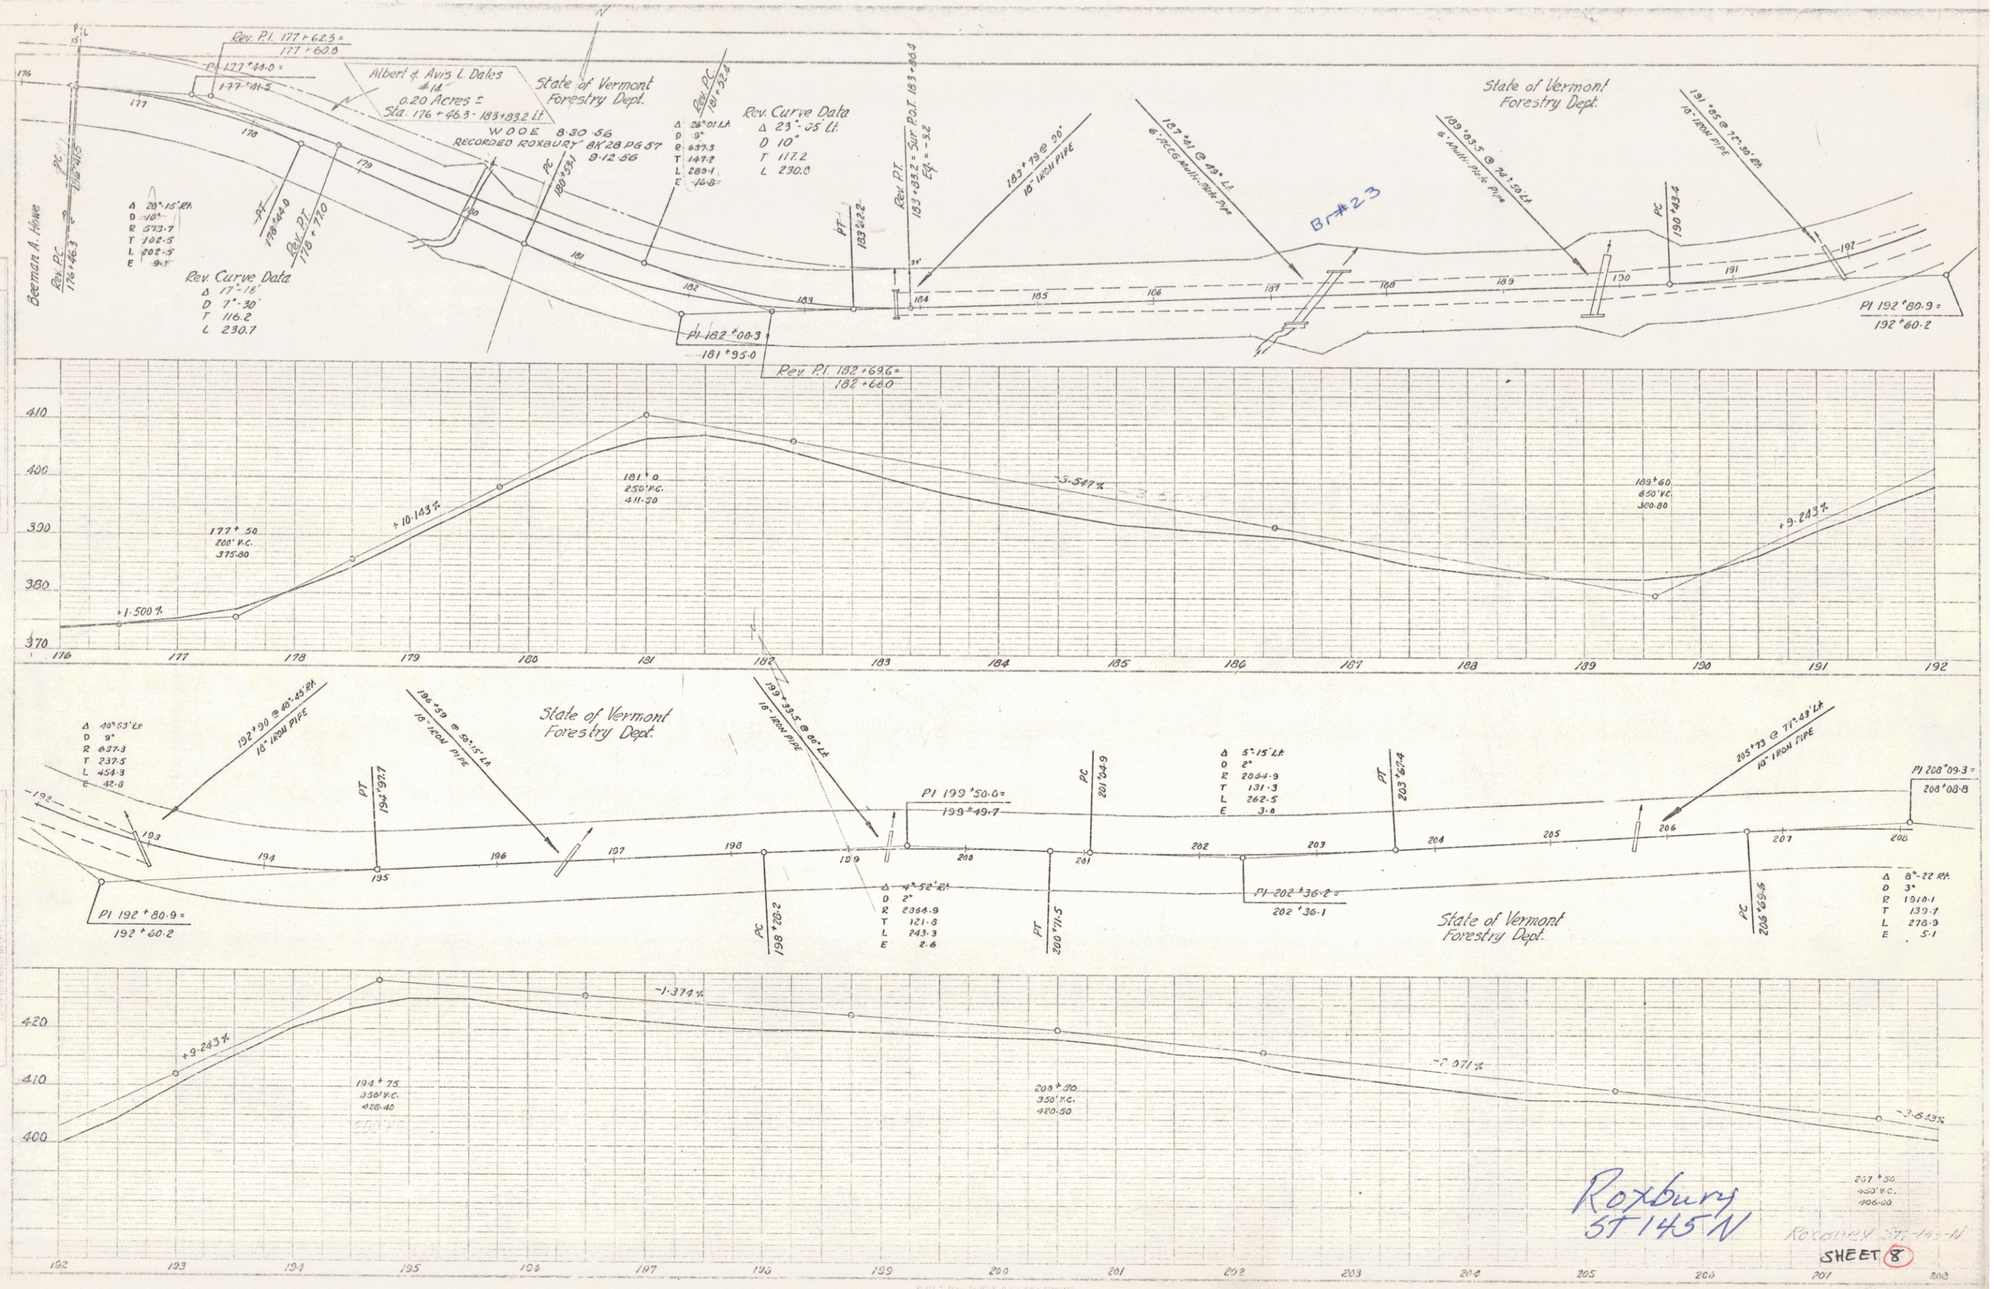

Roxbury ST 145 N

SHEET 8

8