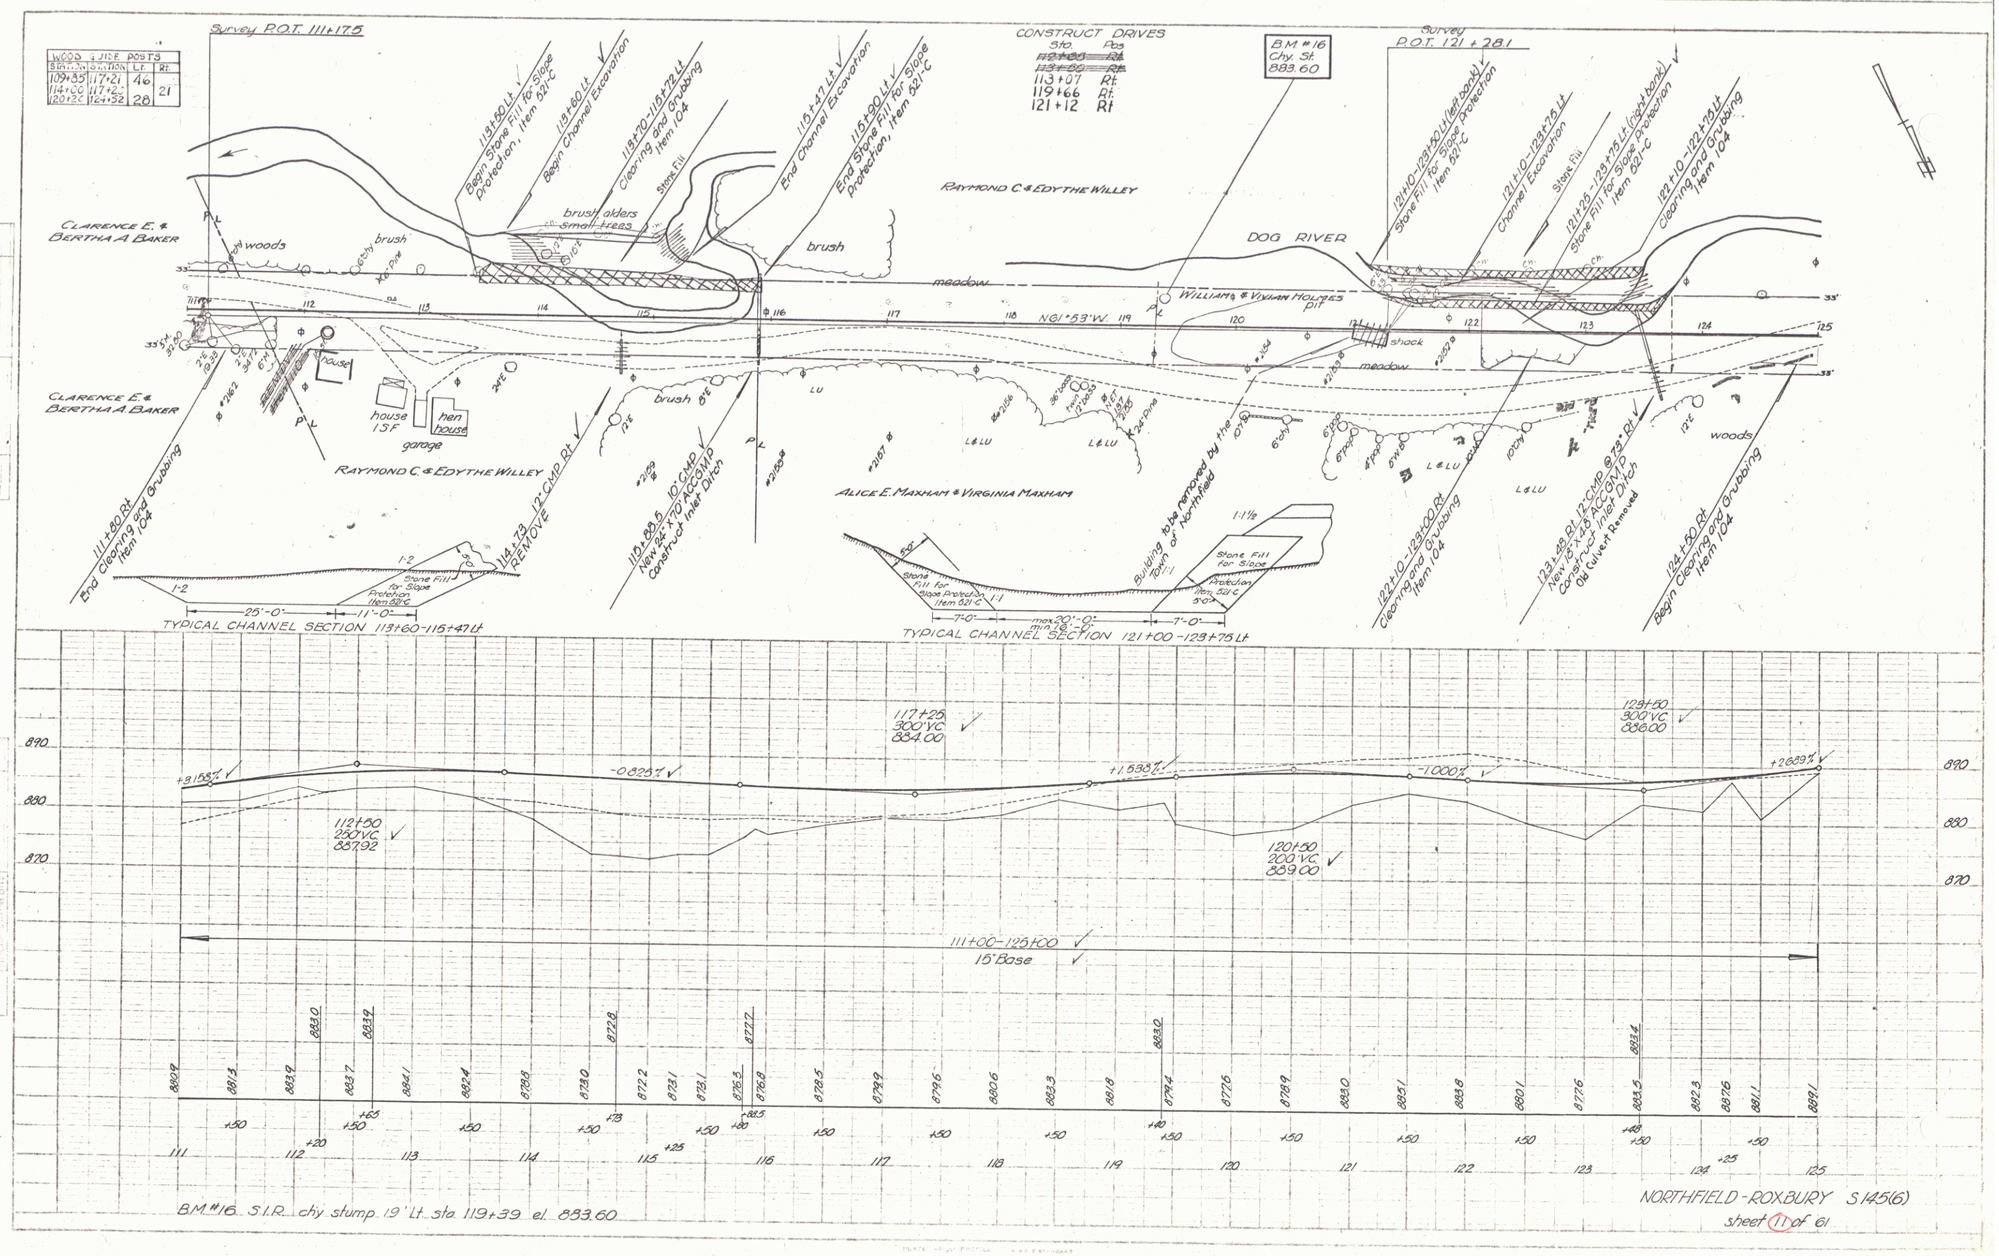
Survey P.O.T. 111+17.5
Survey P.O.T. 121+28.1
WOOD SIDE POSTS
STATION LT. RT.
109+35 117+21 46
114+00 117+25 21
120+30 124+52 28
CONSTRUCT DRIVES
Sta. Rds
113+07 Rt.
119+66 Rt.
121+12 Rt
B.M. #16 Chy. St. 883.60
113+60 Lt. Begin Stone Fill for Slope Protection, Item 521-C
113+60 Lt. Begin Channel Excavation
113+70-115+72 Lt. Clearing and Grubbing Item 104
Stone Fill
115+47 Lt. End Channel Excavation
115+60 Lt. End Stone Fill for Slope Protection, Item 521-C
121+10-123+50 Lt. (left bank) Stone Fill for Slope Protection Item 521-C
121+10-123+75 Lt. Channel Excavation
Stone Fill
121+25-123+75 Lt. (right bank) Stone Fill for Slope Protection Item 521-C
122+10-123+75 Lt. Clearing and Grubbing Item 104
CLARENCE E. & BERTHA A. BAKER
RAYMOND C. & EDYTHE WILLEY
DOG RIVER
WILLIAM & VIVIAN HOLMES
pit
shack
meadow
brush
woods
house
house 1SF
hen house
garage
N61°53'W
ALICE E. MAXHAM & VIRGINIA MAXHAM
111+60 Rt. End Clearing and Grubbing Item 104
114+73 12" CMP Rt. REMOVE
115+85.5 10" CMP New 24'x70' ACCSMP Construct Inlet Ditch
Building to be removed by the Town of Northfield
122+10-123+00 Rt. Clearing and Grubbing Item 104
123+48 Rt. 12" CMP @ 73' Rt. New 15'x40' ACCSMP Construct Inlet Ditch Old Culvert Removed
124+50 Rt. Begin Clearing and Grubbing Item 104
Stone Fill for Slope Protection Item 521-C
TYPICAL CHANNEL SECTION 113+60-115+47 Lt
TYPICAL CHANNEL SECTION 121+00-123+75 Lt
117+25 300' VC 884.00
129+50 300' VC 886.00
112+50 250' VC 887.92
120+50 200' VC 889.00
+9.158%
-0.825%
+1.598%
-1.000%
+2.689%
111+00-125+00
15' Base
B.M. #16 S.I.R. chy stump 19' Lt. sta. 119+39 el. 883.60
NORTHFIELD-ROXBURY S 145(6)
sheet 11 of 61

4