WOOD GUIDE POSTS			
STATION	STATION	Rt.	Lt.
153+305		1	1
153+91	155+25	10	
157+24		1	1
161+40		1	1
164+25	165+37		8

Δ 20° 52' LT.
D 5°
R 1146.3
T 211.1
L 417.3
E 19.3
Bank 3/4" per foot

CONSTRUCT DRIVES

Lt.	Rt.
163+00	~~157+43~~
~~164+00~~	165+66
167+50	157+49

Instr.	Date	Grantor	Grantee	Recorded	Book	Page	Date	Remarks
W.D.O.E.	6-2-53	George Wiley	Town of Roxbury	Roxbury	4	385	7-29-53	See Sheet 13 also
W.D.O.E.	6-2-53	Walter & Loretta Swan	" "	"	4	389	7-29-53	
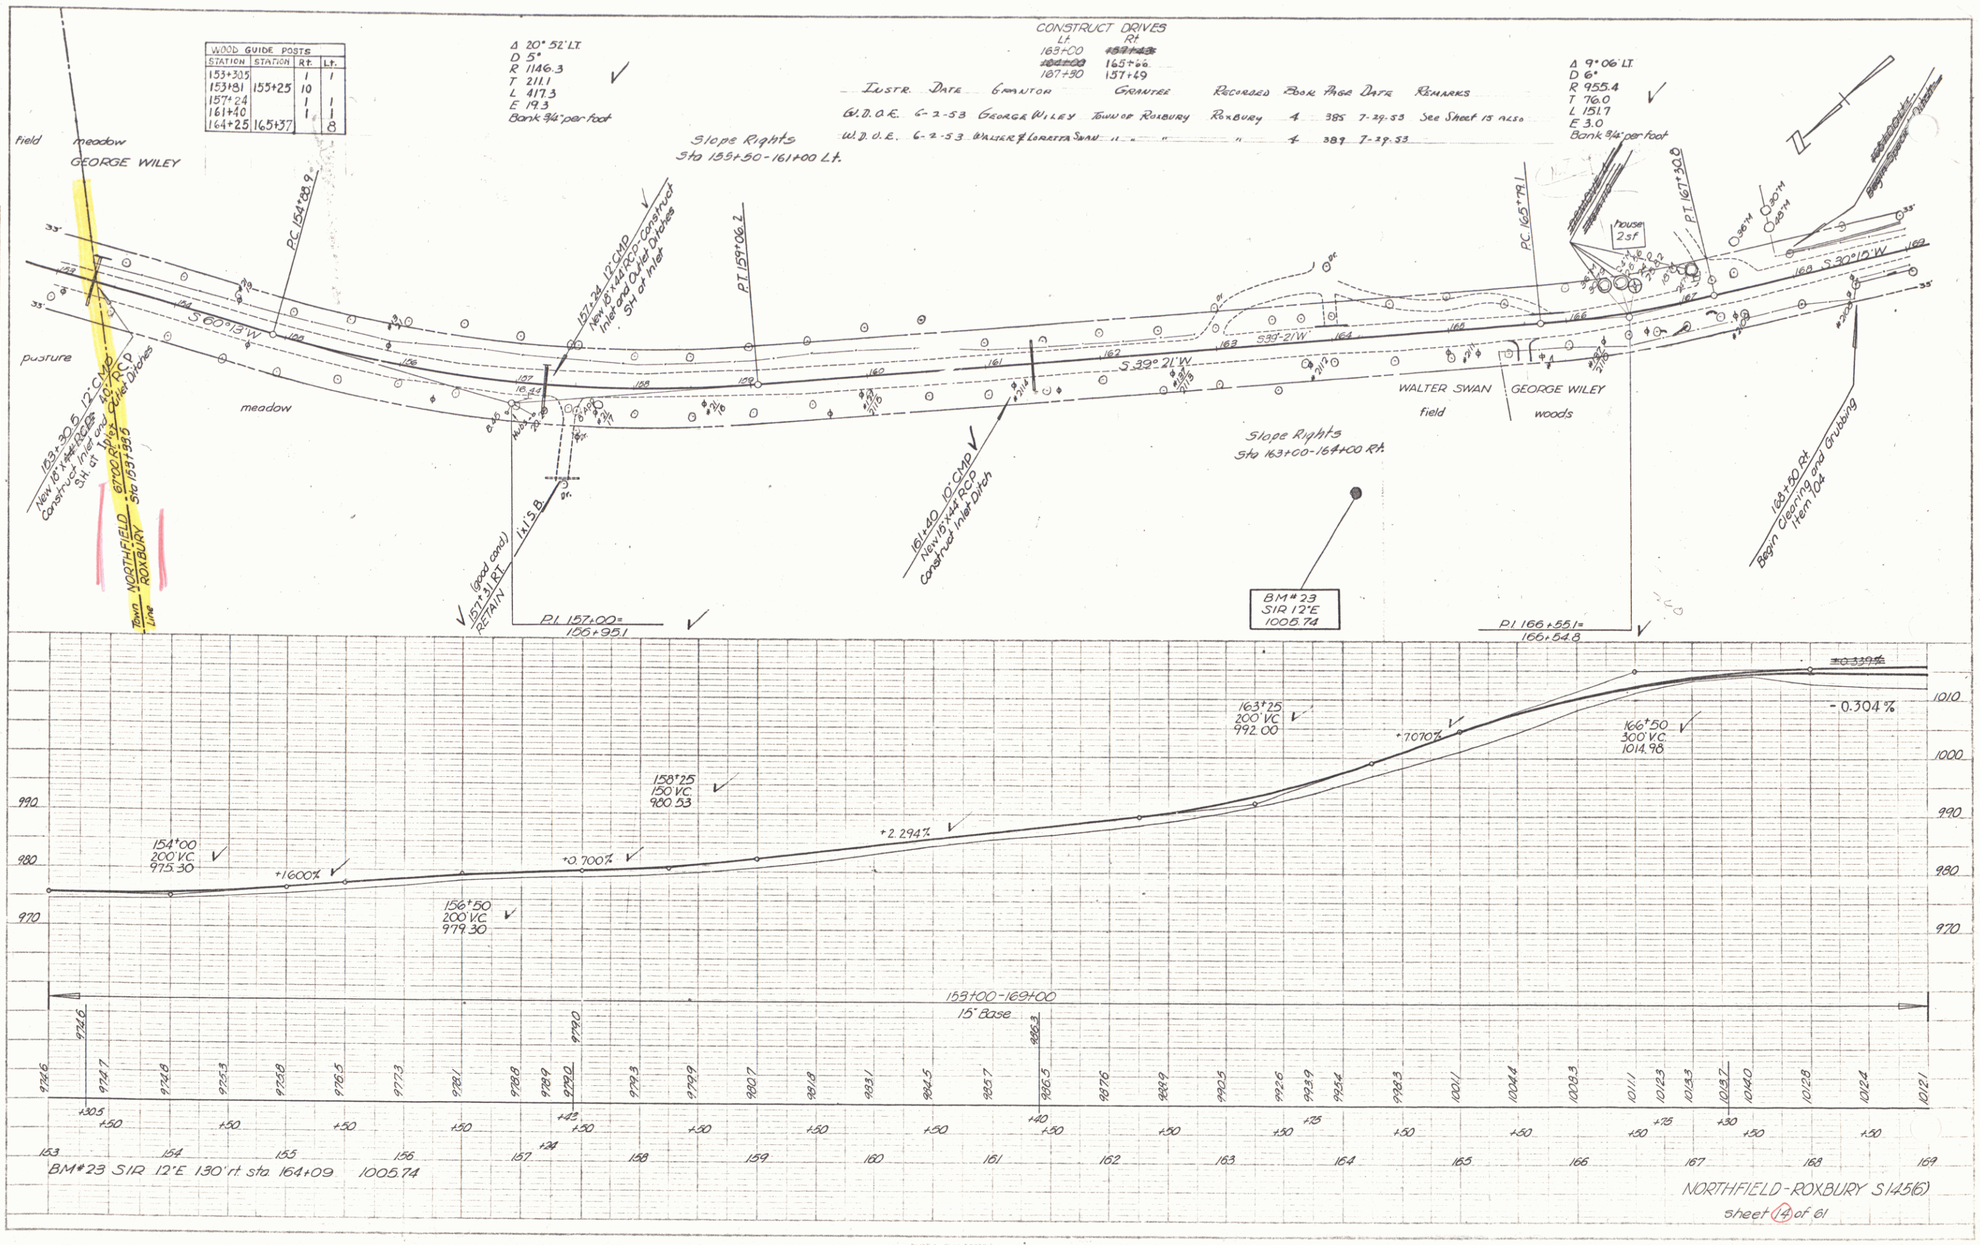
Δ 9° 06' LT.
D 6°
R 955.4
T 76.0
L 151.7
E 3.0
Bank 3/4" per foot