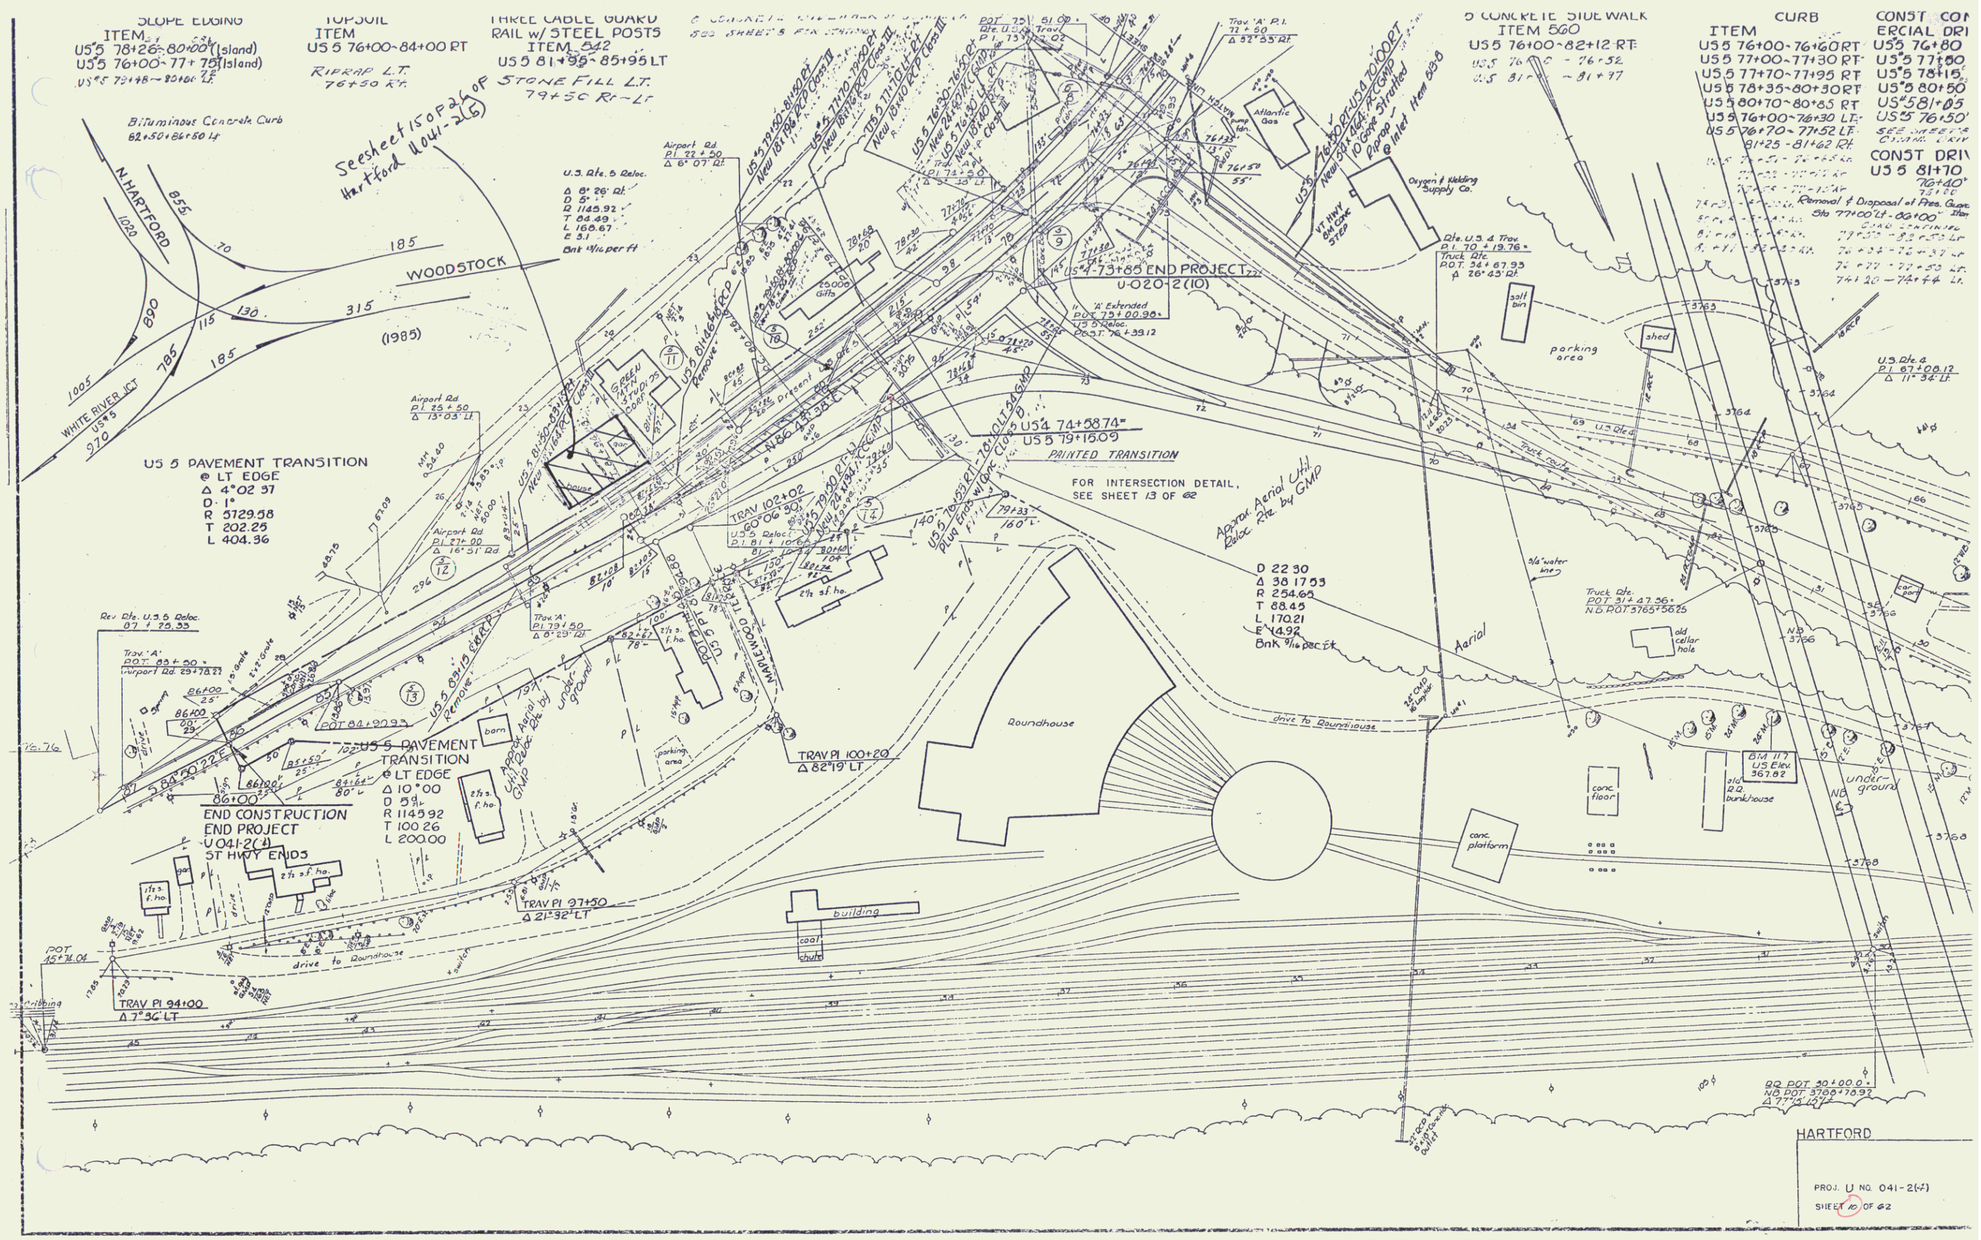
SLOPE EDGING
ITEM
US 5 78+26-80+00 (Island)
US 5 76+00-77+75 (Island)
TOPSOIL
ITEM
US 5 76+00-84+00 RT
RIPRAP L.T.
76+50 Rt.
THREE CABLE GUARD RAIL w/ STEEL POSTS
ITEM 542
US 5 81+35-85+95 LT
STONE FILL L.T.
79+50 Rt-Lt
CONCRETE SIDEWALK
ITEM 560
US 5 76+00-82+12 RT
CURB
ITEM
US 5 76+00-76+60 RT
US 5 77+00-77+30 RT
US 5 77+70-77+95 RT
US 5 78+35-80+50 RT
US 5 80+70-80+85 RT
US 5 76+00-76+30 LT
US 5 76+70-77+52 LT
81+25-81+62 RT
CONST DRI
US 5 81+70
Bituminous Concrete Curb
82+50+86+50 Lt
N. HARTFORD
WOODSTOCK
(1985)
WHITE RIVER JCT
US 5
Seesheet 15 of 26 of Hartford U041-2(6)
U.S. Rte. 5 Reloc.
Δ 8° 26' Rt.
D 5°
R 1145.92
T 84.49
L 168.67
E 3.1
Bnk 9/16 per ft
Airport Rd.
PI 72+50
Δ 6° 07' Rt
Airport Rd
PI 85+50
Δ 13° 03' Lt
Airport Rd
PI 77+00
Δ 16° 31' Rd
US 5 PAVEMENT TRANSITION
@ LT EDGE
Δ 4°02 37
D 1°
R 5729.58
T 202.25
L 404.36
END PROJECT
U-020-2(10)
US 4 74+58.74"
US 5 79+15.09
PAINTED TRANSITION
FOR INTERSECTION DETAIL, SEE SHEET 13 OF 62
Approx Aerial Util. Reloc. Ste. by GMP
D 22 30
Δ 38 17 59
R 254.69
T 88.45
L 170.21
E 14.92
Bnk 9/16 per ft
Aerial
Roundhouse
drive to Roundhouse
TRAV PI 100+20
Δ 82°19' LT
TRAV PI 102+02
Δ 50°06' 30"
Rev Rte. U.S. 5 Reloc.
07 + 75.55
Trav 'A'
POT 83+00
Airport Rd. 29+78.21
POT 041+09.93
US 5 PAVEMENT TRANSITION
@ LT EDGE
Δ 10°00
D 5°
R 1145.92
T 100.26
L 200.00
END CONSTRUCTION
END PROJECT
U 041-2(4)
ST HWY ENDS
TRAV PI 97+50
Δ 21°32' LT
TRAV PI 94+00
Δ 7°36' LT
building
coal chute
drive to Roundhouse
parking area
barn
Atlantic Gas
Oxygen & Welding Supply Co.
salt bin
shed
old cellar hole
conc floor
conc platform
old 2-2 bunkhouse
BM 117
US Elev. 367.82
under ground
N.B. 3766
Truck Rte.
POT 31+47.36
N.B. POT 3765+56.26
U.S. Rte. 5
Pl 67+00.12
Δ 11° 34' LT
Removal & Disposal of Pres. Guar.
Sta 77+00 Lt - 84+00 Lt
HARTFORD
PROJ. U NO. 041-2(4)
SHEET 10 OF 62

14