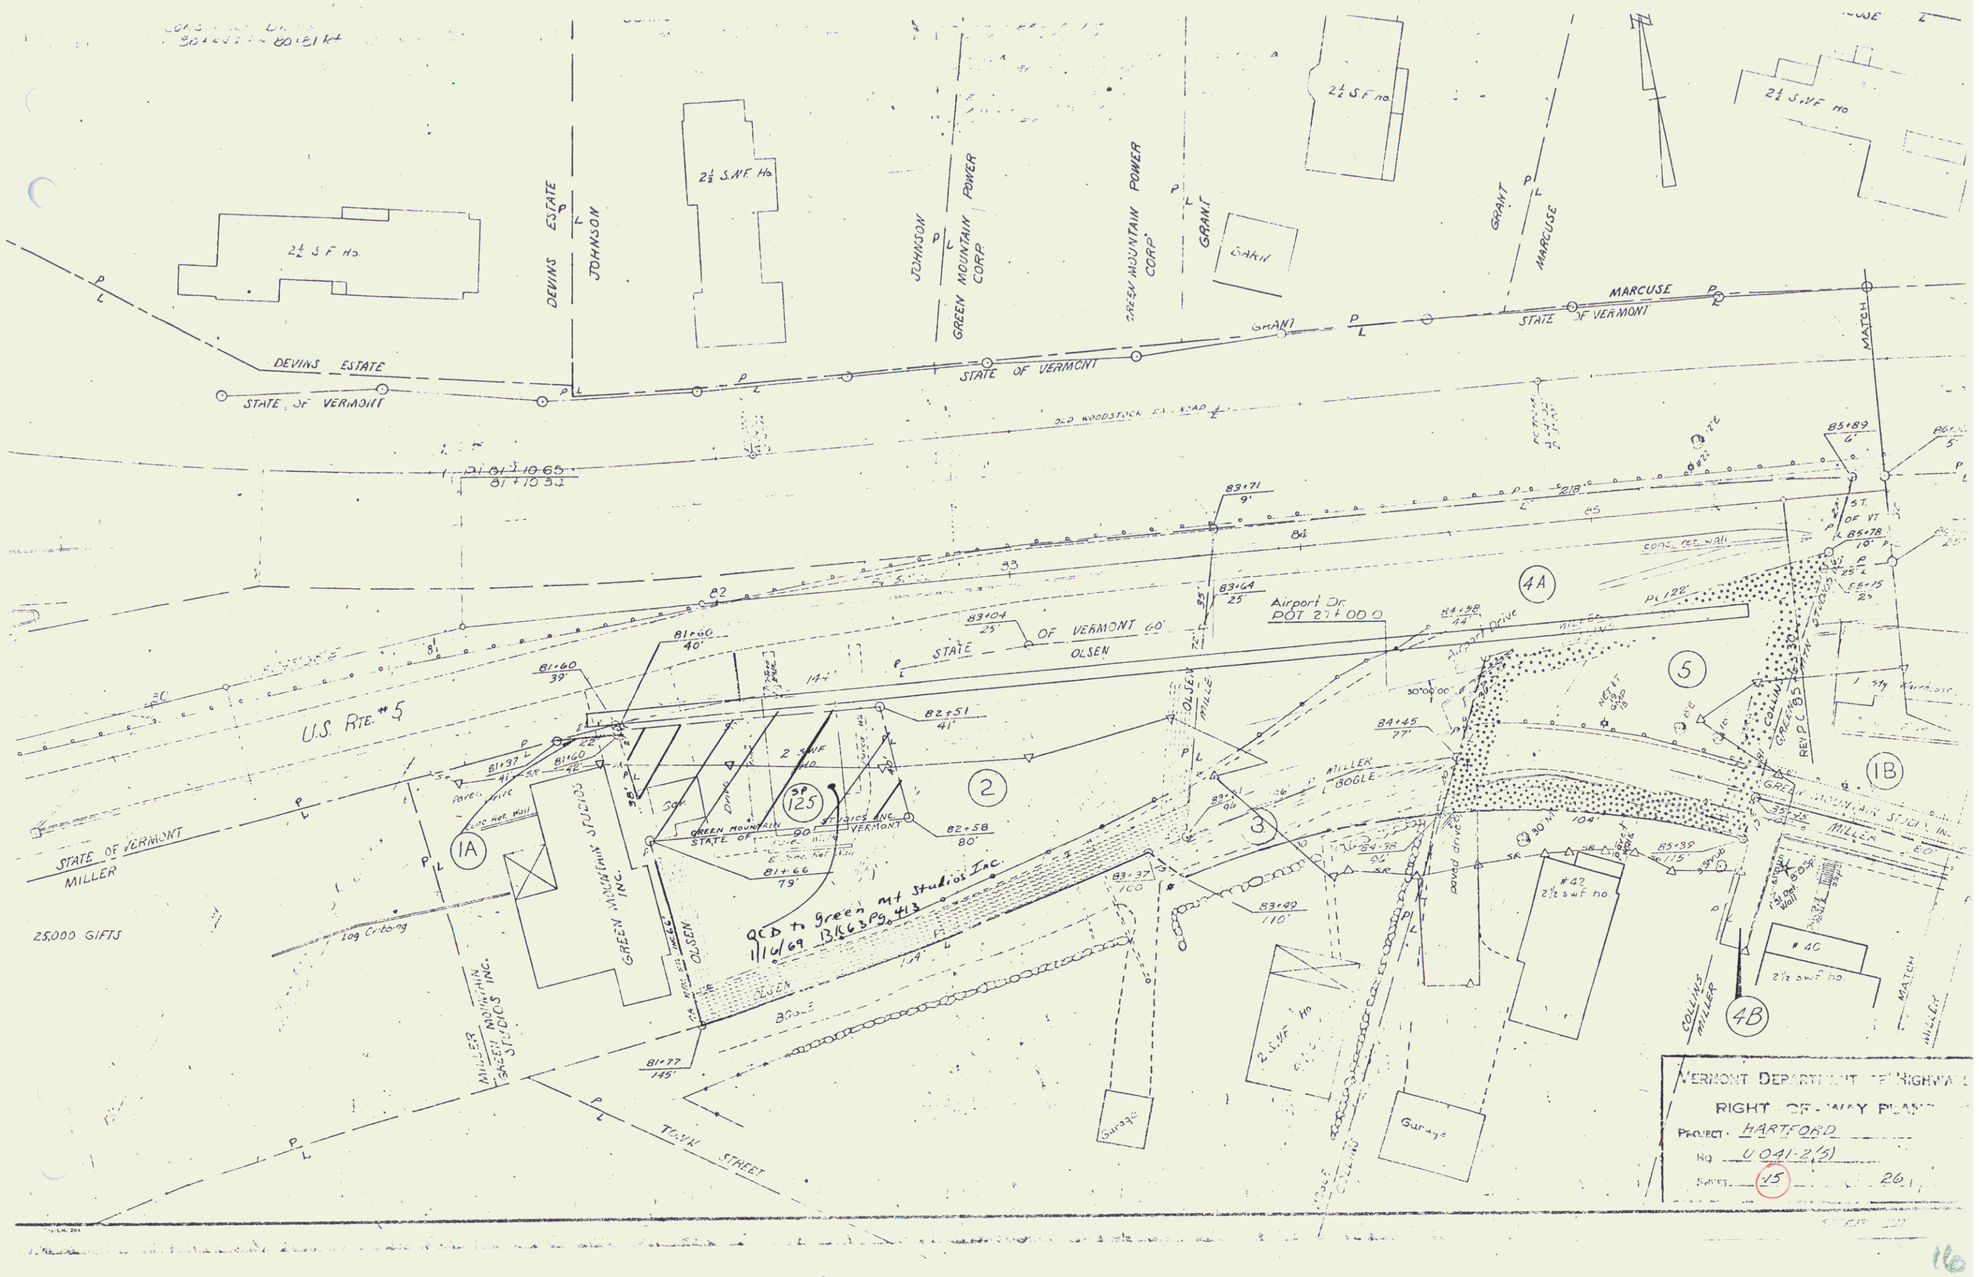
DEVINS ESTATE
JOHNSON
GREEN MOUNTAIN POWER CORP
GRANT
MARCUSE
STATE OF VERMONT
OLD WOODSTOCK RD. ROAD
U.S. RTE. #5
Airport Dr.
POT 27+00.0
OLSEN
MILLER
BOGLE
COLLINS
GREEN MOUNTAIN STUDIOS INC.
TOWN STREET
25,000 GIFTS
QCD to Green Mt Studios Inc.
11/6/69 B166 Pg. 413
VERMONT DEPARTMENT OF HIGHWAYS
RIGHT-OF-WAY PLAN
PROJECT HARTFORD
No. U 041-2(5)
SHEET 15 OF 26