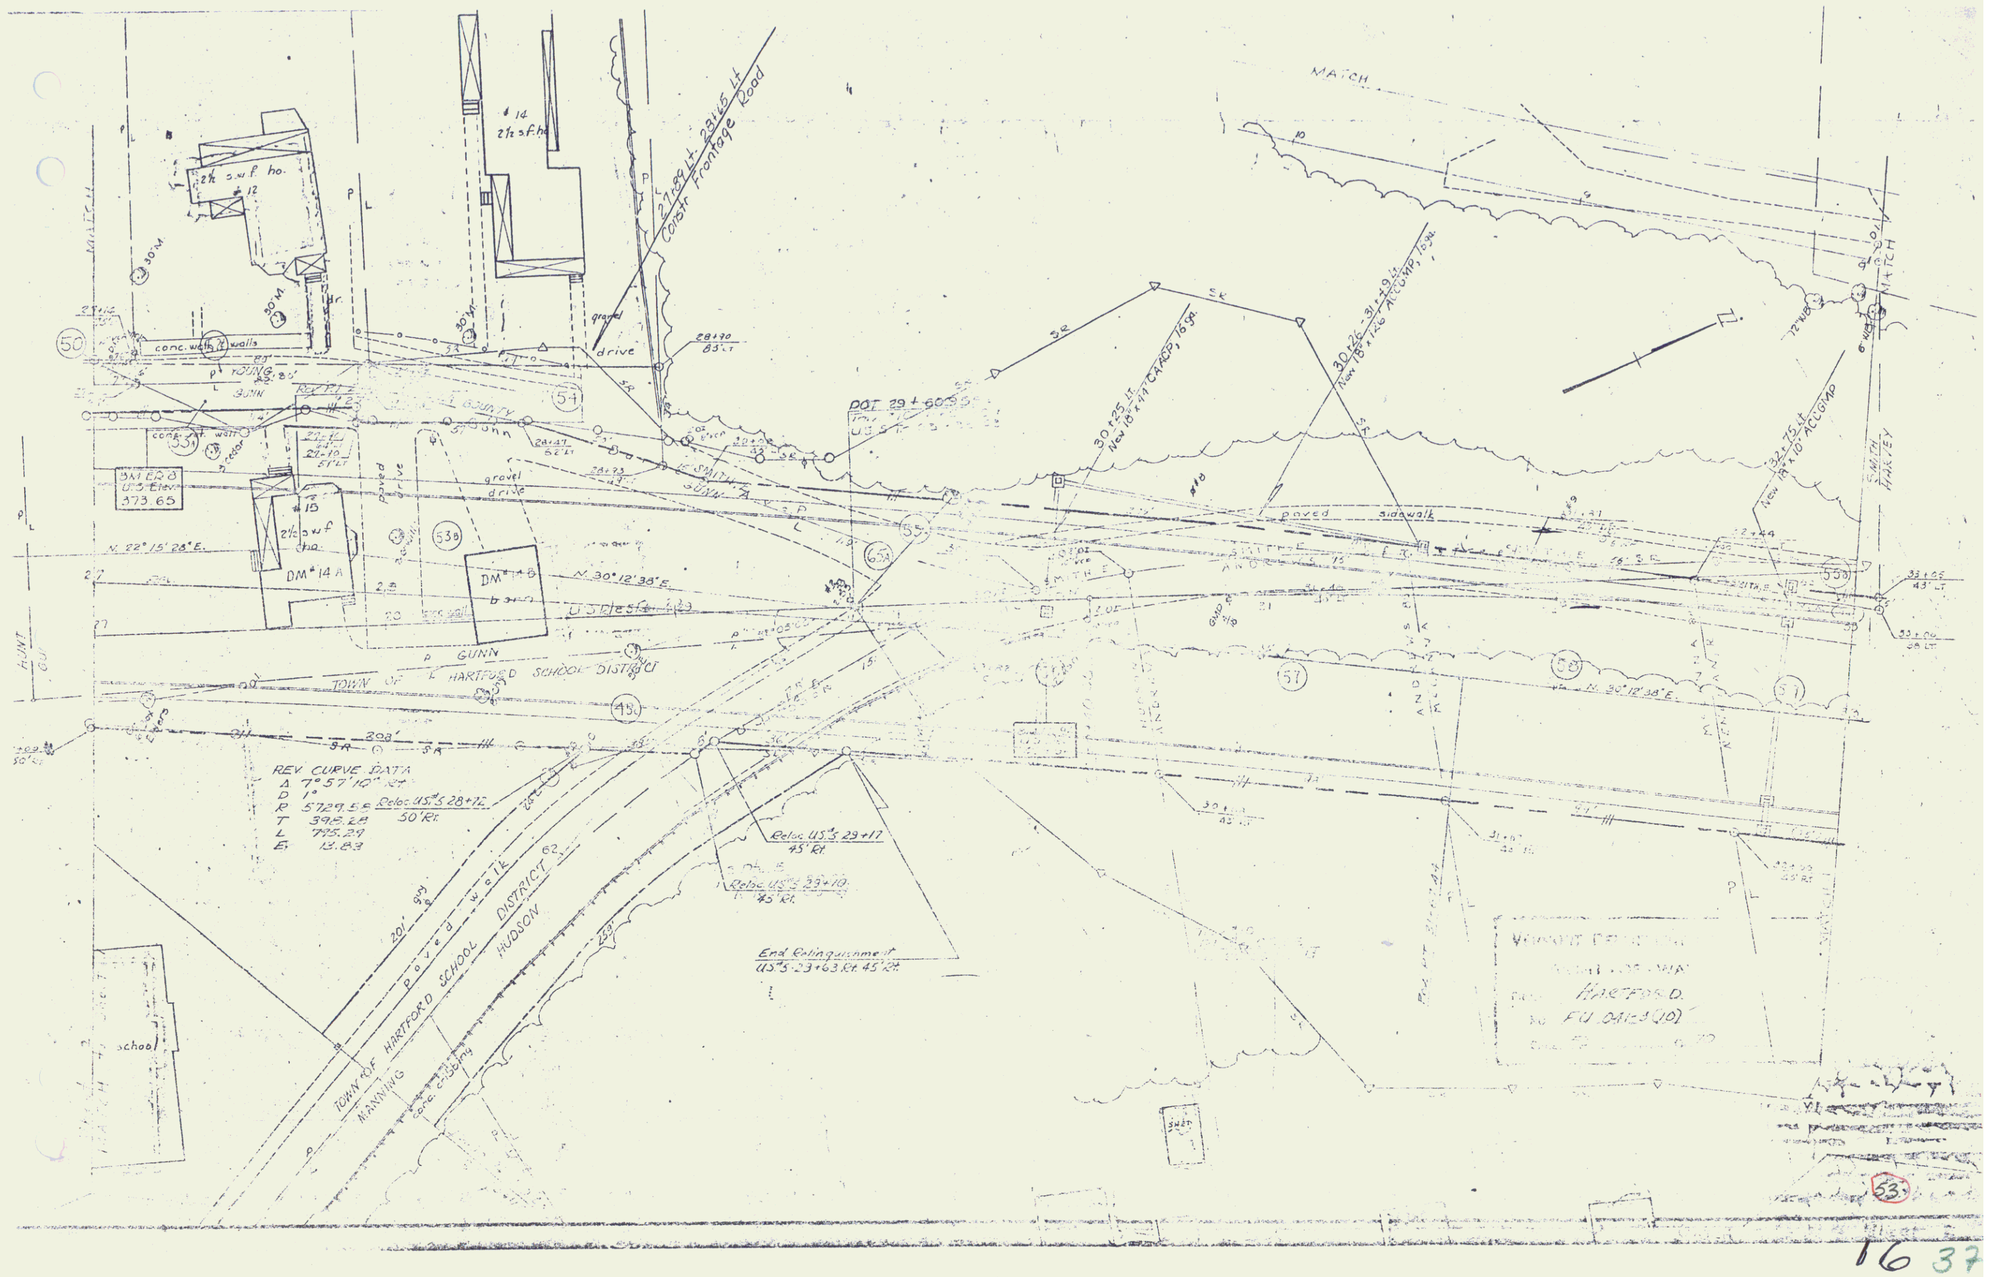
MARCH
Constr Frontage Road
gravel drive
conc. with walls
TOWN OF HARTFORD
GUNN
SMITH
HARVEY
DM #14 A
DM #14 B
N. 22° 15' 28" E.
N. 30° 12' 38" E.
paved sidewalk
REV CURVE DATA
Δ 7° 57' 10" Rt
D 1°
R 5729.58
T 398.28
L 795.29
E 13.83
Reloc 45" S 28+12 50' Rt
Reloc 45" S 29+17 45' Rt
Reloc 45" S 29+10 45' Rt
End Relinquishment 45" S 29+63 Rt 45' Rt
paved walk
TOWN OF HARTFORD SCHOOL DISTRICT
MANNING
HUDSON
school
HARTFORD
FU 0413(10)
16 37