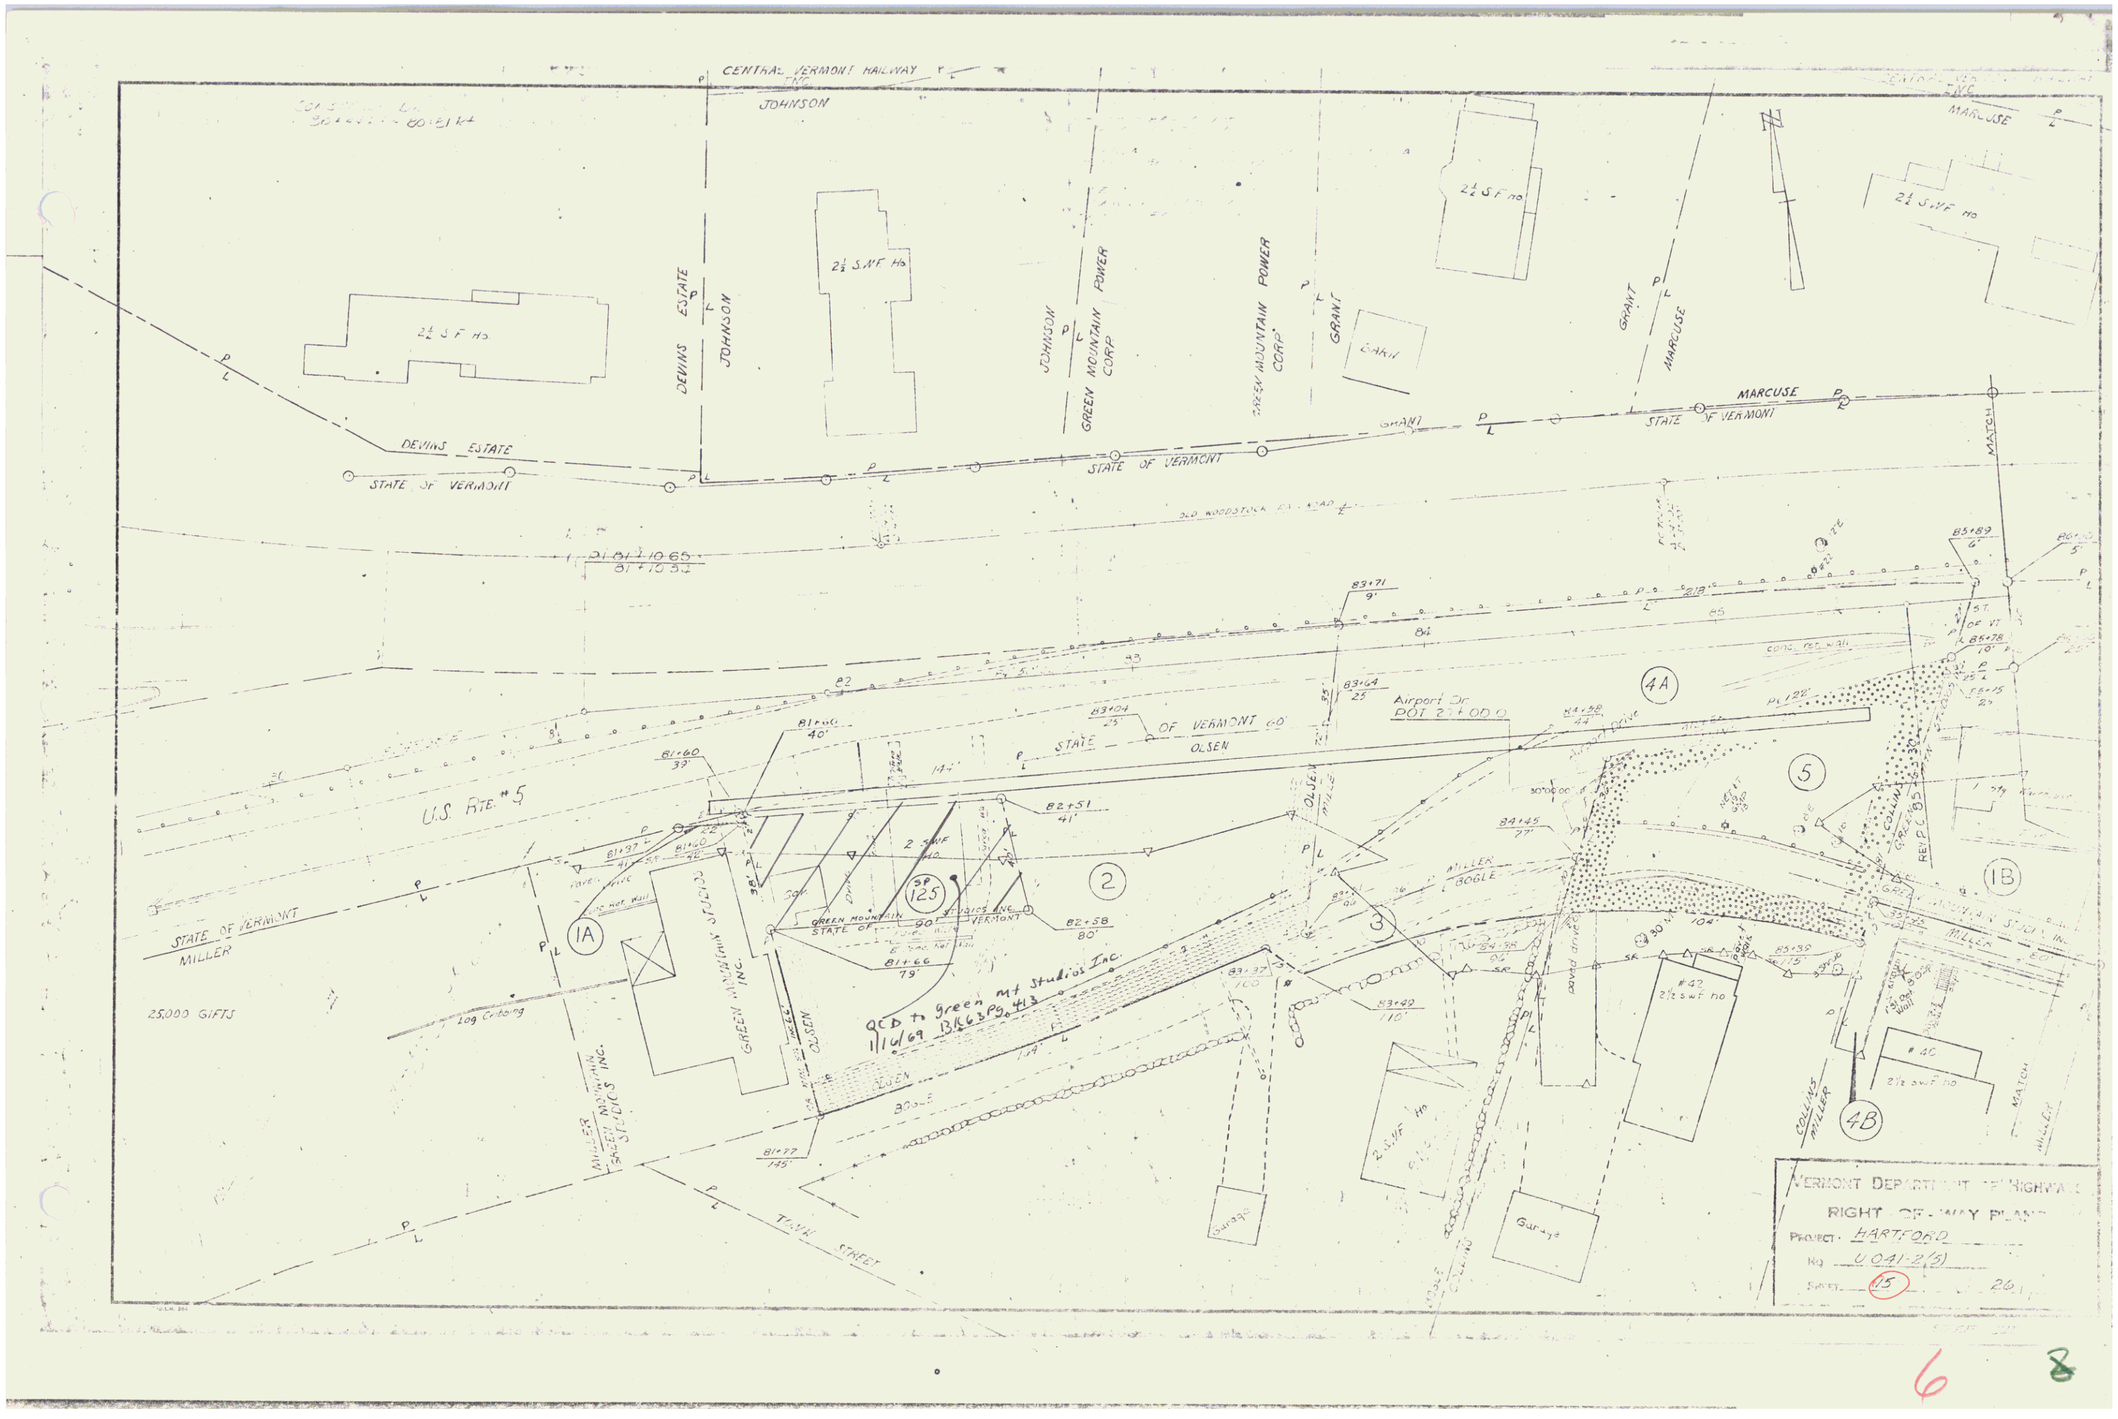
CENTRAL VERMONT RAILWAY INC.
JOHNSON
DEVINS ESTATE
JOHNSON
GREEN MOUNTAIN POWER CORP
GRANT
MARCUSE
STATE OF VERMONT
OLD WOODSTOCK ROAD
U.S. RTE. #5
Airport Dr
OLSEN
MILLER
GREEN MOUNTAIN STUDIOS INC.
QCD to Green Mt Studios Inc. 1/16/69 Bk63 Pg413
25,000 GIFTS
Log Cribbing
TOWN STREET
COLLINS
MATCH
VERMONT DEPARTMENT OF HIGHWAYS
RIGHT OF WAY PLAN
PROJECT: HARTFORD
NO. U 041-2(5)
SHEET 15 26

6 8