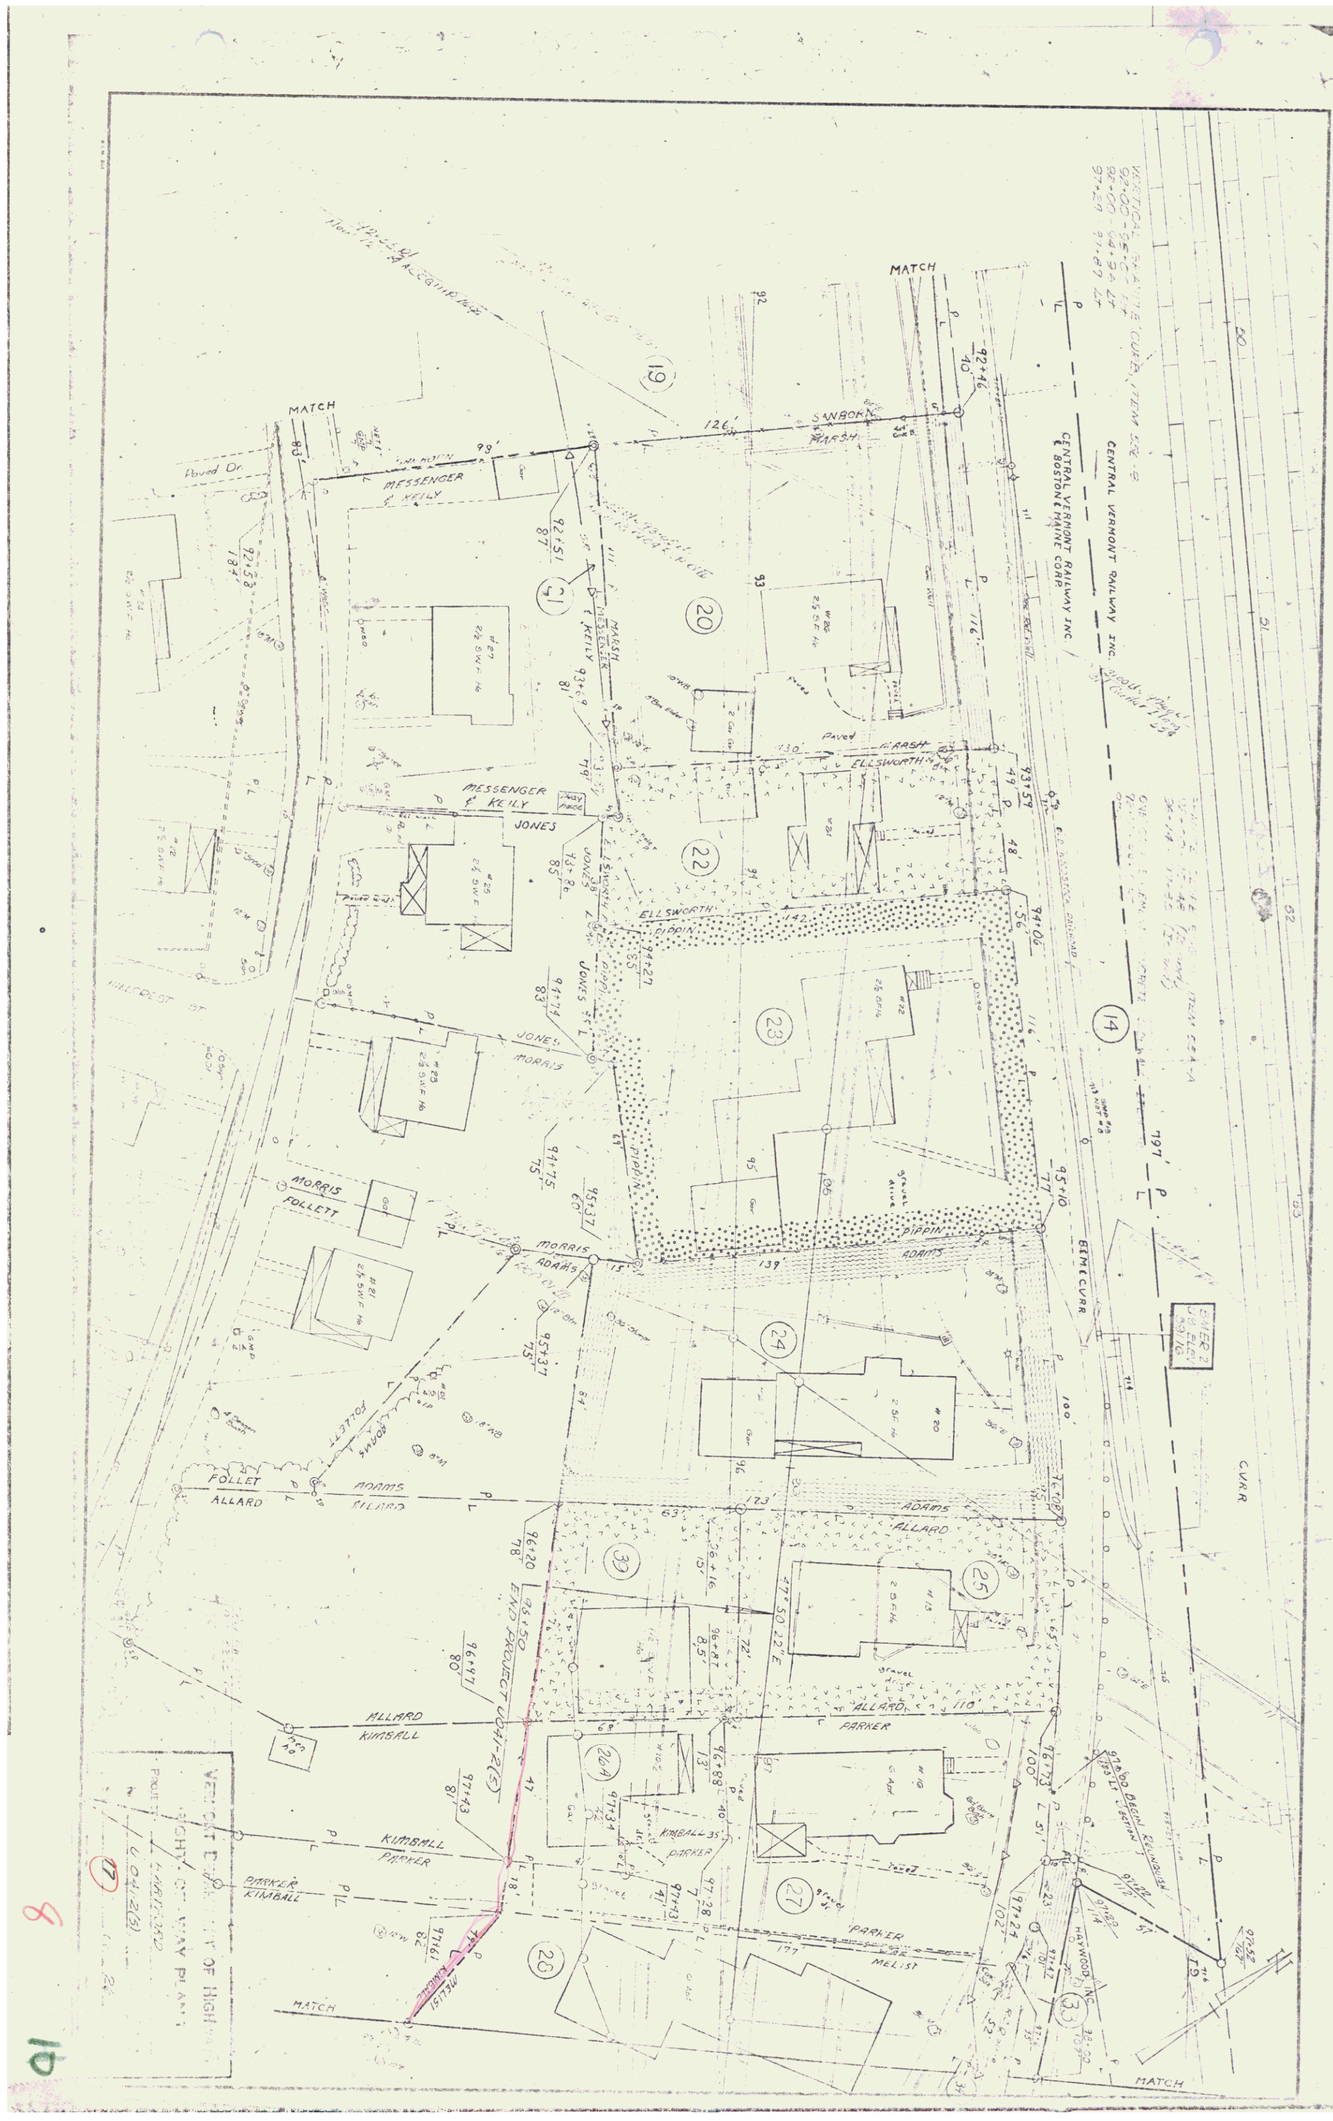
CENTRAL VERMONT RAILWAY INC.
CENTRAL VERMONT RAILWAY INC.
& BOSTON & MAINE CORP.
MATCH
MESSENGER
KELLY
SANBORN
MARSH
ELLSWORTH
JONES
DIPPIN
MORRIS
ADAMS
FOLLETT
ALLARD
KIMBALL
PARKER
MELIST
HAYWOOD INC.
CLARK
END PROJECT (04-2(5))
VERMONT DEPARTMENT OF HIGHWAYS
HIGHWAY PLANS
PROJECT 04-2(5)
8
19