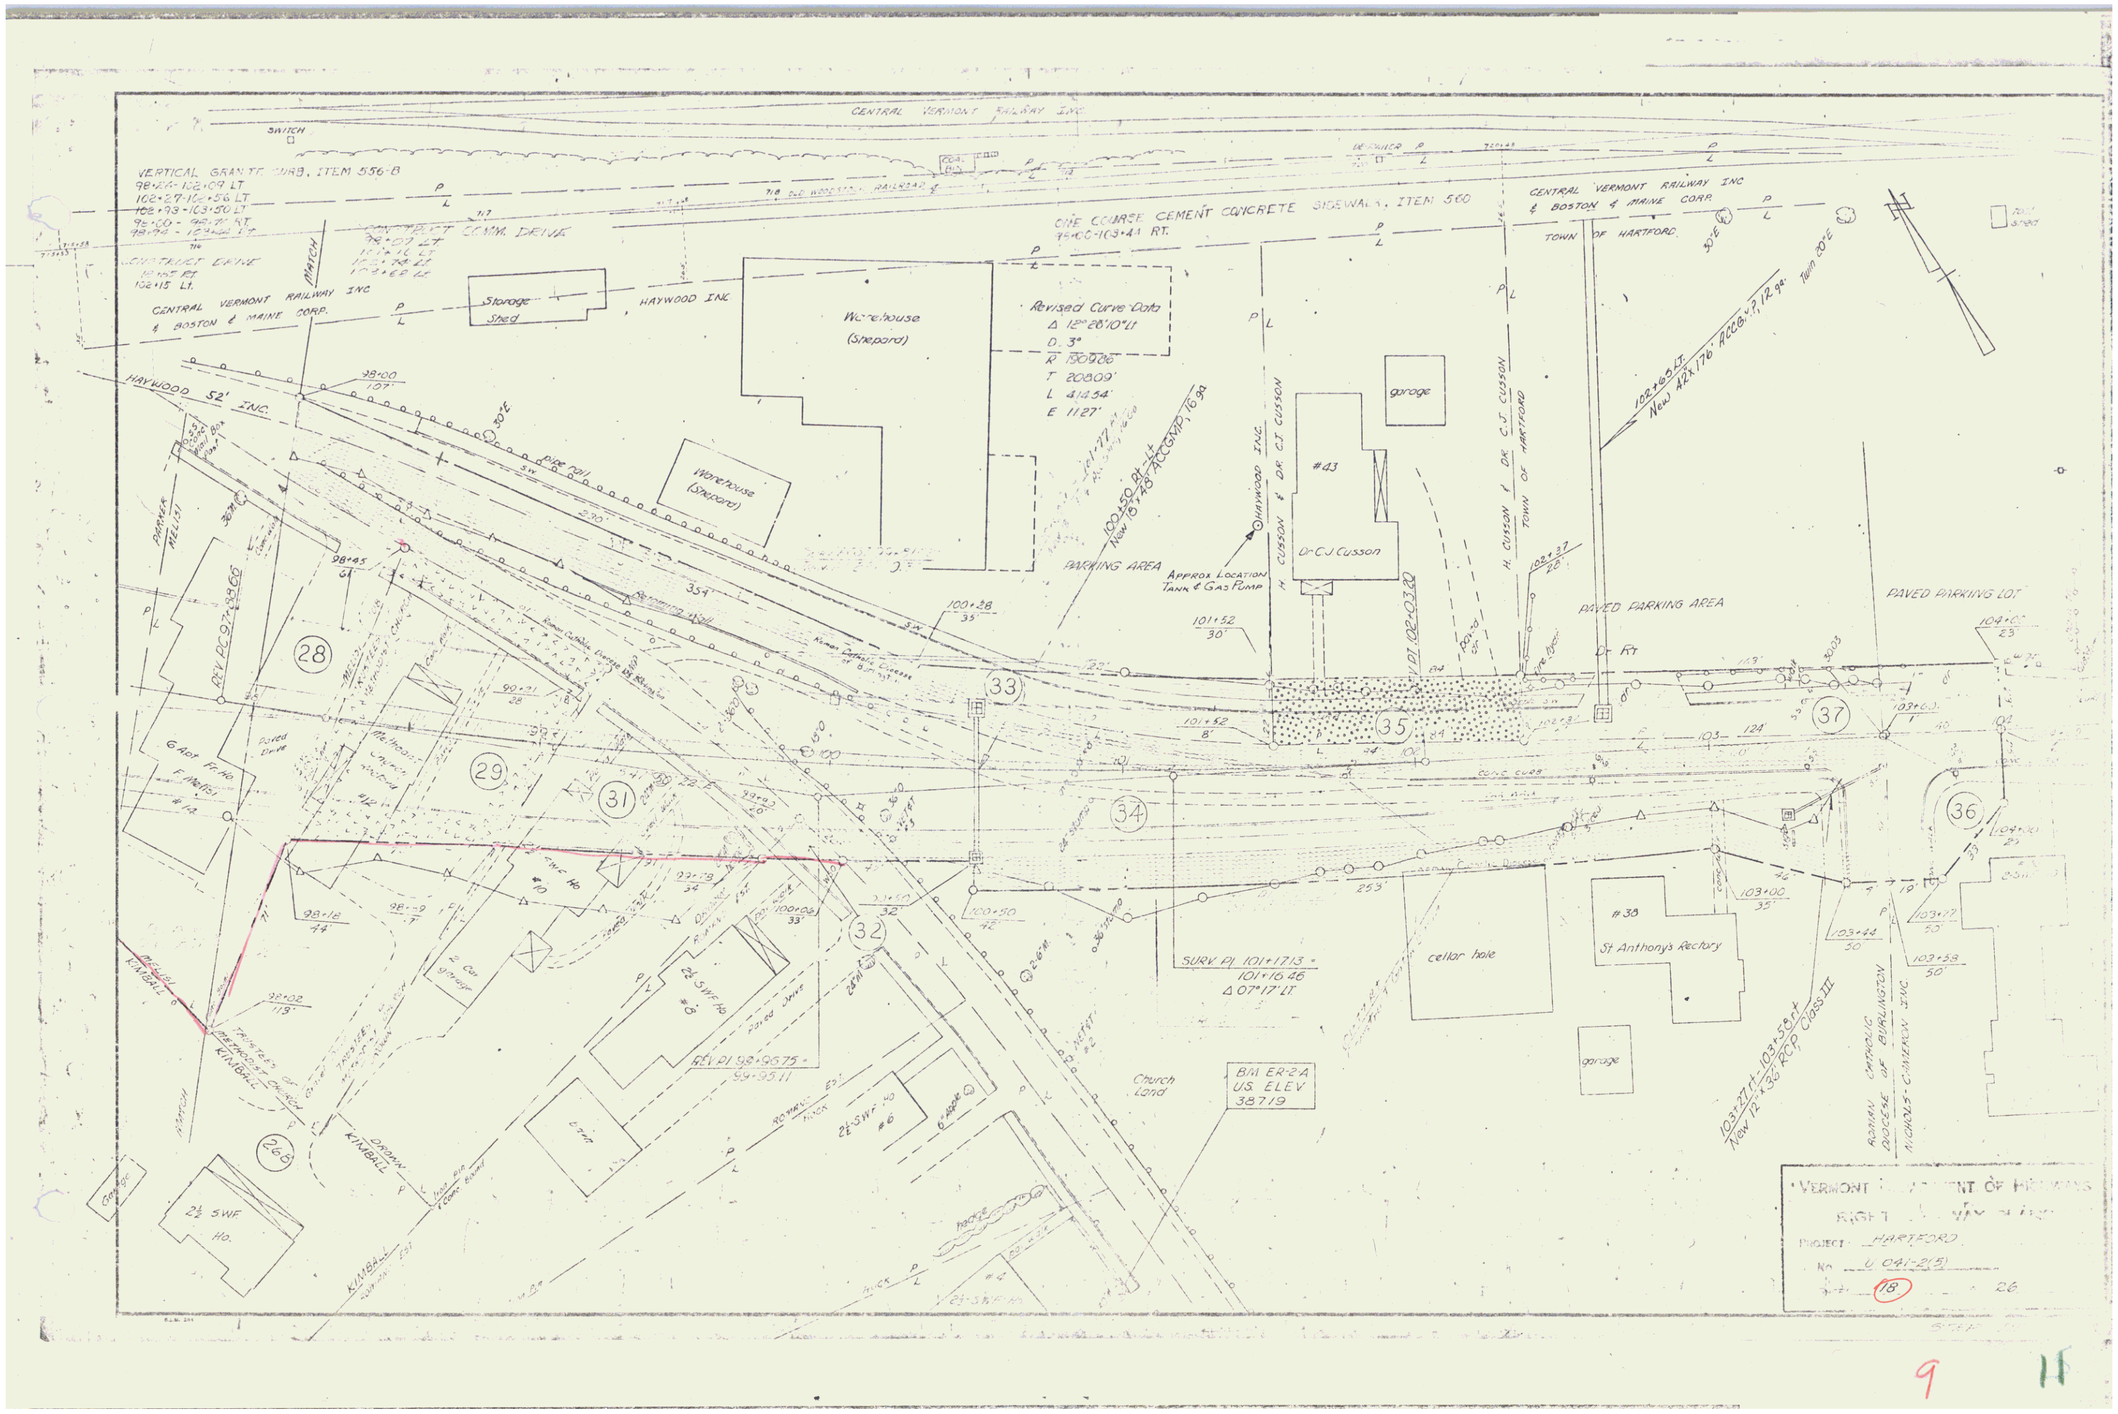
CENTRAL VERMONT RAILWAY INC
SWITCH
VERTICAL GRANITE CURB, ITEM 556-B
CONCRETE COMM. DRIVE
CONCRETE DRIVE
CENTRAL VERMONT RAILWAY INC
& BOSTON & MAINE CORP.
ONE COURSE CEMENT CONCRETE SIDEWALK, ITEM 560
CENTRAL VERMONT RAILWAY INC
& BOSTON & MAINE CORP.
TOWN OF HARTFORD
Storage Shed
HAYWOOD INC
Warehouse (Shepard)
Revised Curve Data
Δ 12°28'10" Lt
D 3°
R 1909.86
T 208.09'
L 414.54'
E 11.27'
HAYWOOD 52' INC.
Warehouse (Shepard)
PARKING AREA
Approx Location Tank & Gas Pump
HAYWOOD INC.
H. CUSSON & DR. C.J. CUSSON
#43
Dr. C.J. Cusson
garage
H. CUSSON & DR. C.J. CUSSON
TOWN OF HARTFORD
PAVED PARKING AREA
PAVED PARKING LOT
28
29
31
33
34
35
37
36
32
26B
SURV. PI 101+17.13 =
101+16.46
Δ 07°17' LT
cellar hole
St Anthony's Rectory
garage
Church Land
B/M ER-2A
U.S. ELEV
387.19
103+27 ft - 103+54 ft
ROMAN CATHOLIC DIOCESE OF BURLINGTON
VERMONT DEPARTMENT OF HIGHWAYS
RIGHT OF WAY PLAN
PROJECT HARTFORD
No. U 041-2(5)
Sheet 18 of 26

9 11