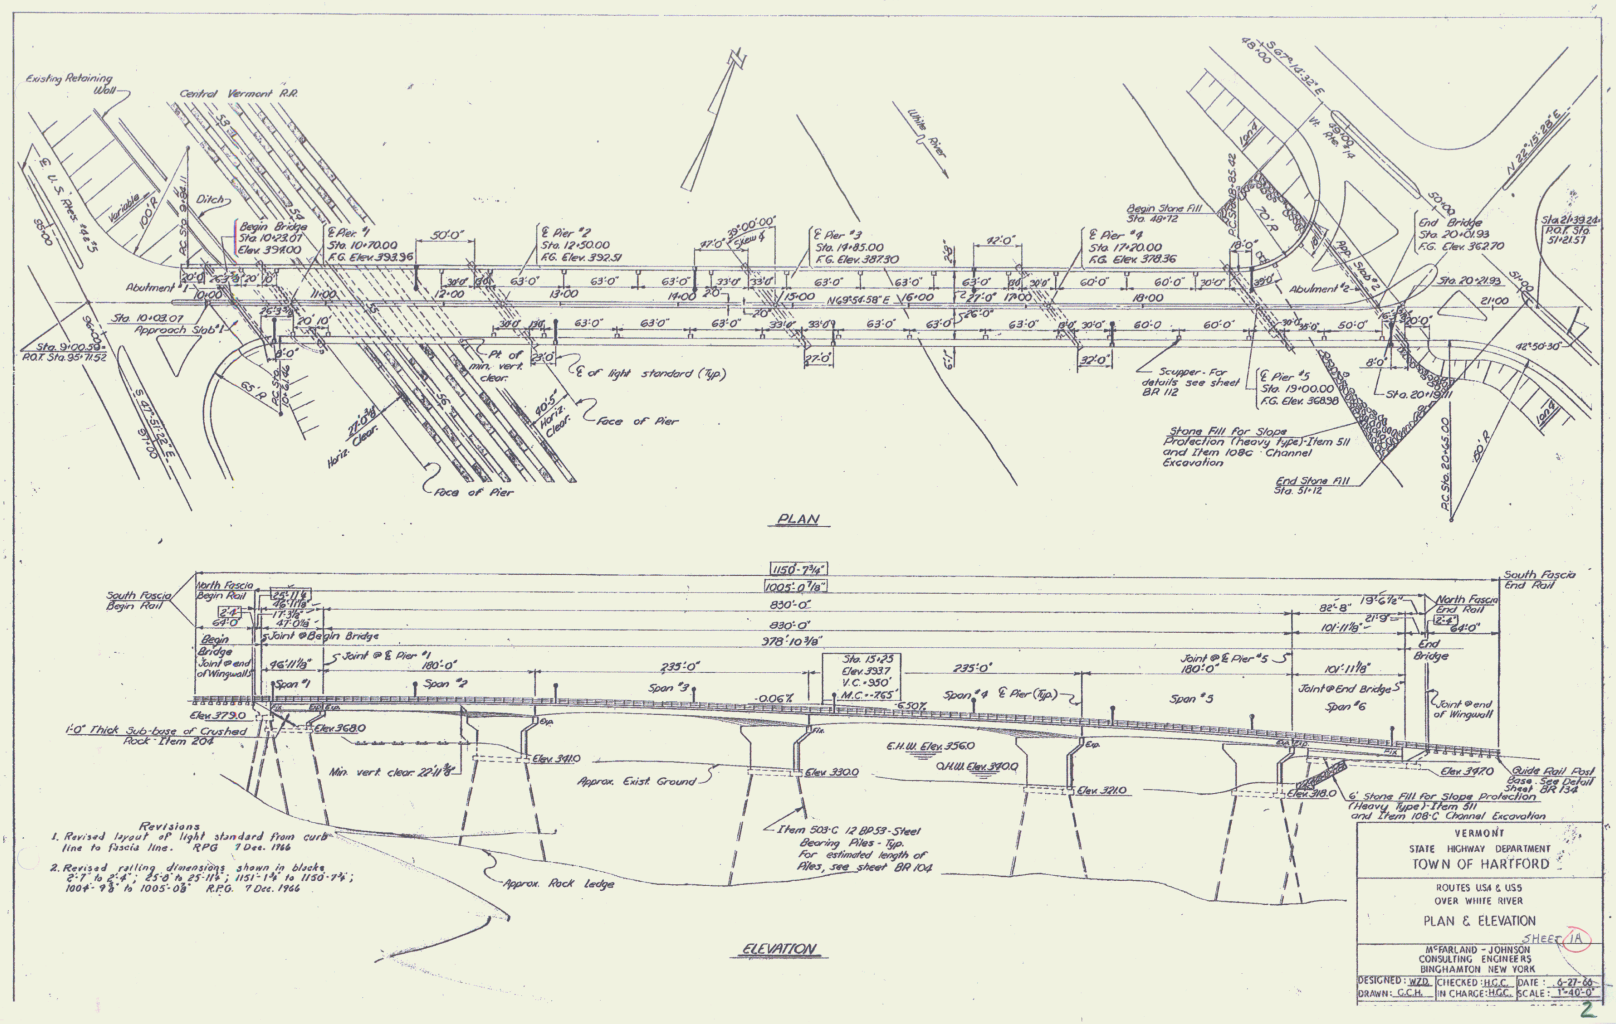

Revisions

1. Revised layout of light standard from curb line to fascia line. RPG 7 Dec. 1966
2. Revised rolling dimensions shown in blocks 2'-7" to 2'-4"; 25'-0" to 25'-11 7/8"; 1151'-1 7/8" to 1150'-7 3/4"; 1004'-9 7/8" to 1005'-0 7/8" R.P.G. 7 Dec. 1966

VERMONT
STATE HIGHWAY DEPARTMENT
TOWN OF HARTFORD

ROUTES US4 & US5
OVER WHITE RIVER

PLAN & ELEVATION

SHEET 1A

McFARLAND - JOHNSON
CONSULTING ENGINEERS
BINGHAMTON NEW YORK

DESIGNED: WZD	CHECKED: H.G.C.	DATE: 6-27-66
DRAWN: G.C.H.	IN CHARGE: H.G.C.	SCALE: 1"=40'-0"

2