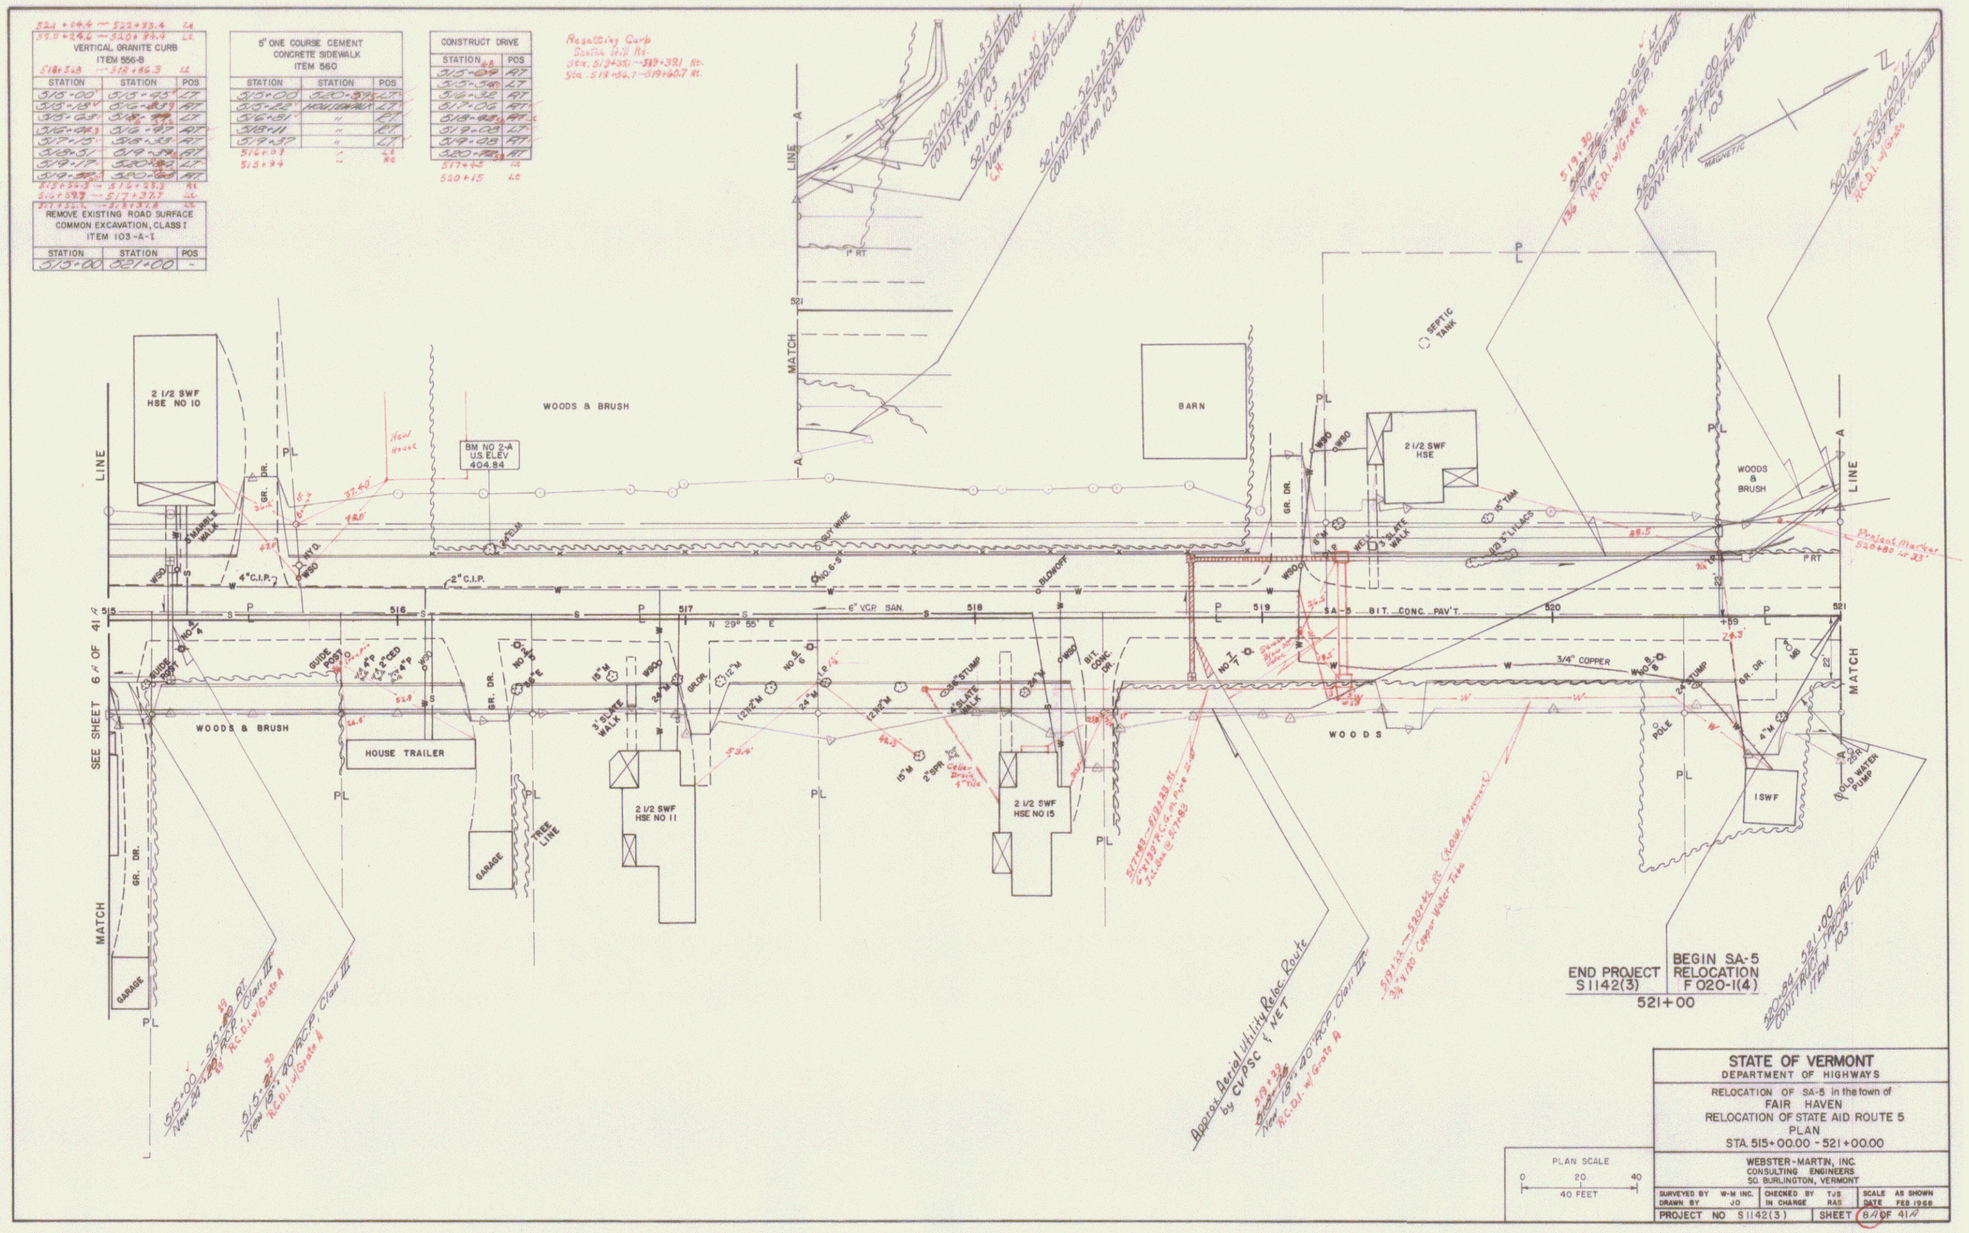
VERTICAL GRANITE CURB
ITEM 556-B
5" ONE COURSE CEMENT CONCRETE SIDEWALK
ITEM 560
CONSTRUCT DRIVE
REMOVE EXISTING ROAD SURFACE COMMON EXCAVATION, CLASS I
ITEM 103-A-1
2 1/2 SWF HSE NO 10
WOODS & BRUSH
BM NO 2-A U.S. ELEV 404.84
BARN
SEPTIC TANK
2 1/2 SWF HSE
WOODS & BRUSH
HOUSE TRAILER
GARAGE
2 1/2 SWF HSE NO 11
2 1/2 SWF HSE NO 15
WOODS
1 SWF
SA-5 BIT. CONC. PAV'T.
6" VCP SAN.
3/4" COPPER
N 29° 55' E
SEE SHEET 6 OF 41
MATCH
END PROJECT S1142(3)
BEGIN SA-5 RELOCATION F 020-1(4)
521+00
PLAN SCALE
0 20 40
40 FEET
STATE OF VERMONT
DEPARTMENT OF HIGHWAYS
RELOCATION OF SA-5 in the town of
FAIR HAVEN
RELOCATION OF STATE AID ROUTE 5
PLAN
STA. 515+00.00 - 521+00.00
WEBSTER-MARTIN, INC.
CONSULTING ENGINEERS
SO. BURLINGTON, VERMONT
SURVEYED BY W-M INC.
DRAWN BY JD
CHECKED BY TJS
IN CHARGE RAS
SCALE AS SHOWN
DATE FEB 1968
PROJECT NO S1142(3)
SHEET 8 OF 41