


FED. ROAD DIST. NO.	STATE	PROJ. NO.	FISCAL YEAR	SHEET NO.	TOTAL SHEETS
7	Vt.				



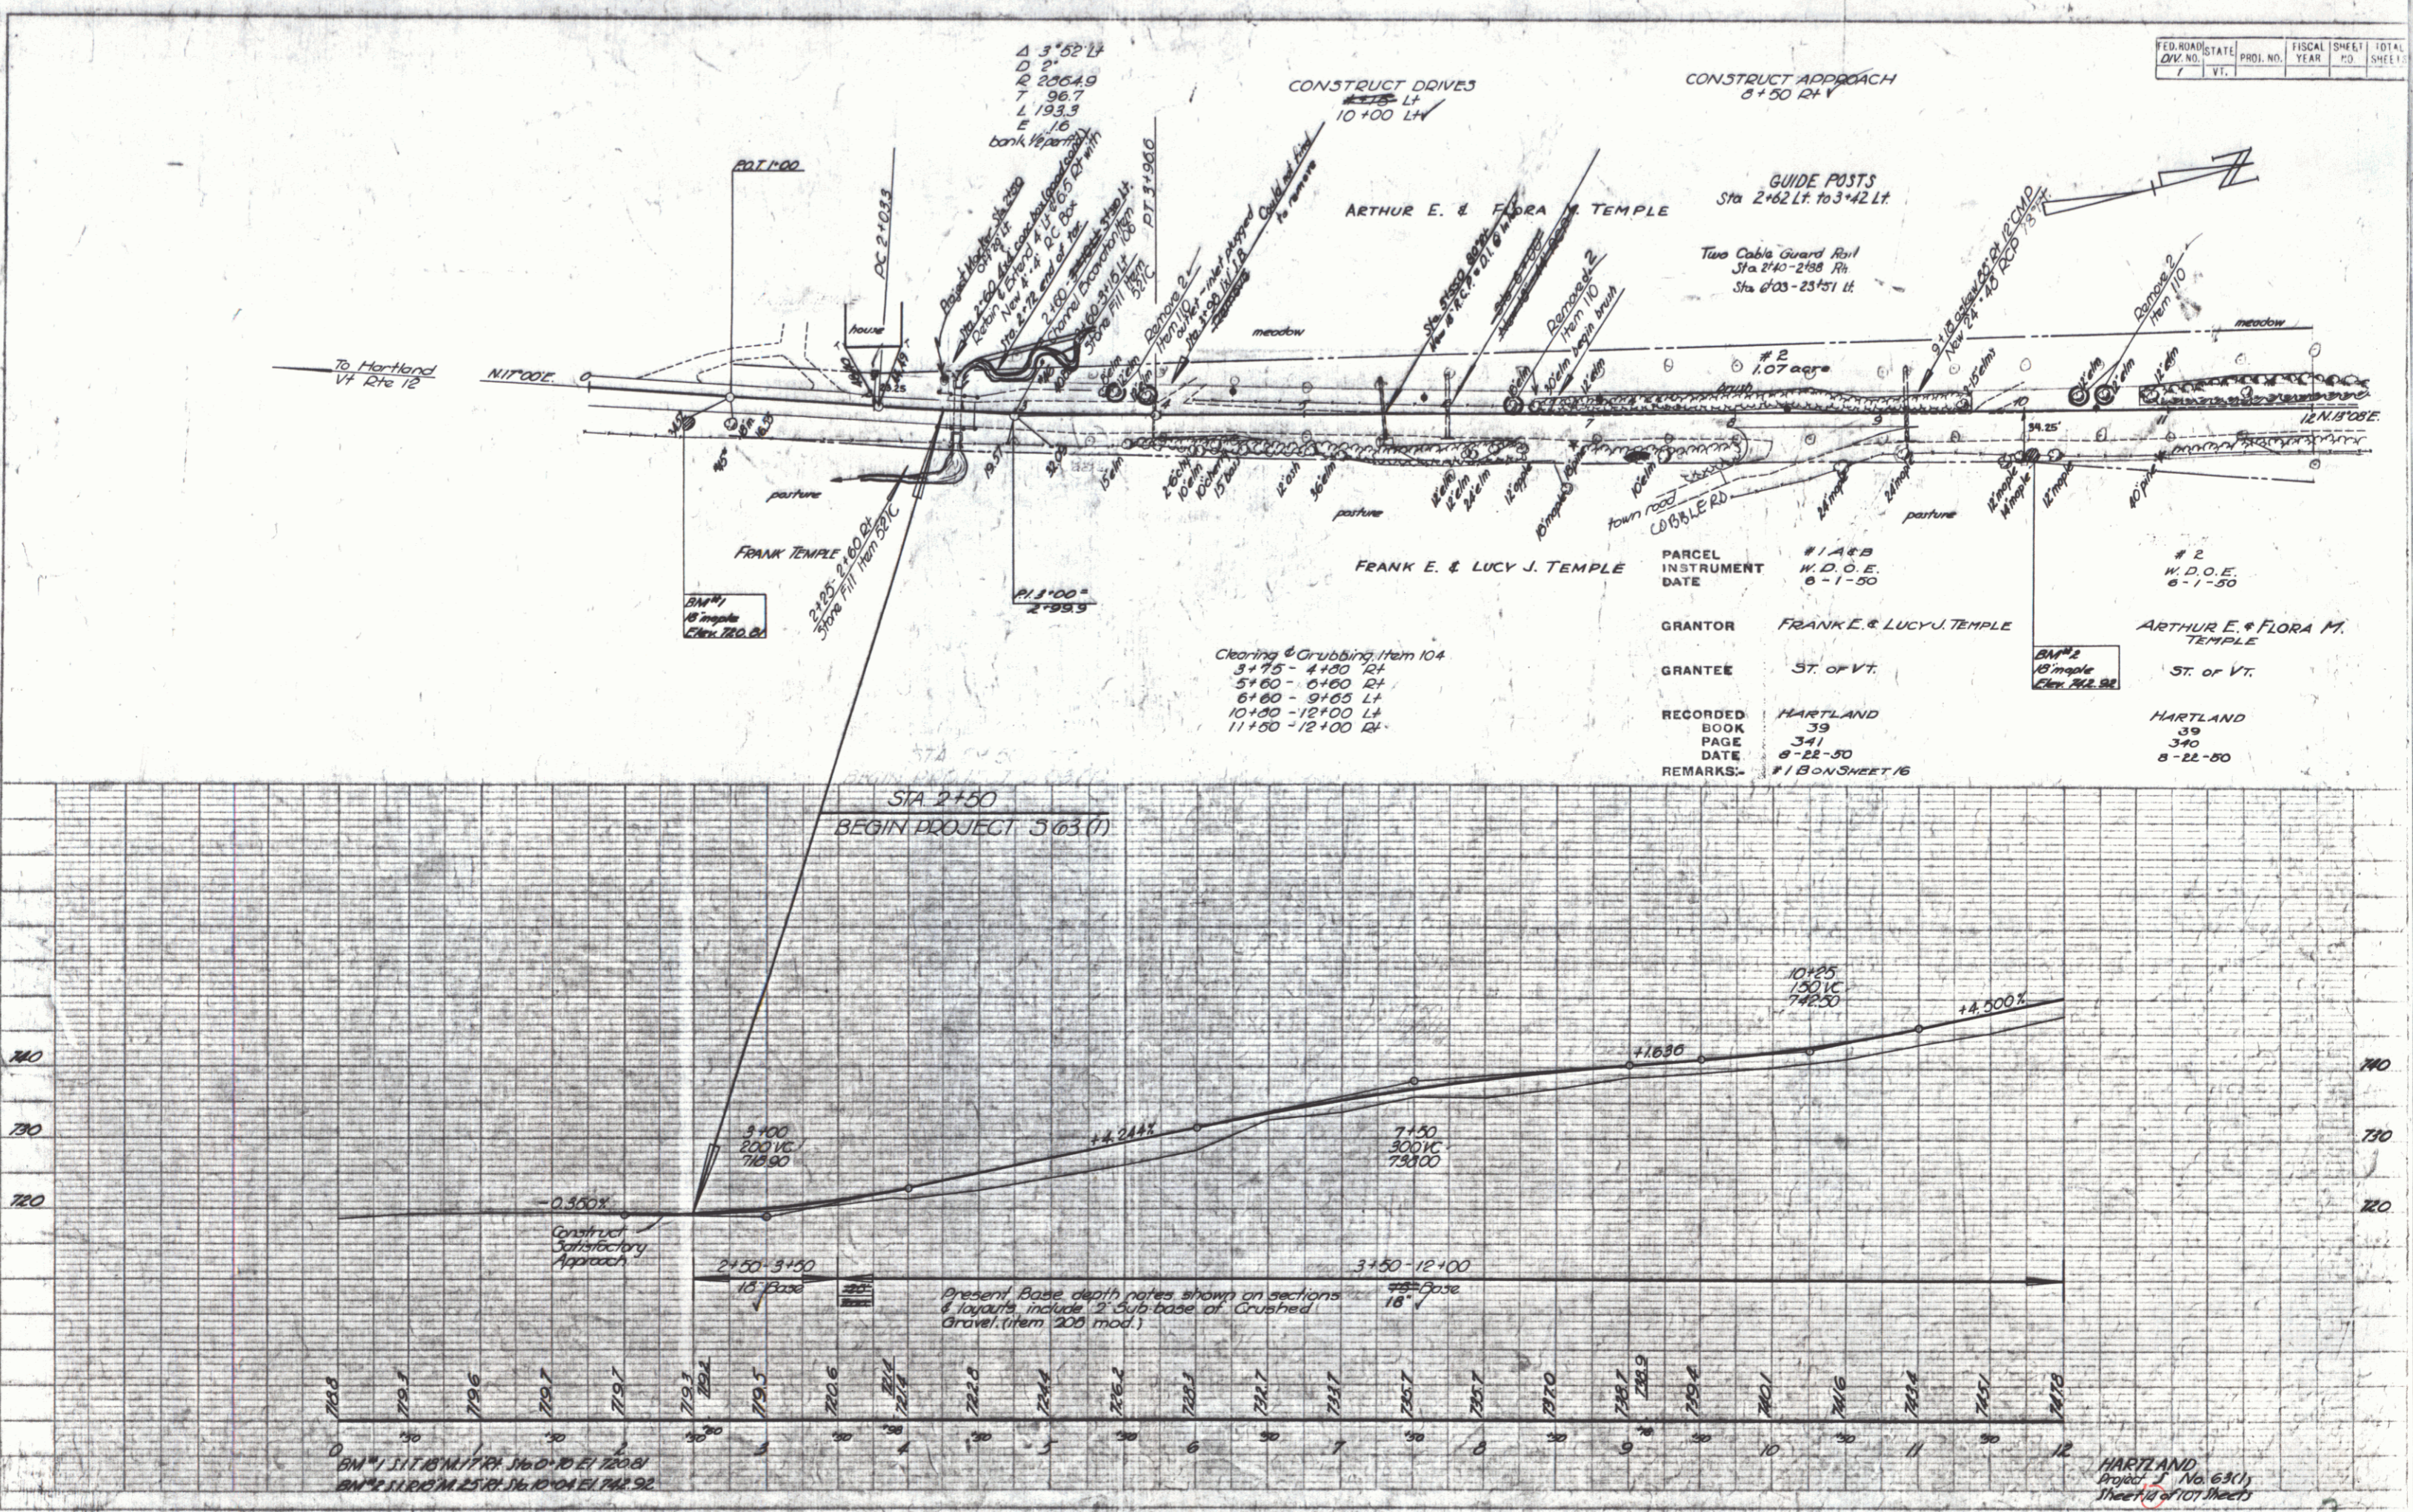

PARCEL INSTRUMENT DATE	#1 A & B W.D.O.E. 6-1-50	#2 W.D.O.E. 6-1-50
GRANTOR	FRANK E. & LUCY J. TEMPLE	ARTHUR E. & FLORA M. TEMPLE
GRANTEE	ST. OF VT.	ST. OF VT.
RECORDED BOOK PAGE DATE	HARTLAND 39 341 8-22-50	HARTLAND 39 340 8-22-50
REMARKS	#1 B ON SHEET 16	

Clearing & Grubbing Item 104
 3+75 - 4+00 RT
 10+00 - 12+00 LT
 11+50 - 12+00 RT

HARTLAND
