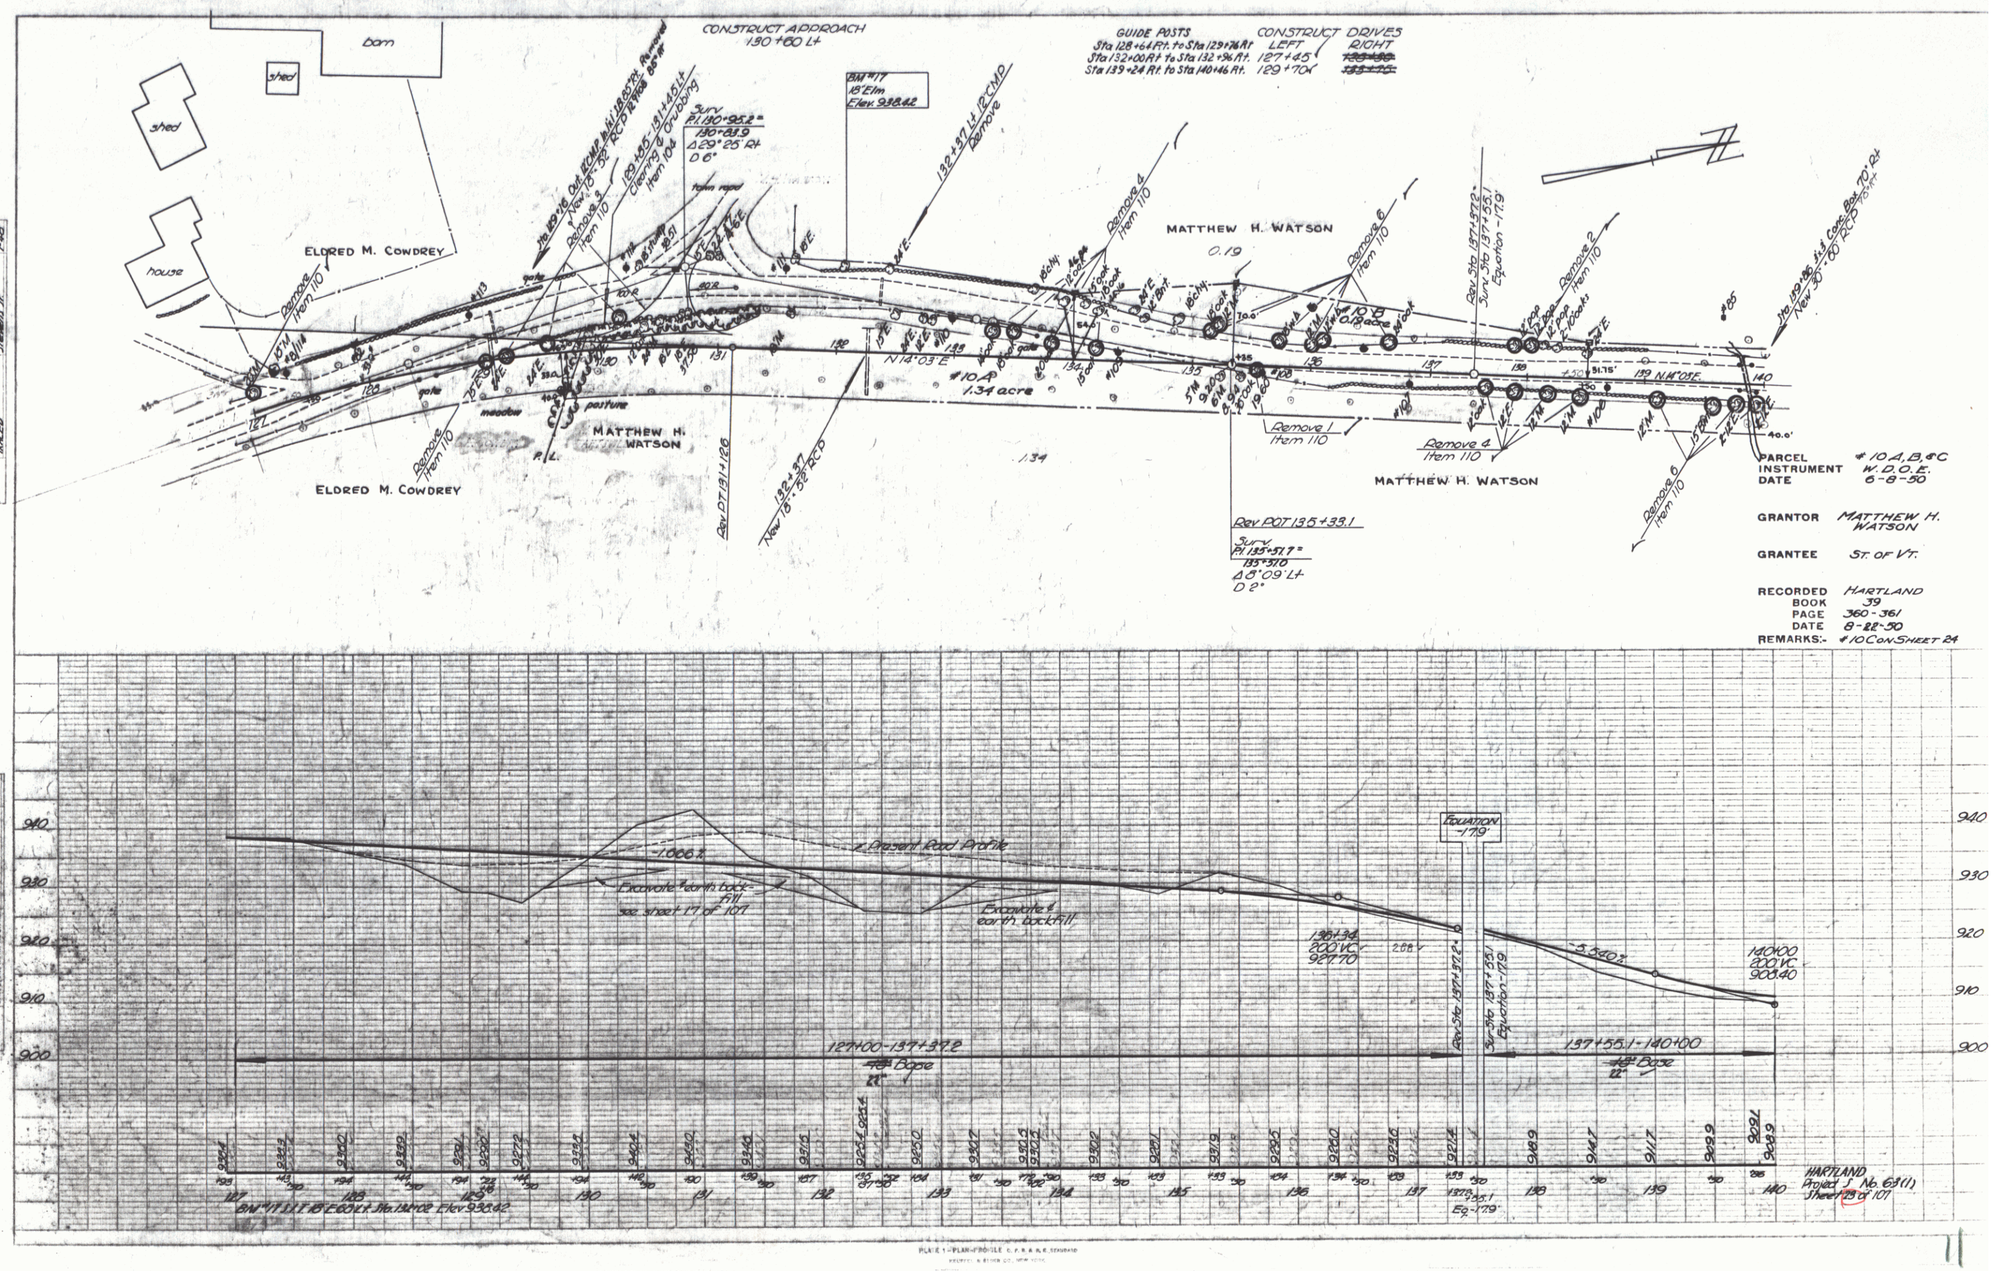

PARCEL #10 A, B, & C
INSTRUMENT W.D.O.E.
DATE 6-8-50

GRANTOR MATTHEW H. WATSON

GRANTEE ST. OF VT.

RECORDED HARTLAND
BOOK 39
PAGE 360-361
DATE 8-28-50
REMARKS:- #10 CON. SHEET 24

PLAN
NOTE BOOK
NO.
PRINTED
PLOTTED
ALIGNMENT CHECKED
PLAN CHECKED
Walker
Rodney Hood
Thomas Jr.
F.A.B.

PROFILE
NOTE BOOK
NO.
PRINTED
PLOTTED
GRADES CHECKED
PROFILE CHECKED
Walker
Thomas Jr.
6-28

PLATE 1 - PLAN-PROFILE C.P.R.R.A.R.E. STANDARD