FED. ROAD DIV. NO.	STATE	PROJ. NO.	FISCAL YEAR	SHEET NO.	TOTAL SHEETS
1	VT.				

PARCEL #11
INSTRUMENT W.D.O.E.
DATE 6-3-50

GRANTOR LEON D. & LENA B. ADAMS
GRANTEE ST. OF VT.
RECORDED HARTLAND
BOOK 39
PAGE 343
DATE 8-28-50
REMARKS

Δ 6°53' Lt
D 2°
R 2864.9
T 172.3
L 344.2
E 5.2
bank 1½ per ft

CONSTRUCT APPROACH 150+75 Rt

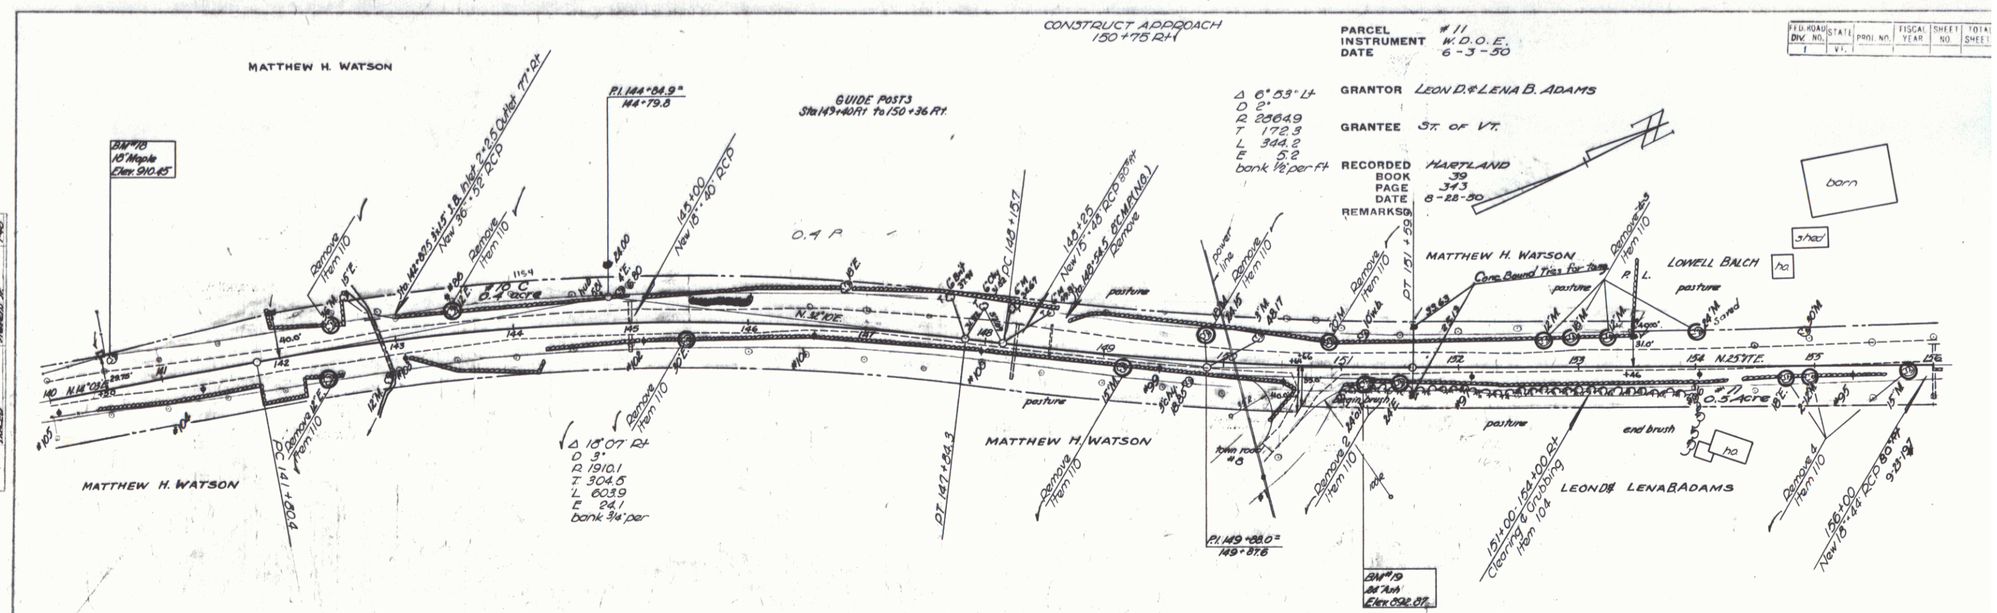

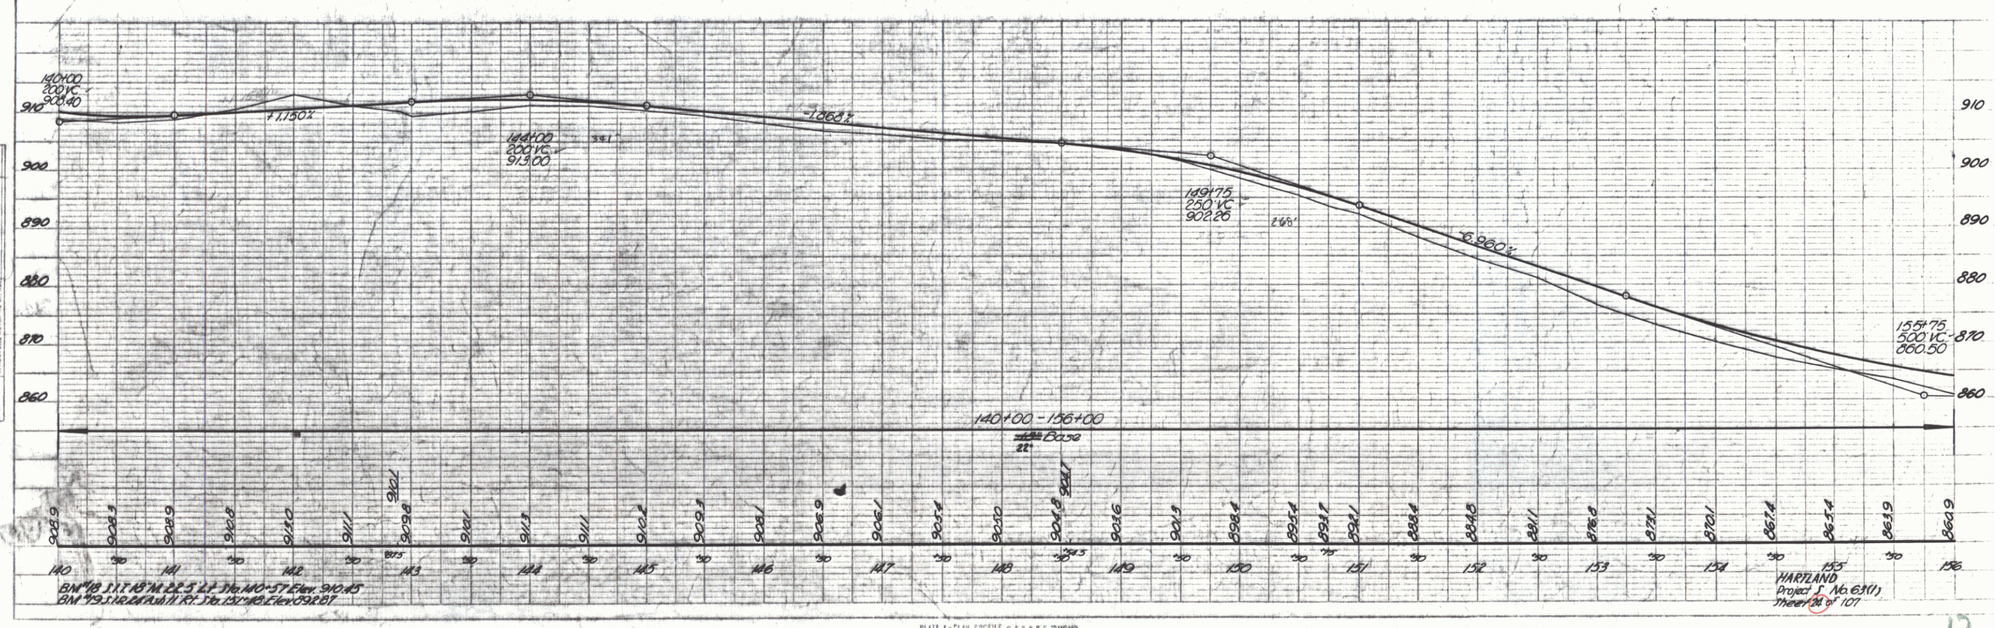

PLAN
Submitted
Plotted
Note Book
Checked
Approved
Date 8-28-50
Scale 1" = 40'

PROFILE
Submitted
Plotted
Note Book
Checked
Approved
Date 8-28-50
Scale 1" = 40' Horiz. 1" = 10' Vert.

HARTLAND
Project F No. 63(1)
Sheet 28 of 107

PLATE 1 - PLAN PROFILE G.P.R. & R.C. STANDARD

12