FED. ROAD DIV. NO.	STATE	PROJ. NO.	FISCAL YEAR	SHEET NO.	TOTAL SHEETS
1	VT.				

CONSTRUCT DRIVES
LT. 191+50
RT. 186+65, 189+50

CLEARING AND GRUBBING, ITEM 104
189+00 - 190+90 LT. & RT.
195+30 - 197+00 LT. & RT.

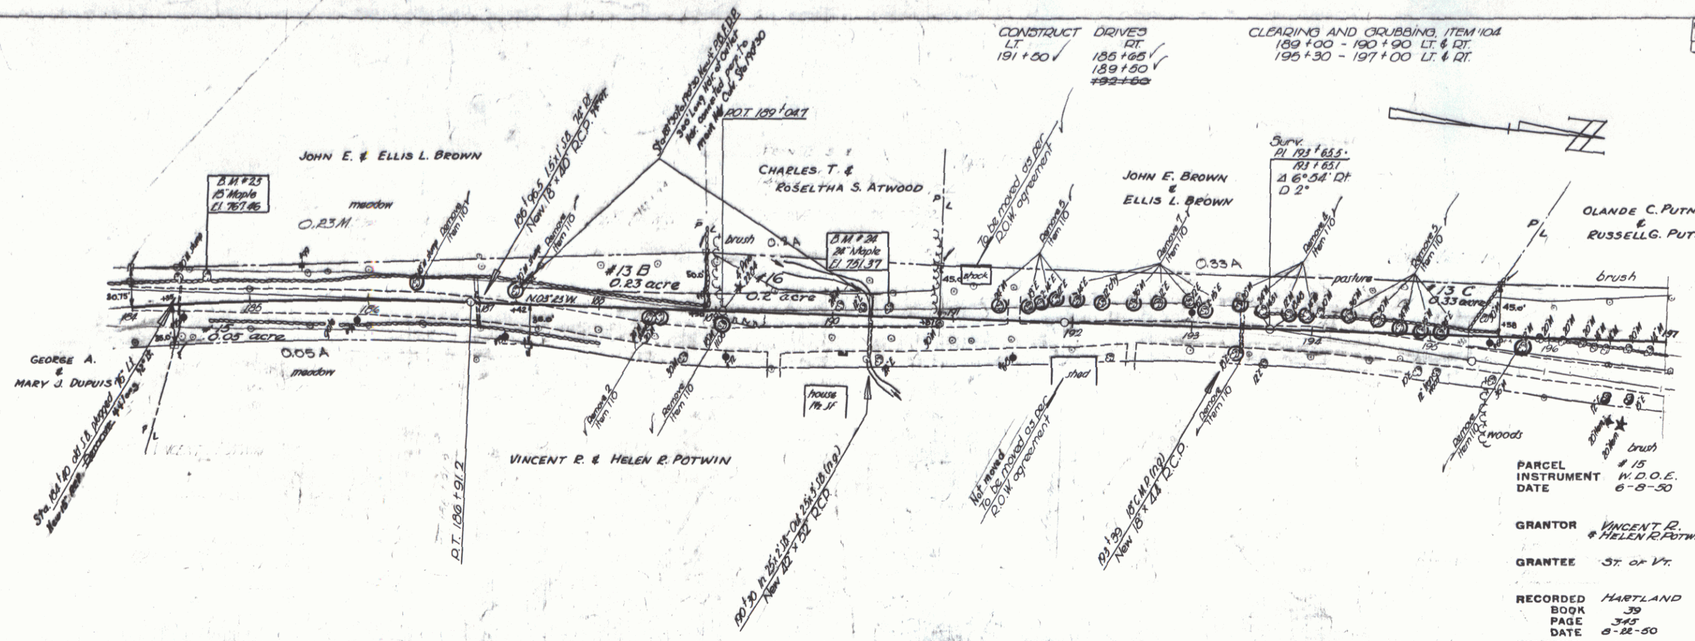

PARCEL	#15	#16
INSTRUMENT	W.D.O.E.	W.D.O.E.
DATE	6-8-50	6-2-50
GRANTOR	VINCENT R. & HELEN R. POTWIN	CHARLES T. & ROSELTHA S. ATWOOD
GRANTEE	ST. OF VT.	ST. OF VT.
RECORDED BOOK	HARTLAND 39	HARTLAND 39
PAGE	343	364
DATE	8-22-50	8-22-50

REMARKS:-

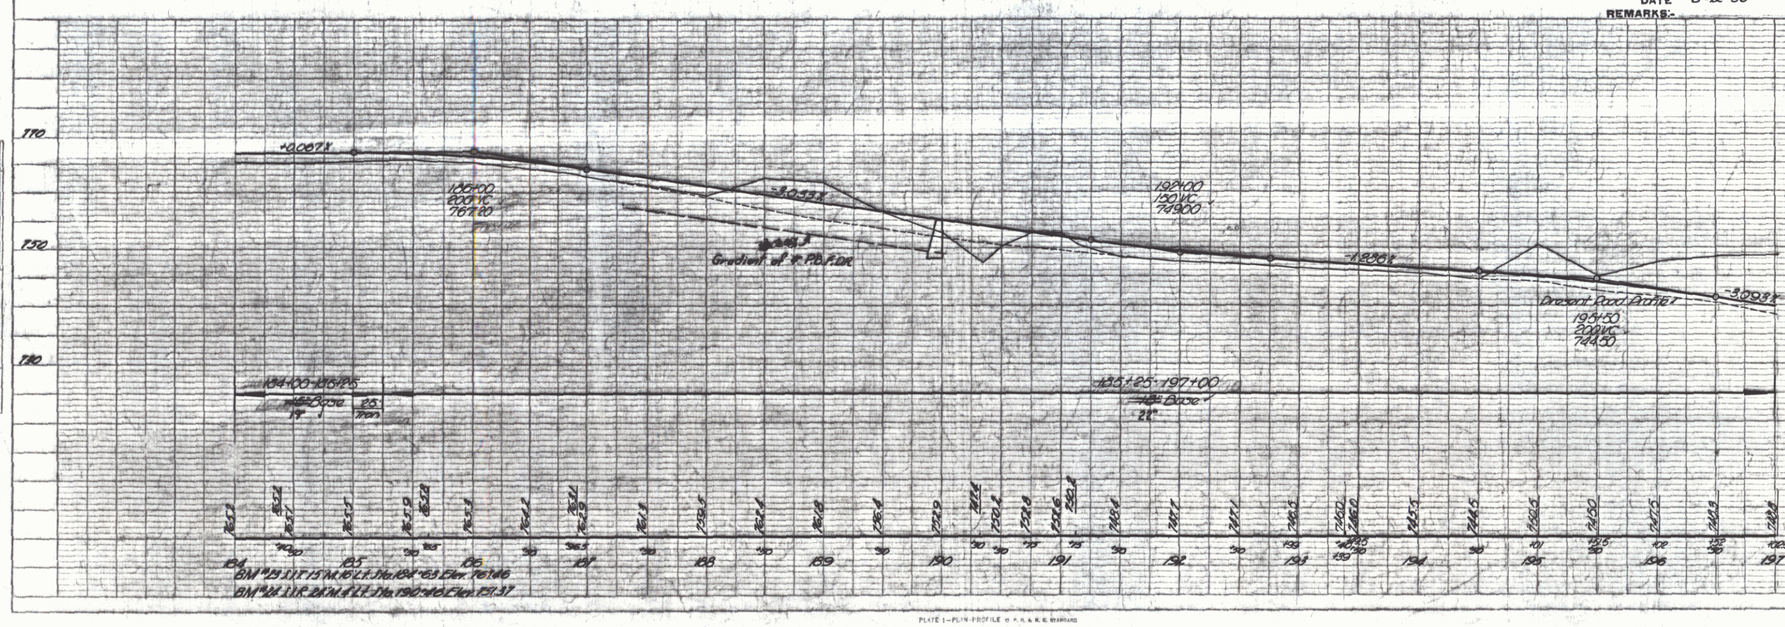

HARTLAND
Project F No. 6311
Sheet 17 of 107

15

