


FED. ROAD DIST. NO.	STATE	PROJ. NO.	FISCAL YEAR	SHEET NO.	TOTAL SHEETS
F	VT.				

PARCEL #20 B
 INSTRUMENT W.D.O.E.
 DATE 9-8-92
 GRANTOR ELIZABETH L. MORRILL
 GRANTEE ST. OF VT.
 RECORD'D HARTLAND Drive Constructed
 BOOK 39 23870 #
 PAGE 881
 DATE 9-11-52
 REMARKS

GUIDE POSTS
 Sta 228+32 Rt. to Sta 232+52 Rt.
 TWO CABLE GUARD RAIL
 Sta 232+50 Rt. to Sta 237+76 Rt.
 Sta 238+18 Rt. to Sta 240+64 Rt.

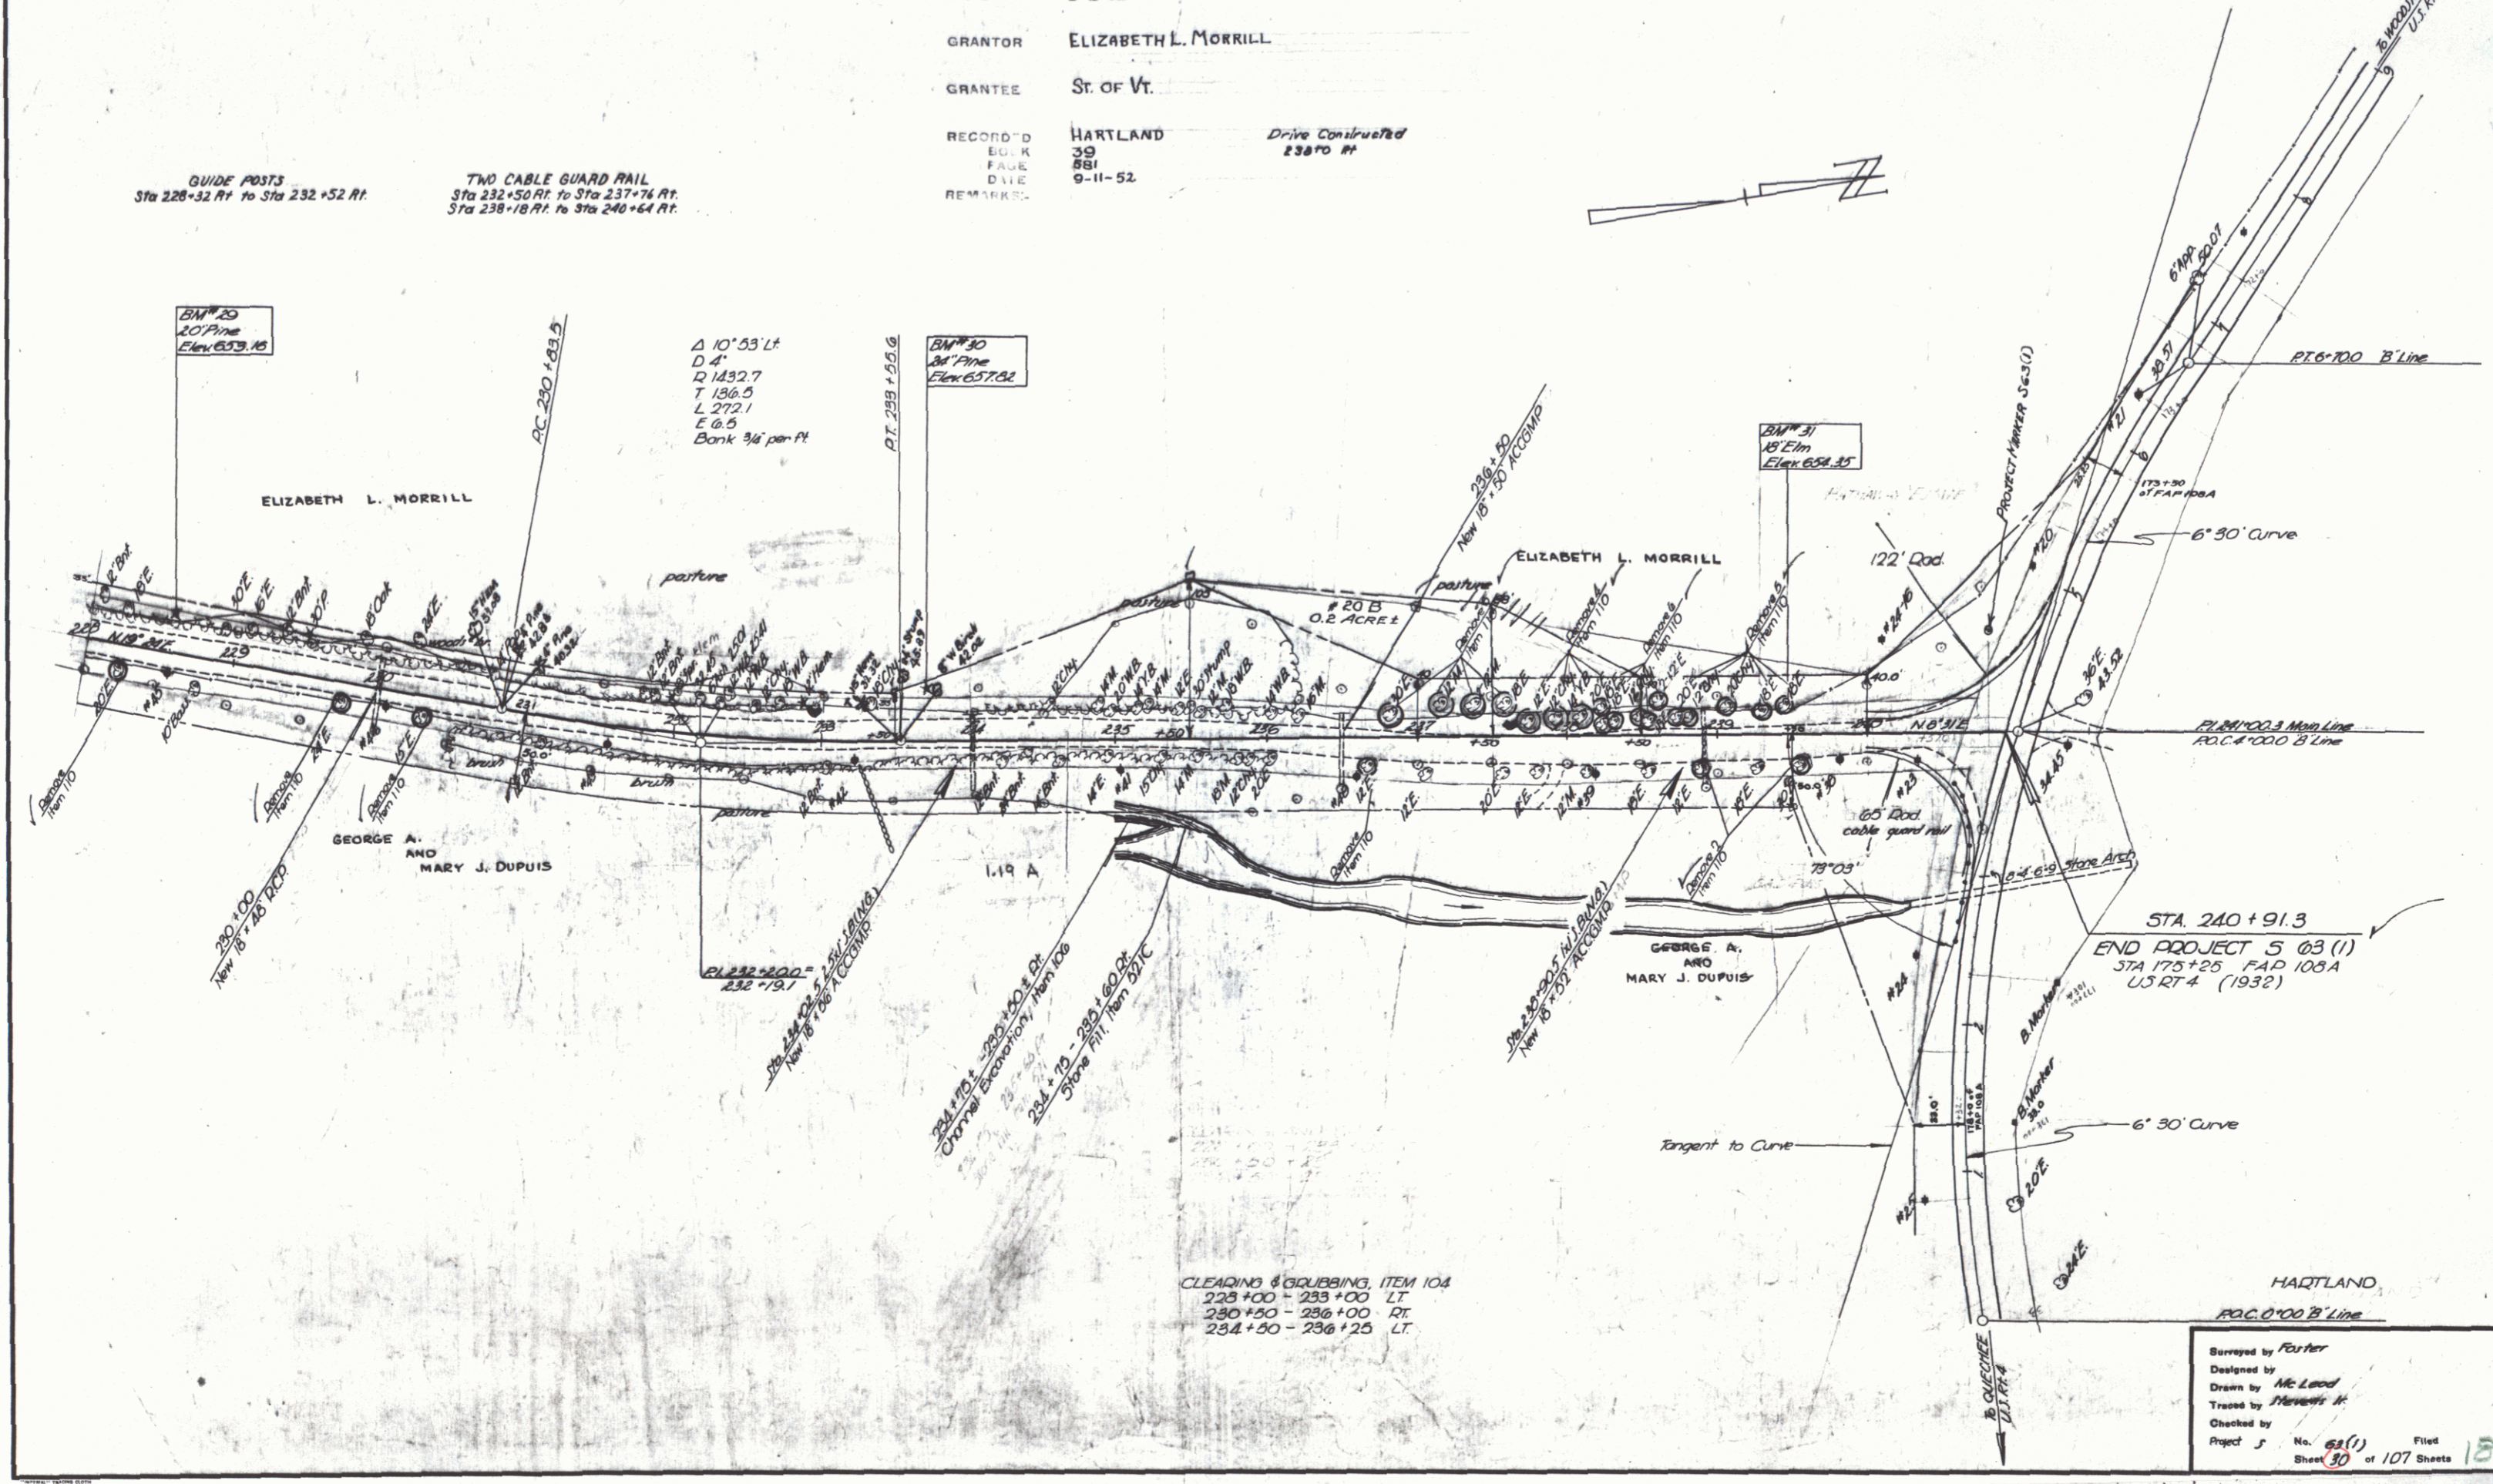

HARTLAND
 R.O.C. 0+00 B' Line
 Surveyed by Foster
 Designed by
 Drawn by McLeod
 Traced by Stewart H.
 Checked by
 Project J No. 63(1) Filed
 Sheet 30 of 107 Sheets 13