E-1088 1932 4

Wood. Guide Posts Required		
Sta.	Left	Right
6+27	-	1
8+98	-	1

New Trans. Conc. Pipe Culverts Required				
Sta.	Dia.	Leng.	Conc. Pipe	Steel
6+27	15"	36'	20 ft.	189'
8+98	15"	36'	24	222'

Cable Guard Rail Required			
Station	Leng.	Cent.	Cy-leng.
2+20-10+00 Lt.	830'	40'	620'

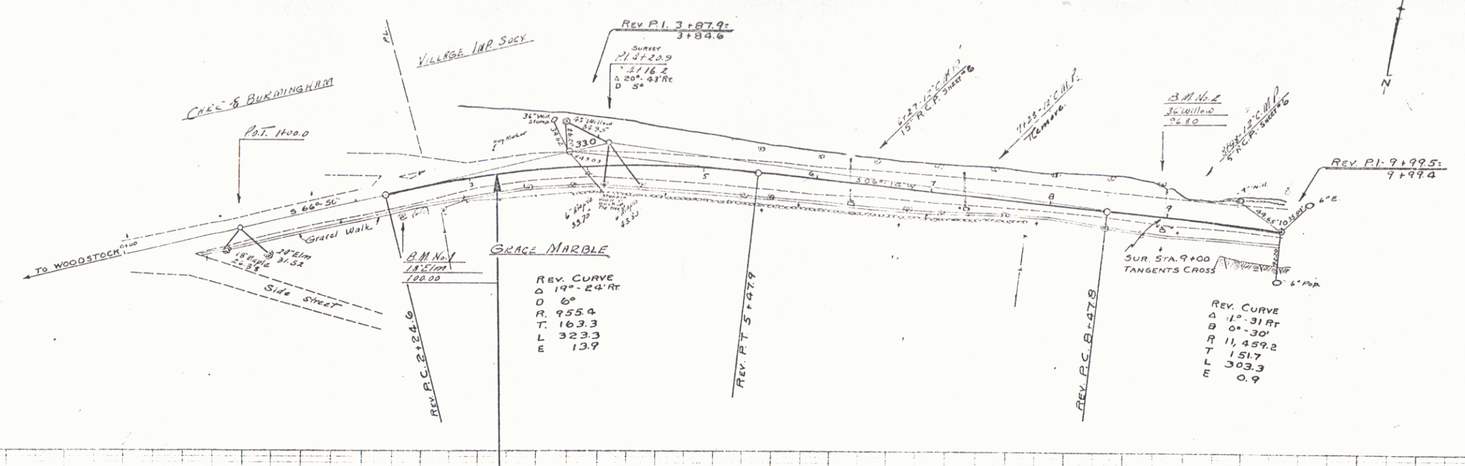

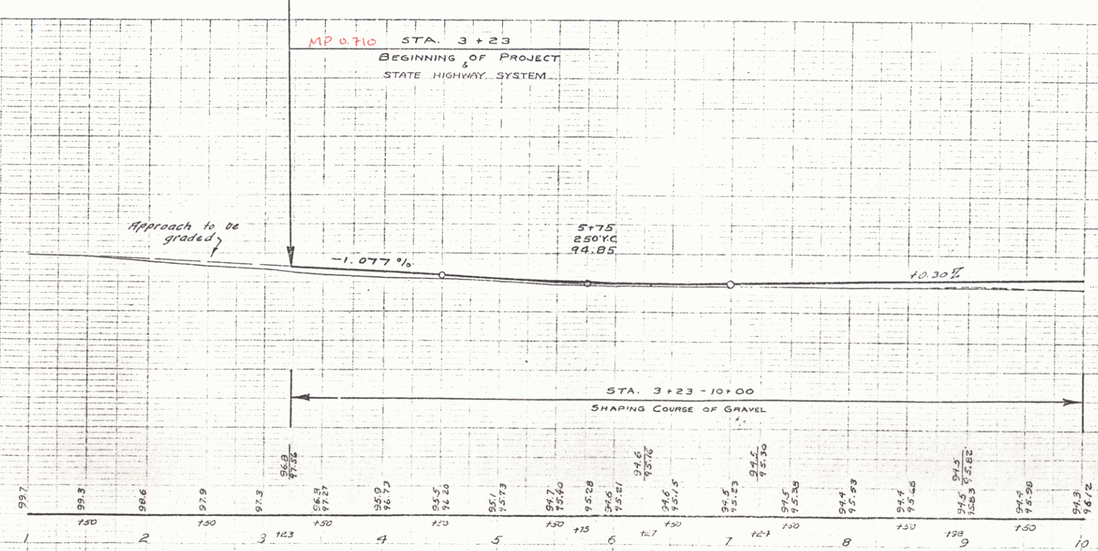

R+C VT12

1/1/32

Pin # 99R928

Project No. E-108B

Town of Woodstock

MM0073-0083

Series E No. E-1088
Sheet 6 of 10