FED. ROAD DIST. NO.	STATE	FED. AID PROJ. NO.	FISCAL YEAR	SHEET NO.	TOTAL SHEETS
9	VT.		1937	2	26

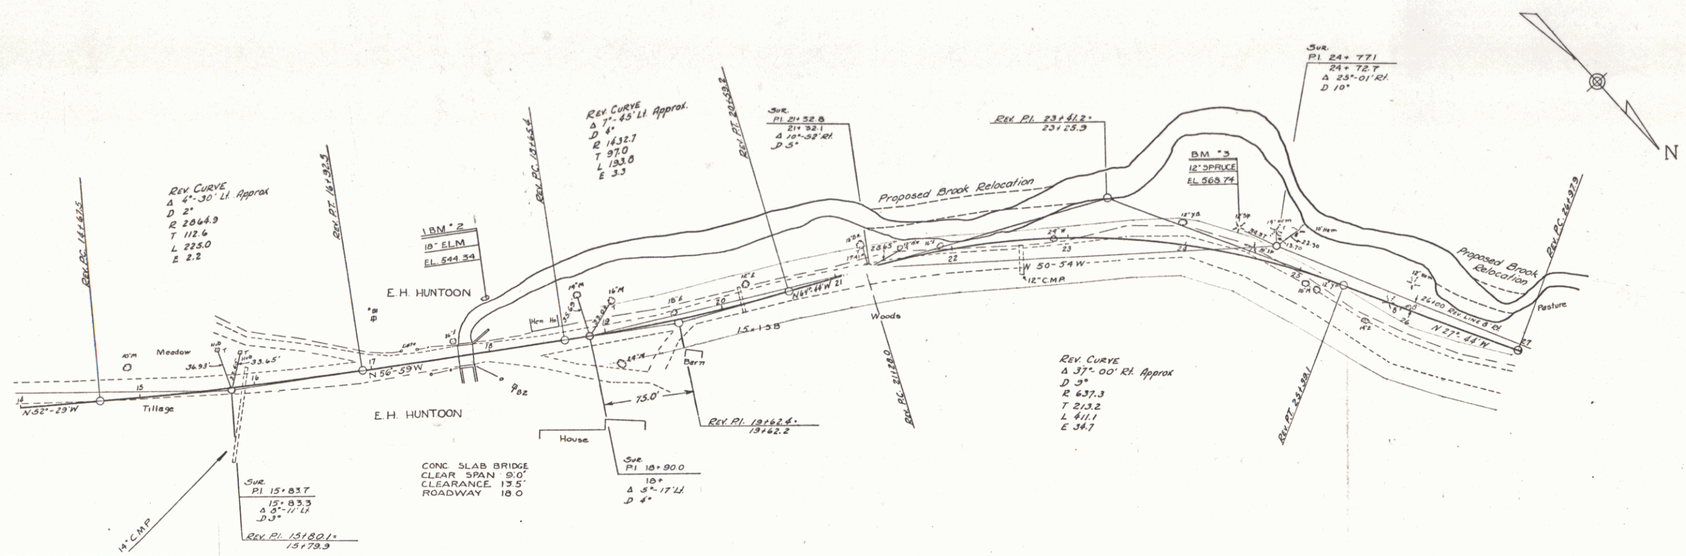

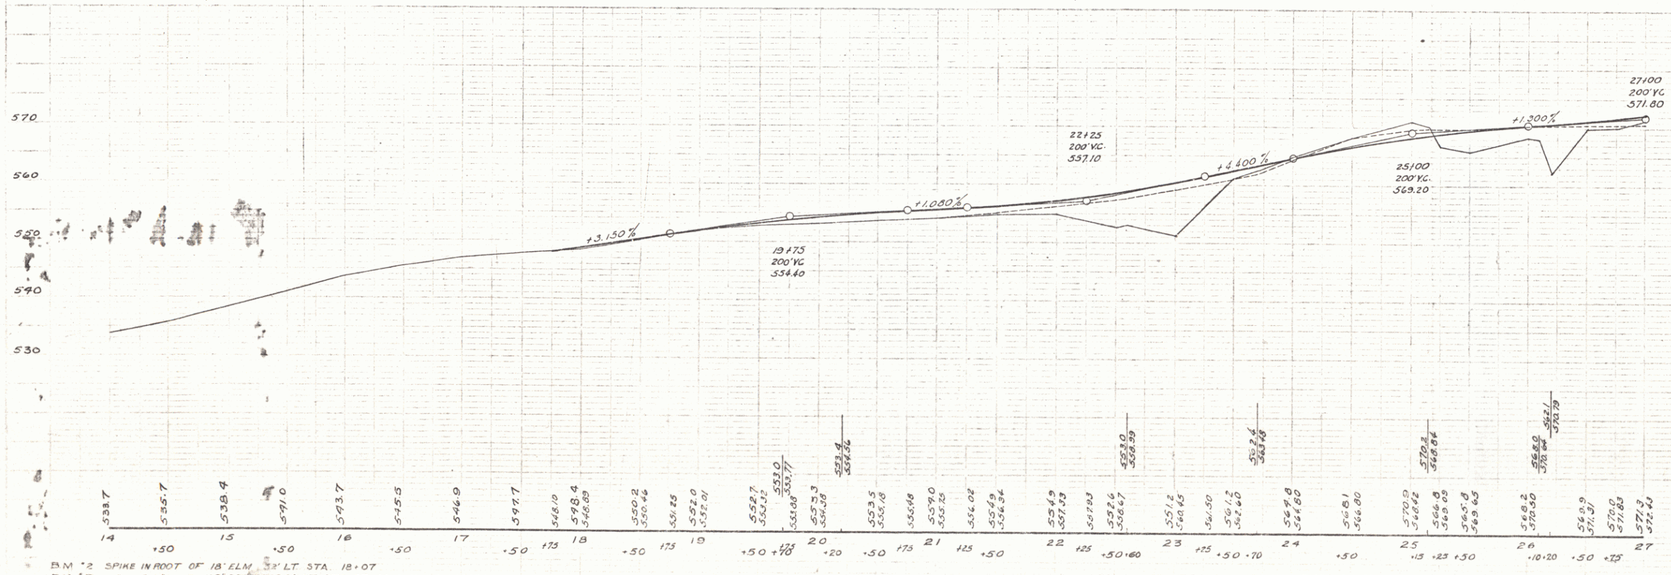

TOWN OF BARNARD
SHEET 2 OF 26 SHEETS

2