


11-53
11-54
11-55
Spanning
C. & R. Tree
24+60 LT

11-53
11-54
11-55
Spanning
C. & R. Tree
24+60 LT

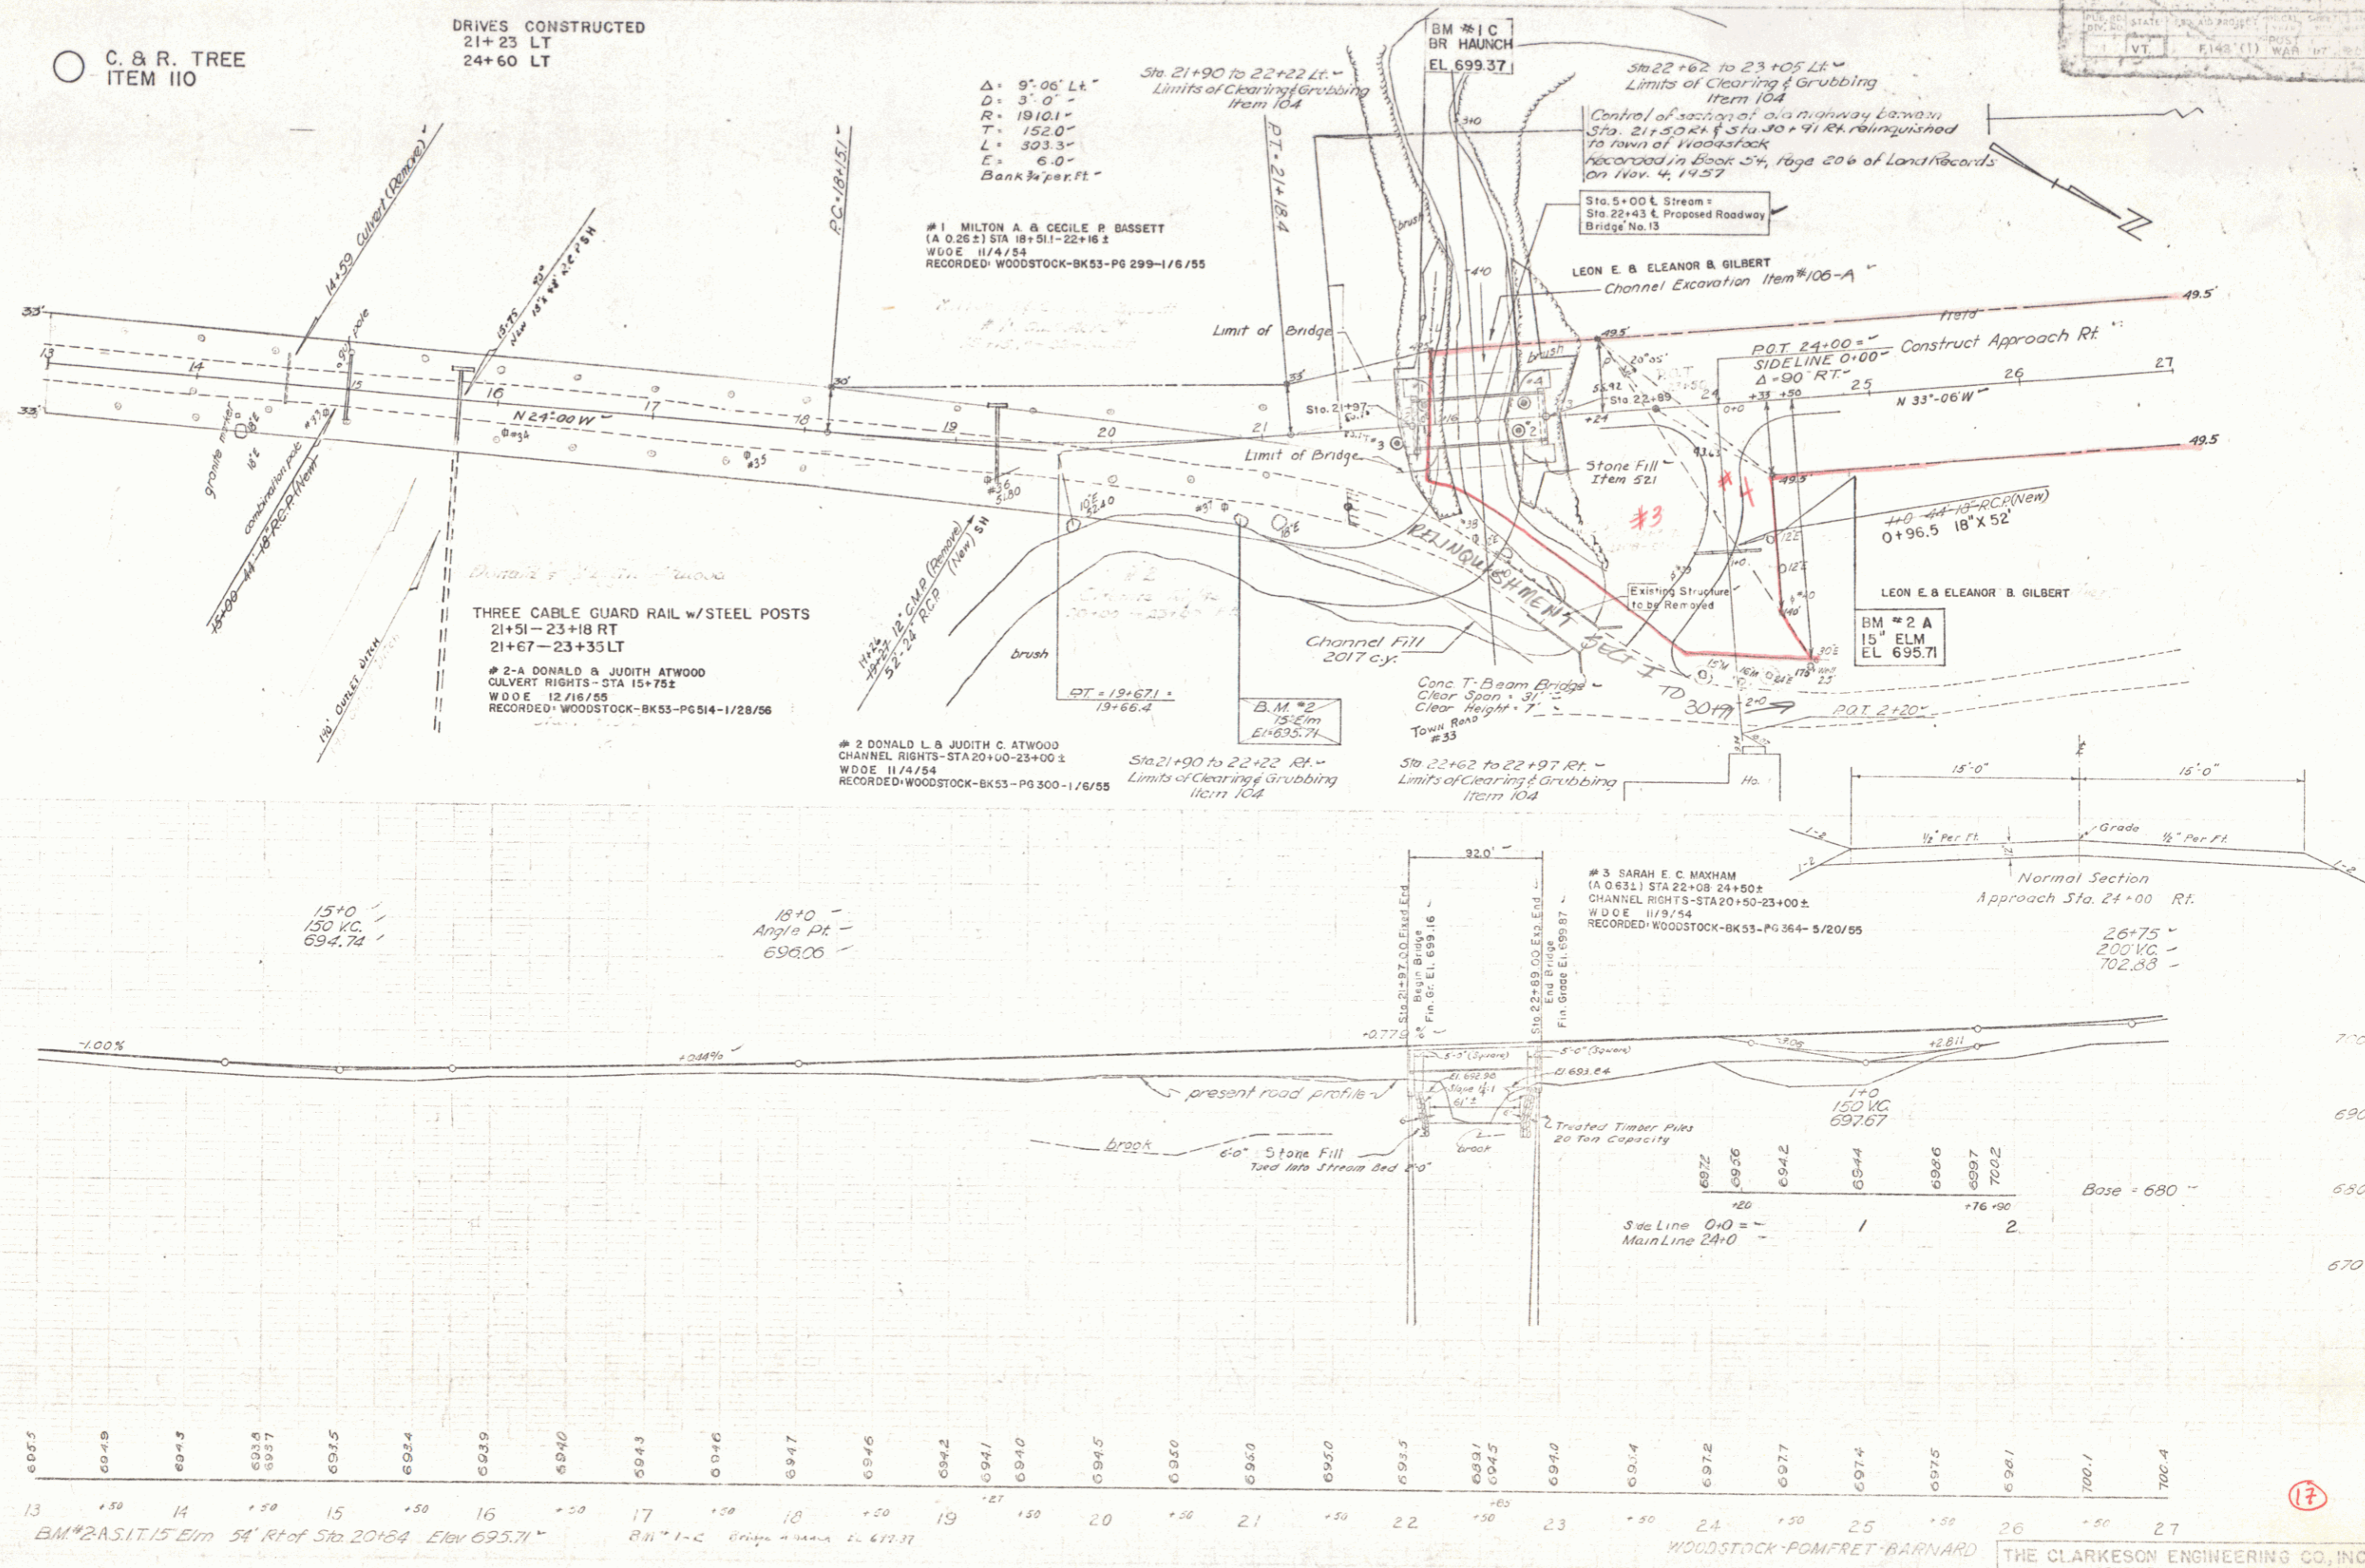

13 +.50 14 +.50 15 +.50 16 +.50 17 +.50 18 +.50 19 +.50 20 +.50 21 +.50 22 +.50 23 +.50 24 +.50 25 +.50 26 +.50 27

BM #2 A S.I.T. 15' Elm 54' Rt of Sta 20184 Elev 695.71' RN # 1-2 Bridge 20184 EL 695.37

WOODSTOCK-POMFRET-BARNARD THE CLARKESON ENGINEERING CO., INC. CONSULTING ENGINEERS BOSTON MASSACHUSETTS

17

3