PUB. ROD. DIV. NO.	STATE	FED. AID PROJECT NO.	SHEET NO.	TOTAL SHEETS
1	VT.	F142(1)	POST WAR NB 205	

C. & R. TREE
ITEM 110

THREE CABLE GUARD RAIL W/STEEL POSTS
29+0 – 32+52 LT
33+50 – 39+68 LT

STEEL GUIDE POSTS
29+0 – 30+0 RT

DRIVES CONSTRUCTED
28 + 27 RT
31 + 0 RT
36 + 50 RT

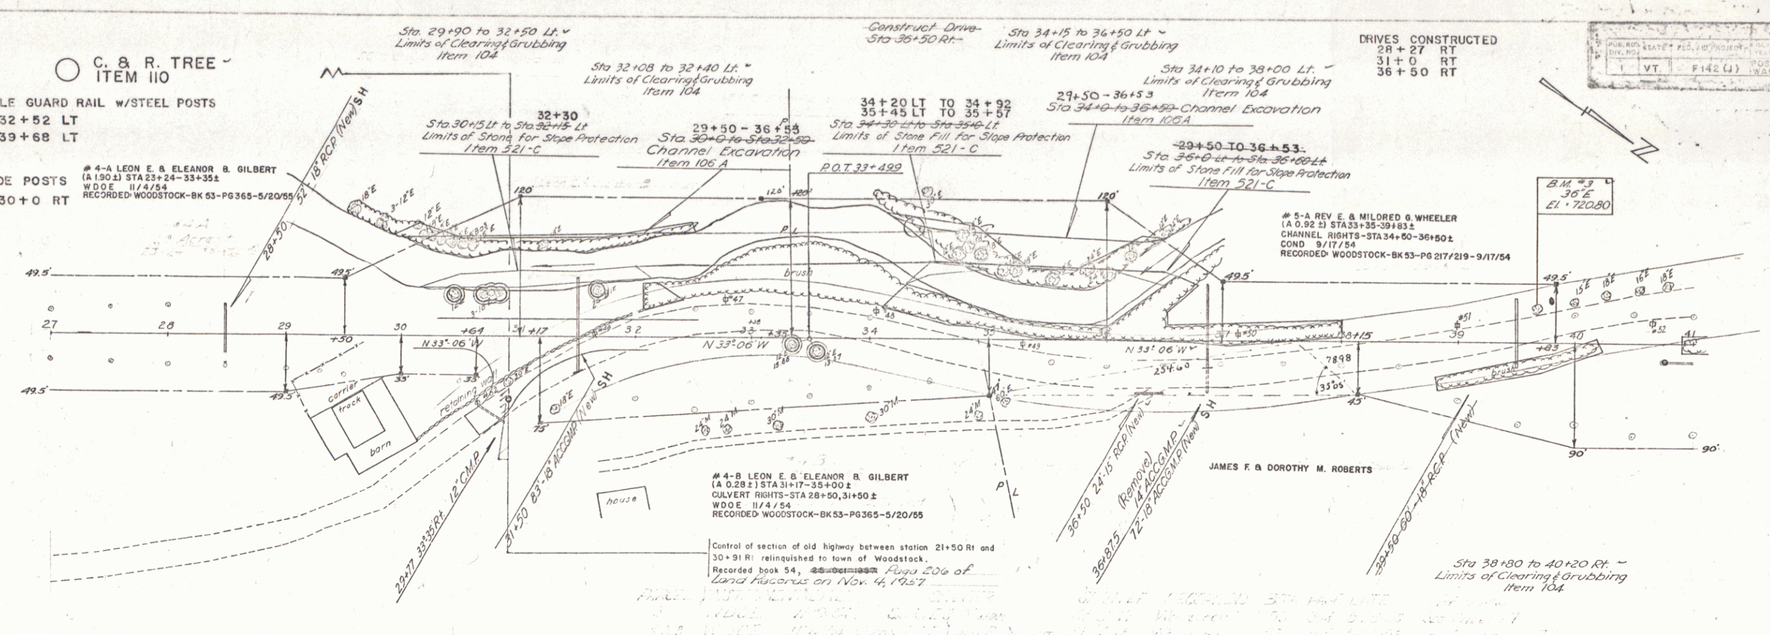

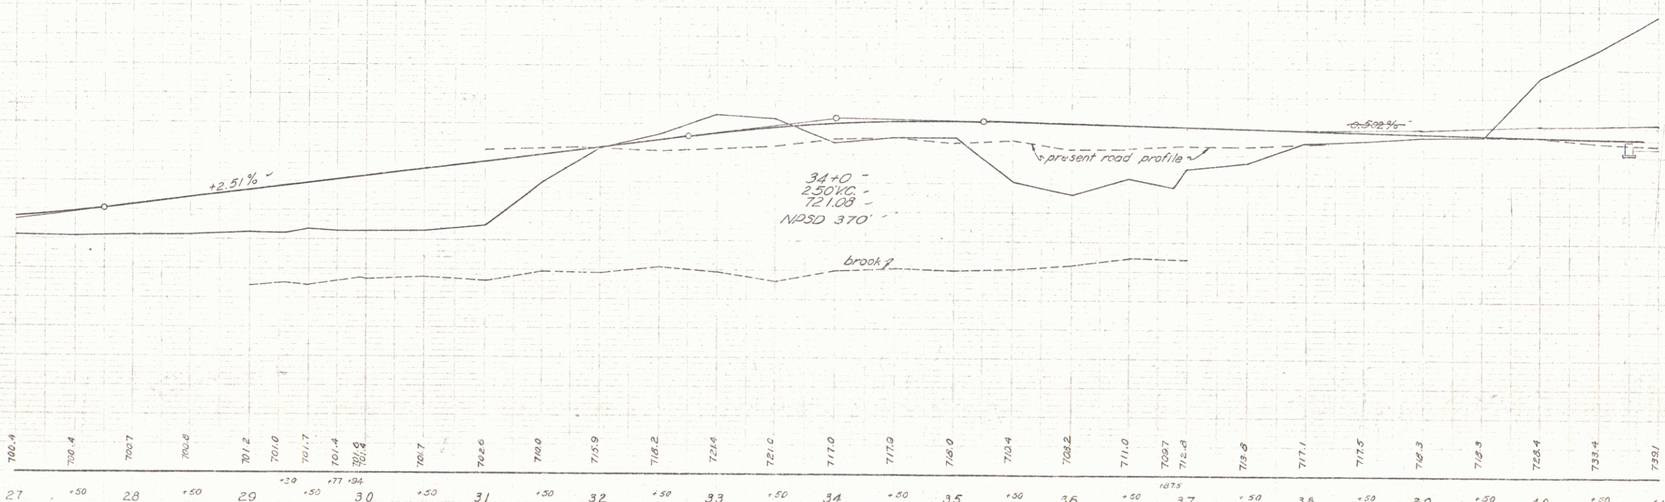

WOODSTOCK-POMFRET-BARNARD

THE CLARKESON ENGINEERING CO., INC.
CONSULTING ENGINEERS
BOSTON MASSACHUSETTS

18

4