| PUB. RD. DIV. NO. | STATE | FED. AID PROJECT | FISCAL YEAR | POST NO. | SHEET NO. |
|---|---|---|---|---|---|
| 1 | VT. | F 142 (1) | POST WAR | 80. | 208 |

C. & R. TREE
ITEM 110

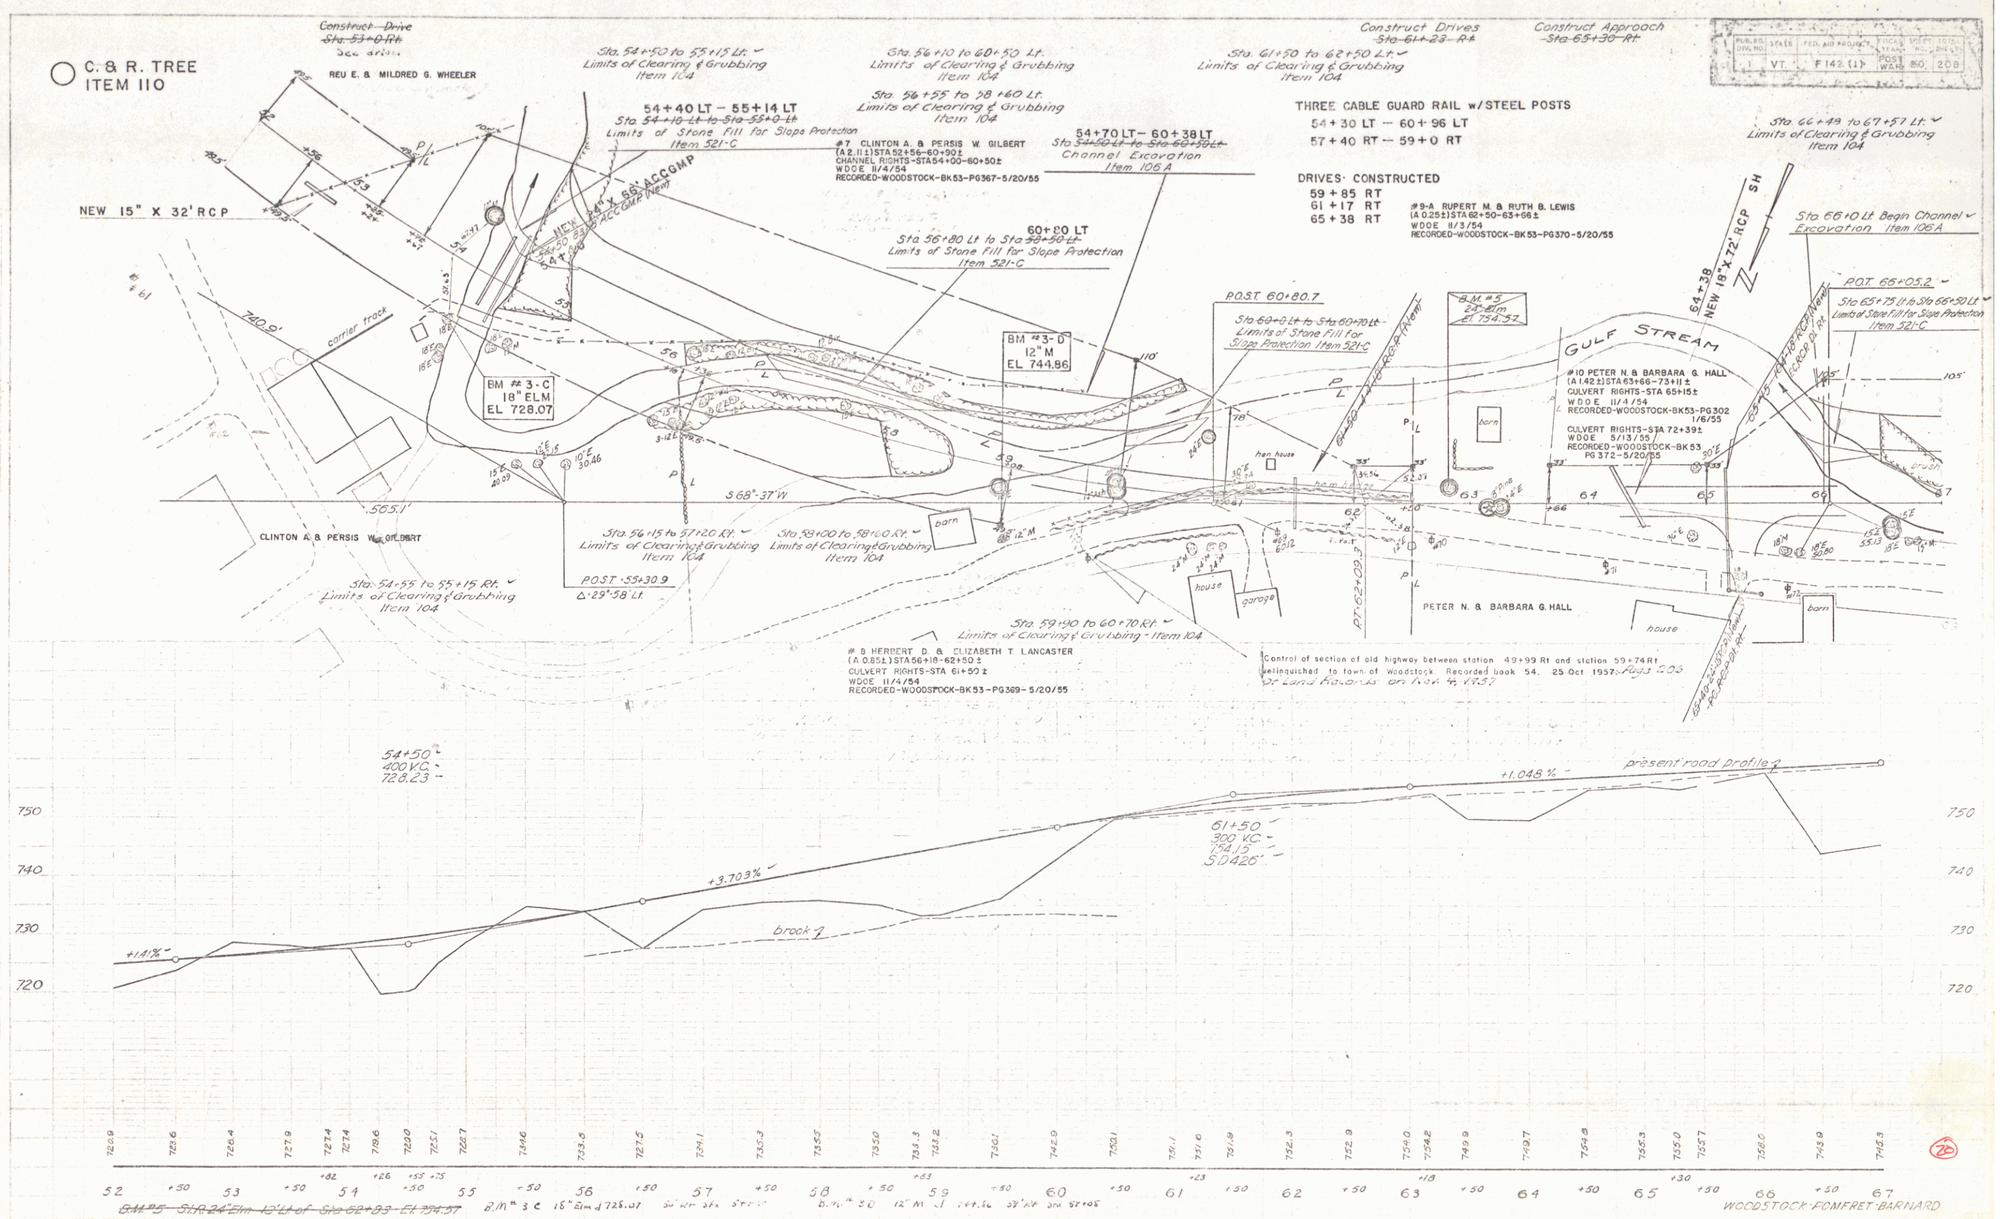


THE CLARKESON ENGINEERING CO., INC.
CONSULTING ENGINEERS
BOSTON MASSACHUSETTS

6