PUB. RD. DIV. NO.	STATE	FED. AID PROJECT	FISCAL YEAR	SHEET NO.	TOTAL SHEETS
1	VT.	F 142 (1)	POST WAR	22	208

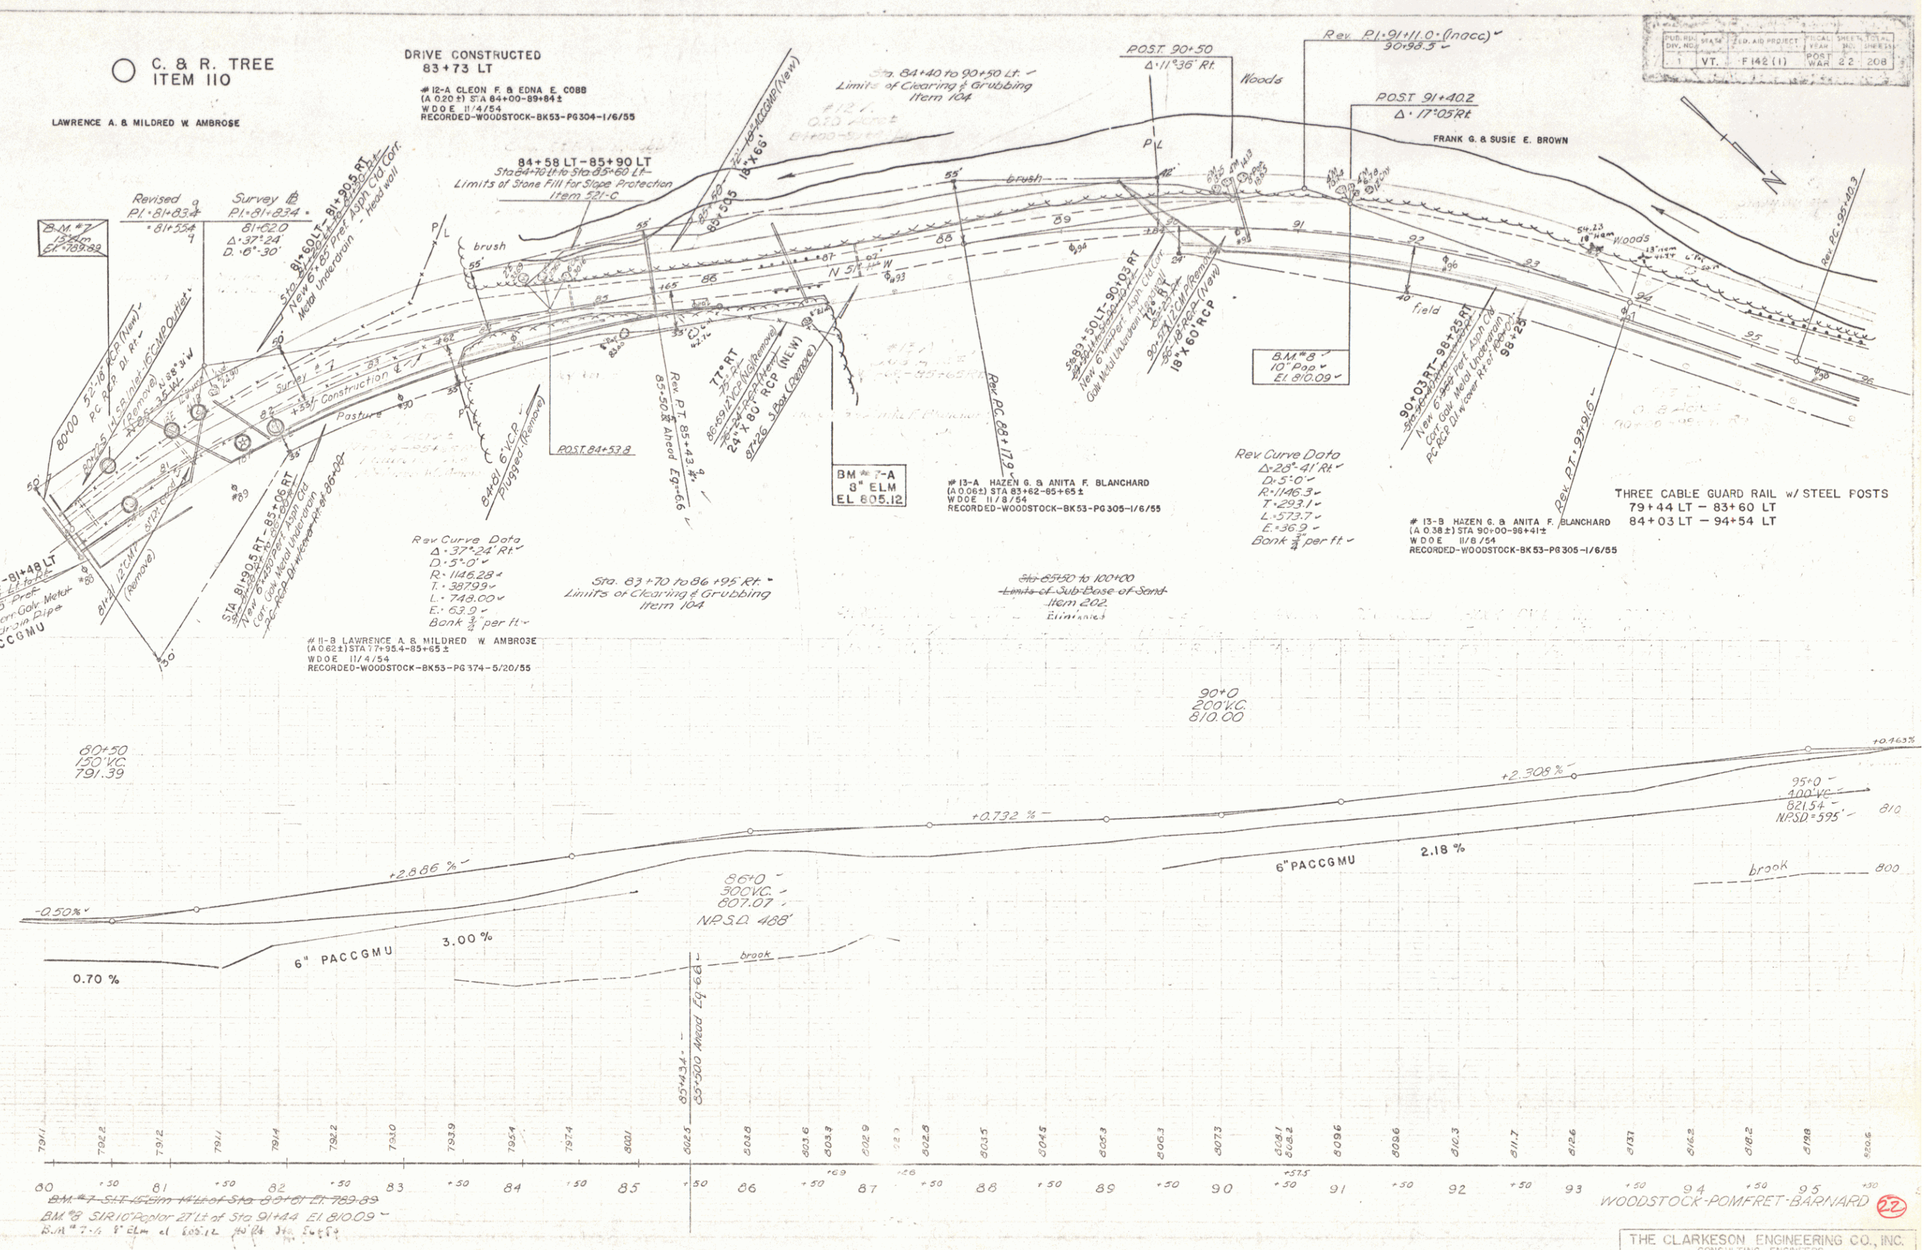

8