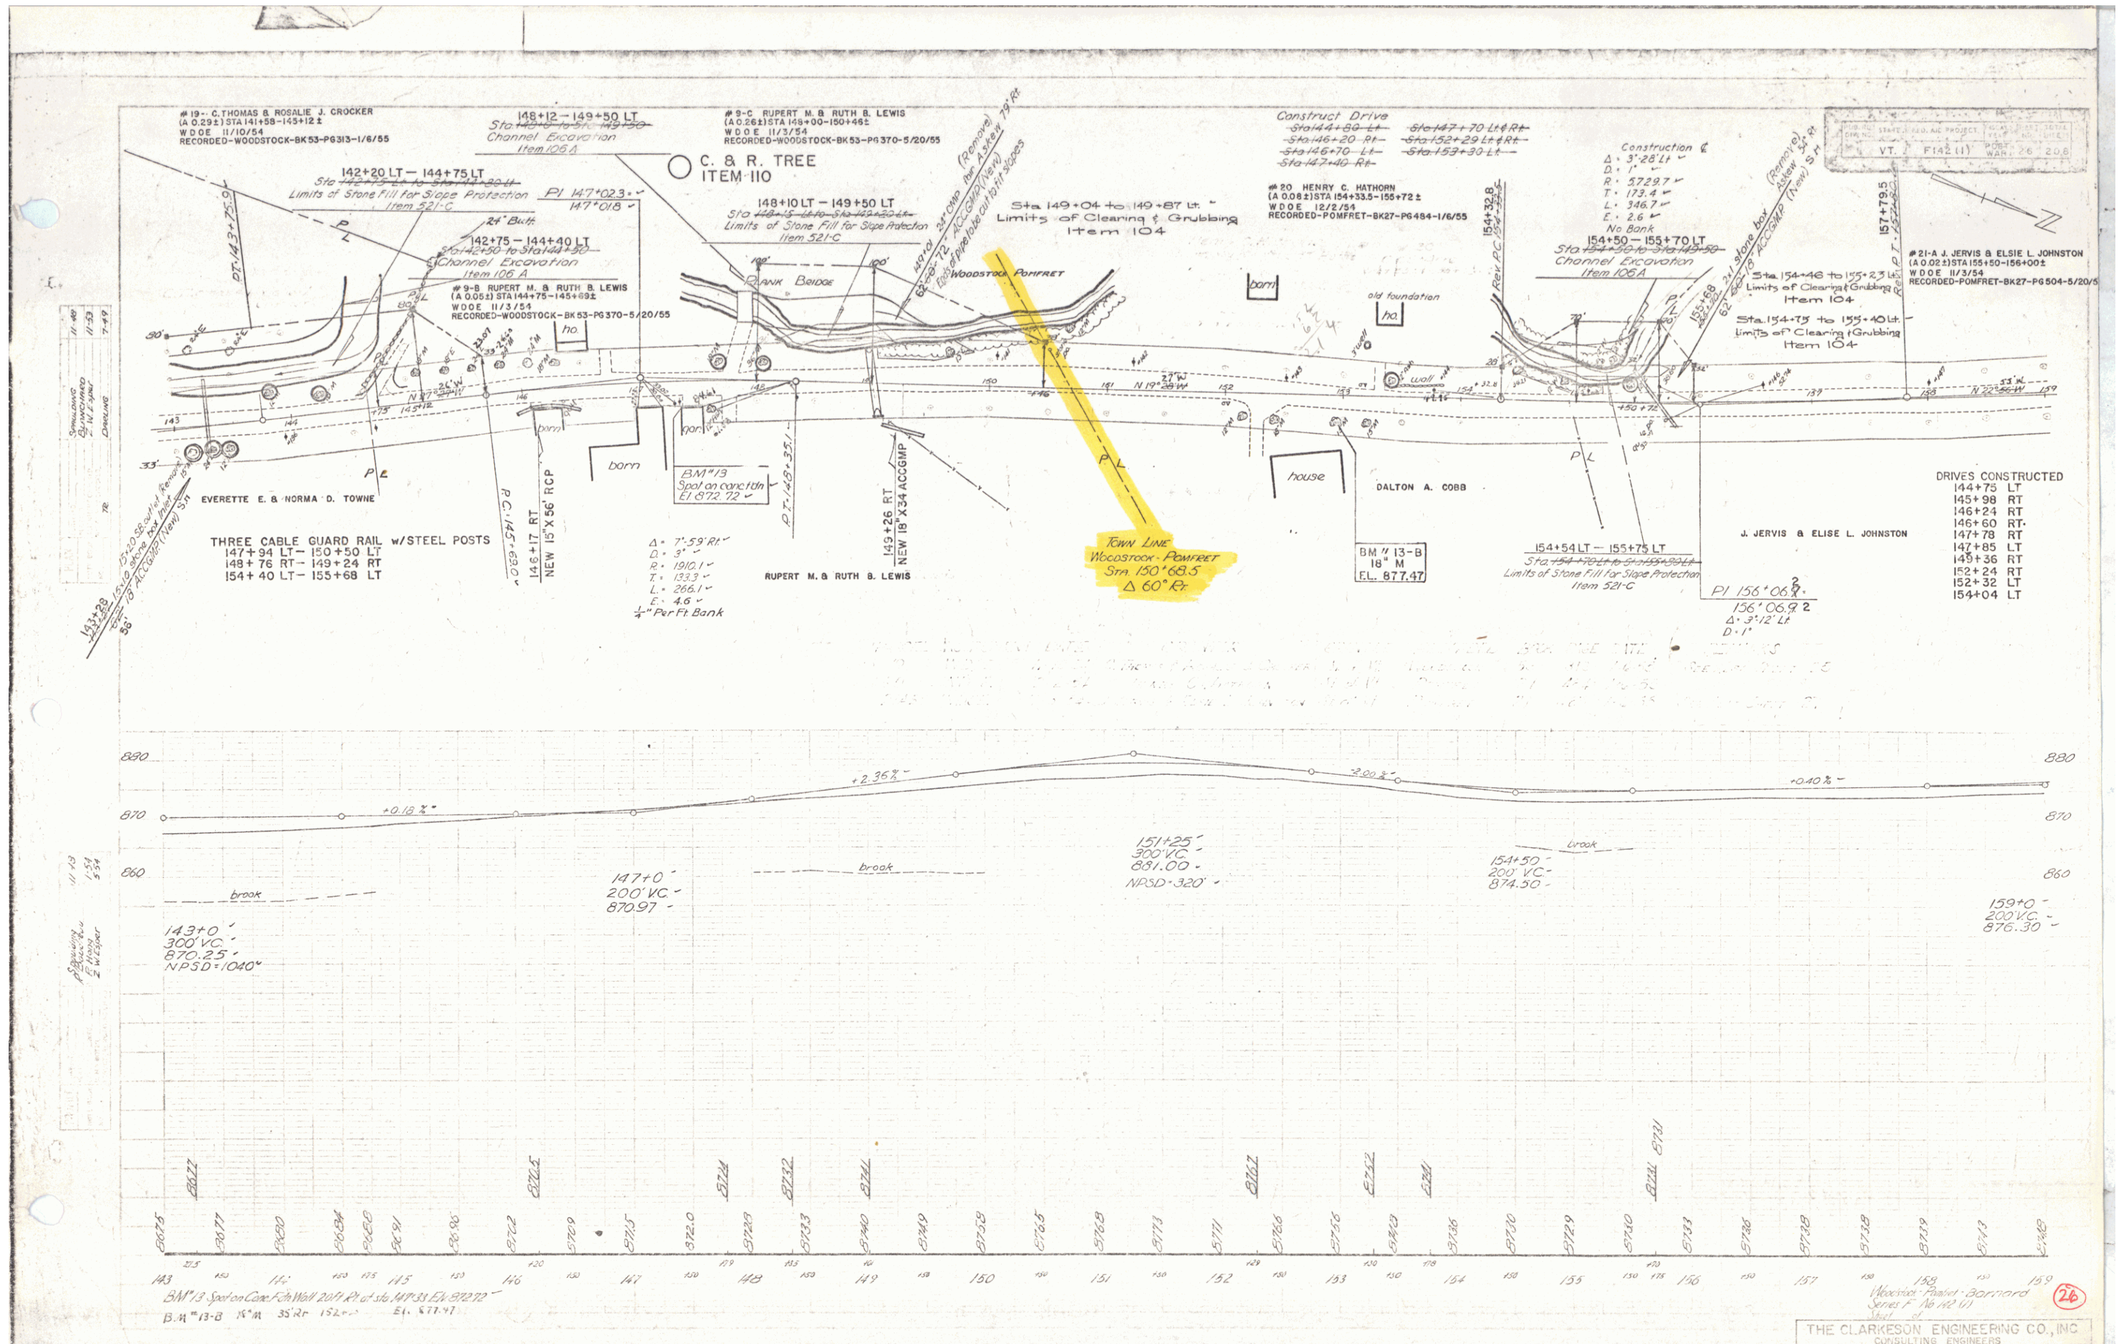

Series F No. 142 (1)
Sheet of

THE CLARKESON ENGINEERING CO., INC
CONSULTING ENGINEERS
BOSTON MASSACHUSETTS

26

12