#23-E ORA C. & ESTELLE C. LEWIS
(A 1.12±) STA 204+00-211+50±
CULVERT RIGHTS-STA 207+50±
UNDERDRAIN-STA 213+50±
WDOE 11/12/54
RECORDED-POMFRET-BK27-PG 503-5/20/55

C. & R. TREE
ITEM 110

Construct Drive
~~Sta. 211+50 Lt.~~

PC 204+75.5

Δ 56°52' Lt
D 10°
R 573.7
T 310.6
L 568.7
E 78.7
Bank ¾" per ft
205+20 LT – 209+25 LT
Sta ~~205+0 Lt to Sta 209+50 Lt~~
Channel Excavation
Item 106A

205+16 LT – 209+15 LT
Sta ~~205+0 Lt to Sta 209+50 Lt~~
Limits of Stone Fill for Slope Protection
Item 521-C

Sta ~~19+90 to 20+90~~
Sta ~~21+0 to 21+90~~
~~Limits of Sub Base of Road~~
~~Item 204~~

field

pasture

woods & brush

brush

ORA C. & ESTELLE C. LEWIS

BM #18
18" Ash
El 960.26

PI 207+86.1
207+33.6

209+21 RT
NEW 18"X32' ACCGMP

PC 210+44.2
210+52
47°-10'

PC 212+45.2

PI 214+59.2
214+49.5

BM # 18-A
30" PINE
EL. 974.03

POST 215+64.8

NEW 18"X60' RCP LH

Sta 218+95 to 220+00 Rt.
Limits of Clearing & Grubbing
Item 104

#23-E ORA C. & ESTELLE C. LEWIS
(A 0.55±) STA 212+50-219+50±
CULVERT RIGHTS-STA 218+00±
WDOE 11/1/54
RECORDED-POMFRET-BK27-PG503-5/20/55

217+70 LT – 220+0 LT
Sta ~~217+65 to Sta 221+65 Lt~~
Limits of Stone Fill for Slope Protection
Item 521-C

218+0
Sta ~~217+50 Lt to~~ 219+50 Lt
Channel Excavation
Item 106A

Δ 29°17' Rt
D 7°0'
R 819.0
T 214.0
L 418.3
E 27.5
Bank ¾" per ft

210+00 LT – 217+85 RT
Sta ~~210+0 Lt to Sta 217+85 Rt~~
New 6"x32' Pipe Culvert
Install Underdrain Pipe
PC 211 w/C RT STA 217+85
PT 216+63.5

Sta 211+93 to 212+95 Rt.
Limits of Clearing & Grubbing
Item 104

Sta 213+85 to 220+00 Rt.
Limits of Clearing & Grubbing
Item 104

216+00 54"x24' ACCGMP (New)
SH
52'

DRIVES CONSTRUCTED
209+29 RT
211+20 LT

THREE CABLE GUARD RAIL w/STEEL POSTS
204+44 LT — 210+71 LT
212+24 LT — 214+0 LT
217+80 LT — 220+52 LT

#24-A CARRIE E. EASTMAN FURBER
(A 0.85±) STA 212+86-219+00±
WDOE 11/1/54
RECORDED-POMFRET-BK27-PG488-1/6/55

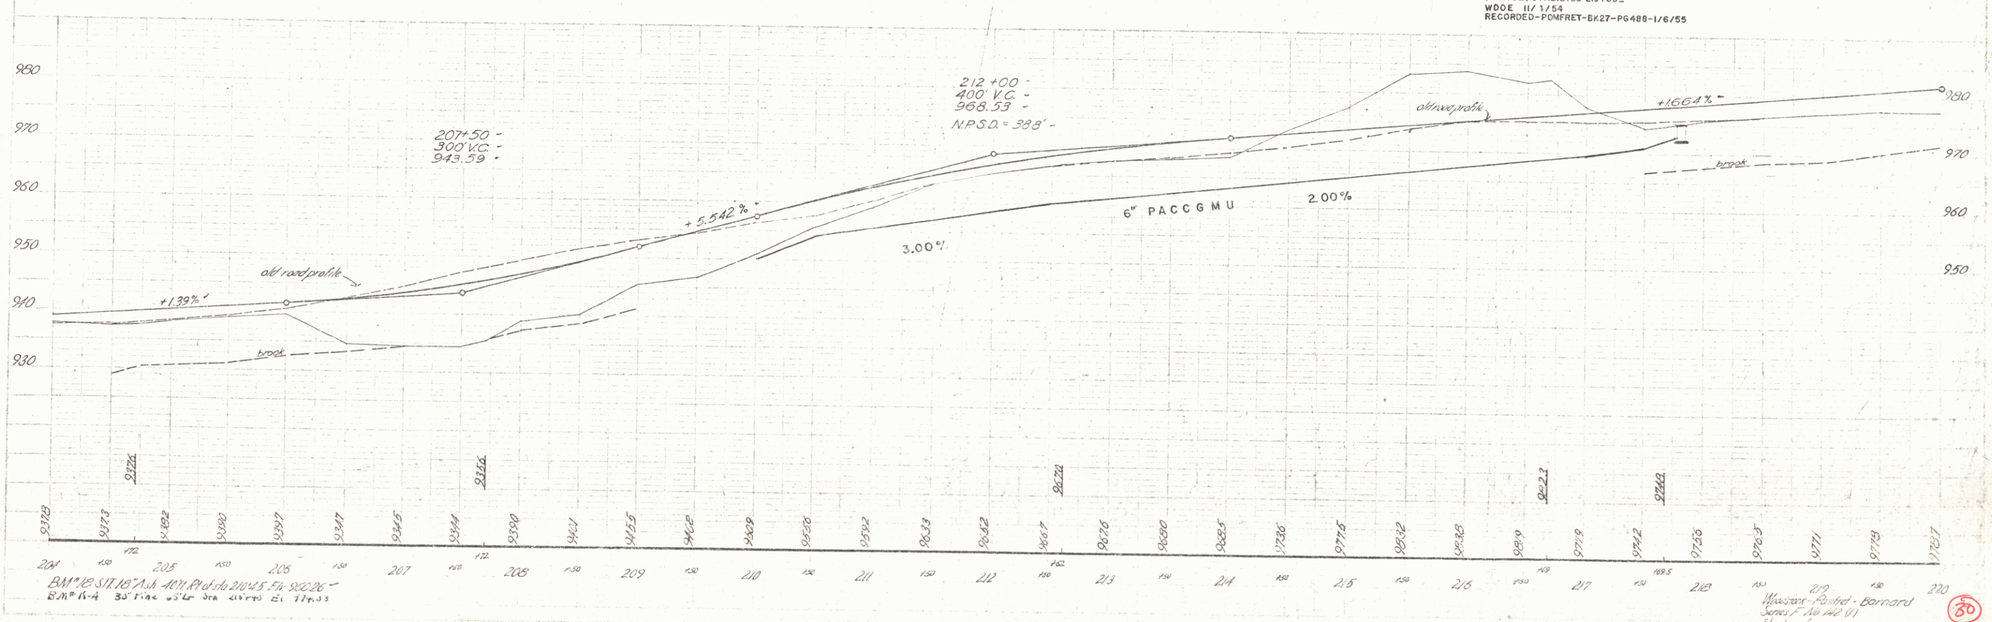

BM # A-4 30" Pine 65' Lt Sta 217+70 El 974.03

Series F No 142 (1)
Sheet 8

THE CLARKESON ENGINEERING CO., INC.
CONSULTING ENGINEERS
BOSTON MASSACHUSETTS


16