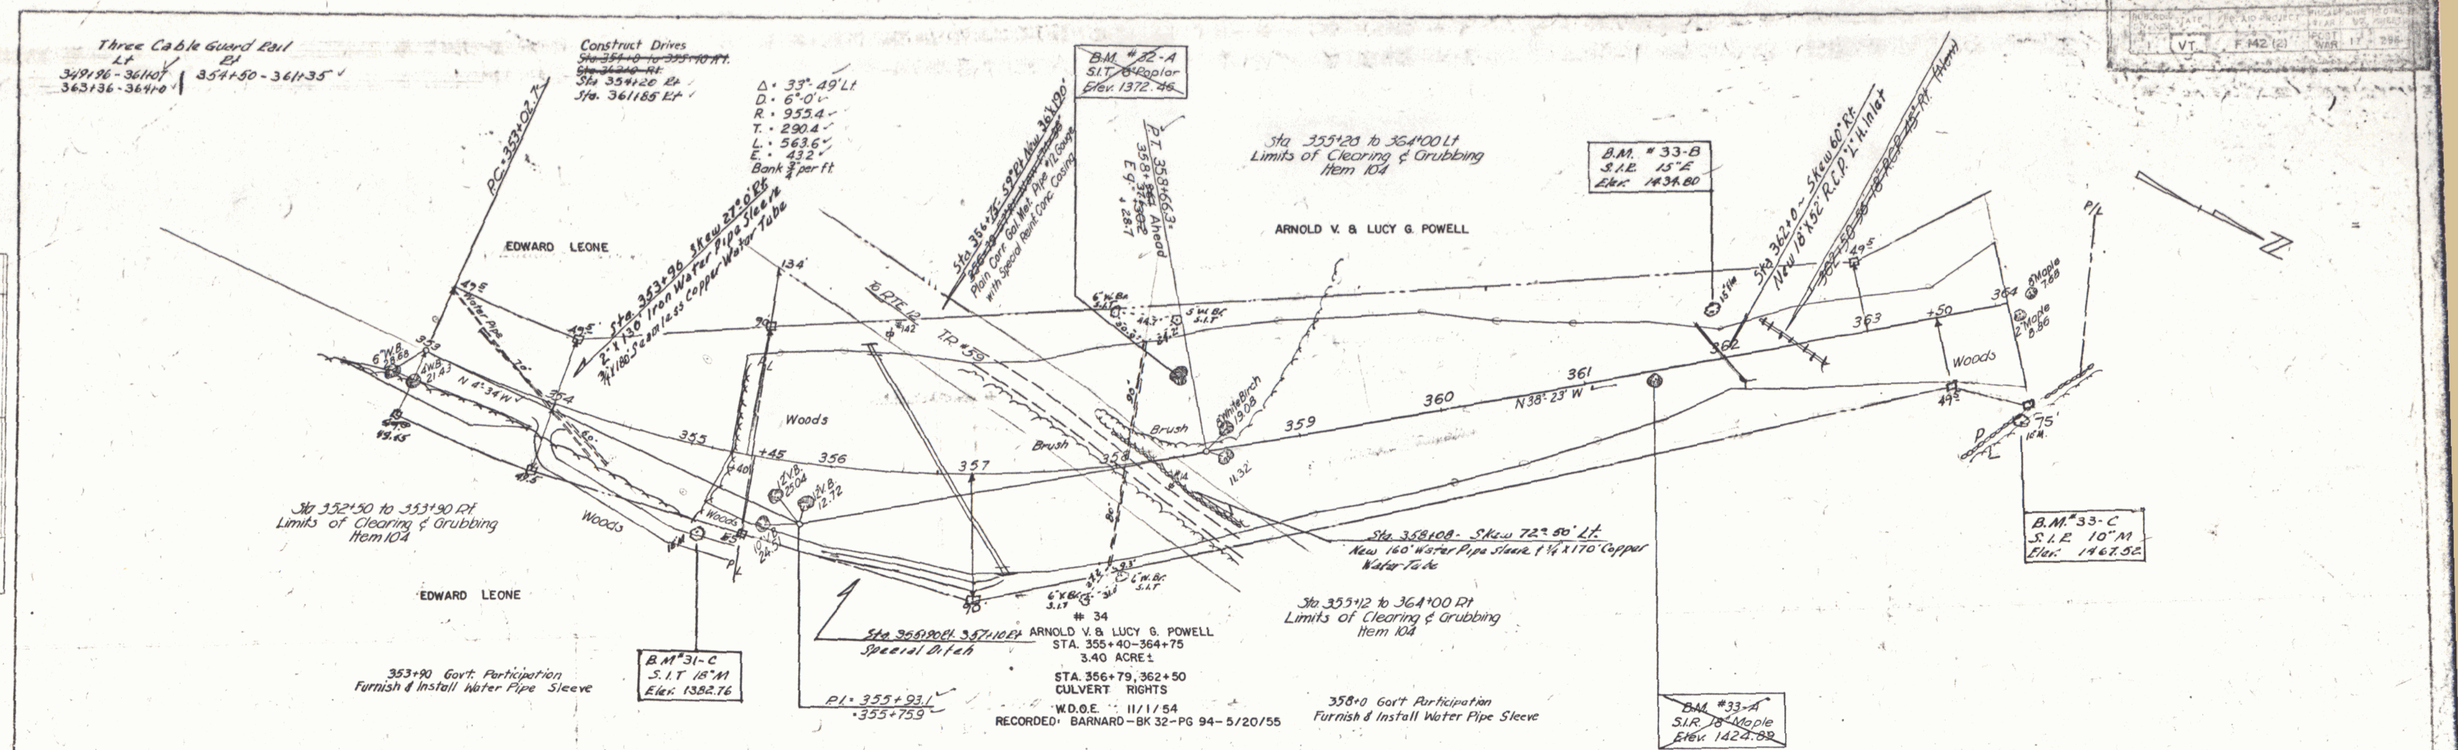
Three Cable Guard Rail
Lt
349+96 - 361+07
363+36 - 364+00
Rt
354+50 - 361+35
Construct Drives
Sta 354+20 Rt
Sta. 361+85 Lt
Δ = 33° 49' Lt
D = 6° 0'
R = 955.4
T = 290.4
L = 563.6
E = 43.2
Bank 3/4" per ft
PC = 353+02.7
Sta. 353+96 Skew 27° Rt
2-1-130' Iron Water Pipe Sleeve
3/4" 180 Seamless Copper Water Tube
EDWARD LEONE
N 4° 34' W
Woods
Brush
TP #59
B.M. #32-A
S.I.T. 6" Poplar
Elev. 1372.46
P.I. 358+66.3
Eq. 358+52.8
Sta 355+26 to 364+00 Lt
Limits of Clearing & Grubbing
Item 104
ARNOLD V. & LUCY G. POWELL
B.M. #33-B
S.I.R. 15" E
Elev. 1434.80
Sta 362+0 - Skew 60° Rt
New 18" X 52' R.C.P. 1 ft. Inlet
N 38° 23' W
Sta 352+50 to 353+90 Rt
Limits of Clearing & Grubbing
Item 104
Sta 358+08 - Skew 72° 50' Lt
New 160' Water Pipe Sleeve 1 1/4" x 170' Copper Water Tube
B.M. #33-C
S.I.R. 10" M
Elev. 1467.52
Sta 355+12 to 364+00 Rt
Limits of Clearing & Grubbing
Item 104
EDWARD LEONE
353+90 Gov't Participation
Furnish & Install Water Pipe Sleeve
B.M. #31-C
S.I.T. 18" M
Elev. 1382.76
Sta 356+90 Rt. 357+10 Rt
Special Ditch
34
ARNOLD V. & LUCY G. POWELL
STA. 355+40-364+75
3.40 ACRE±
STA. 356+79, 362+50
CULVERT RIGHTS
W.D.O.E. 11/1/54
RECORDED: BARNARD-BK 32-PG 94-5/20/55
P.I. 355+93.1
355+75.9
358+0 Gov't Participation
Furnish & Install Water Pipe Sleeve
B.M. #33-A
S.I.R. 18" Maple
Elev. 1424.88
P.T. 346+77.4
344+73.2
Eq = 1.42
P.C. 353+02.7
69° 45'
156° 35' 30"
26° 10' 30"
P.C. to P.T. Tie Point
+7.00 %
+7.00 %
1440
1430
1420
1410
1400
1390
1380
1370
1360
1372.0
1375.3
1374.7
1373.2
1368.1
1363.3
1358.9
1356.9
1358.9
1363
1368.2
1372.6
1378.4
1380.3
1384.6
1389.8
1396.1
1405.1
1414.6
1424.2
1434.6
1443.6
1451.8
1452.8
1452.4
353 +50 354 +50 355 +50 356 +79 357 +50 358 +50 359 +50 360 +50 361 362 363 364
B.M. 31-C S.I.T. 18" Maple 60' Rt Sta 355+15 El. 1382.76
B.M. 33-B S.I.R. 15" Elm 34' Lt. Sta 361+96 El. 1434.60
B.M. #33-C S.I.R. 10" Maple 80' Rt Sta 363+92 - El 1467.52
BARNARD-BETHEL
THE CLARKESON ENGINEERING CO., INC.
CONSULTING ENGINEERS
BOSTON MASSACHUSETTS

3