

C. & R. TREE
ITEM 110

LEE V. & GERTRUDE D. WARD

55E
RALEIGH & MARJORIE D. CAMPBELL
STA. 590+25
CULVERT RIGHTS
W.D.O.E. 7/1/55
RECORDED: BARNARD - BK32 - PG108 - 7/13/55

55B
RALEIGH & MARJORIE D. CAMPBELL
STA. 593+00 - 596+50
0.09 ACRE ±
W.D.O.E. 11/1/54
RECORDED: BARNARD - BK31 - PG 553/554 - 1/24/55

Construct Parking Area
599+0 to 604+0 R/L

55C
RALEIGH & MARJORIE D. CAMPBELL
STA. 599+00 - 602+50
0.10 ACRE ±
W.D.O.E. 11/1/54
RECORDED: BARNARD - BK31 - PG 553/554 - 1/24/55
Sta. 600+76 to 601+50 L/L
Limits of Clearing & Grubbing
Item 104

55D
RALEIGH & MARJORIE D. CAMPBELL
STA. 601+83
CULVERT RIGHTS
W.D.O.E. 5-13-55
RECORDED: BARNARD - BK 32 - PG 107 - 5/20/55

53D
LEE V. & GERTRUDE D. WARD
STA. 587+00 - 588+60
0.10 ACRE ±
W.D.O.E. 11/1/54
RECORDED: BARNARD - BK32 - PG III/112 - 5/20/55

Sta. 587+00 to 589+00 R/L
Limits of Clearing & Grubbing
Item 104

55A
RALEIGH & MARJORIE D. CAMPBELL
STA. 588+40 - 590+00
0.06 ACRE ±
W.D.O.E. 11/1/54
RECORDED: BARNARD - BK 31 - PG 553/554 - 1/24/55

B.M. 58-A
S.I.R. 20' Lam
L. 907.66


Δ 7' 10" R/L
D. 2'-0"
R. 2,864.9
T. 182.8
L. 363.0
E. 58'
Bank 2' per ft.

Three Cable Guard Rail
Steel Posts
Sta. 587+50 - 588+74

Sta. 597+29
Water Pipe
Water Pipe by Property Owner

Sta. 597+35 Non Govt Participation
Install sleeve for water pipe across
roadway Item 103. (Non Govt)
Sleeve to be furnished by Property Owner.

Δ 1'-5" R/L
D. 0'-30"
R. 1,459.2
T. 185.0
L. 370.0
E. 15'
No Bank

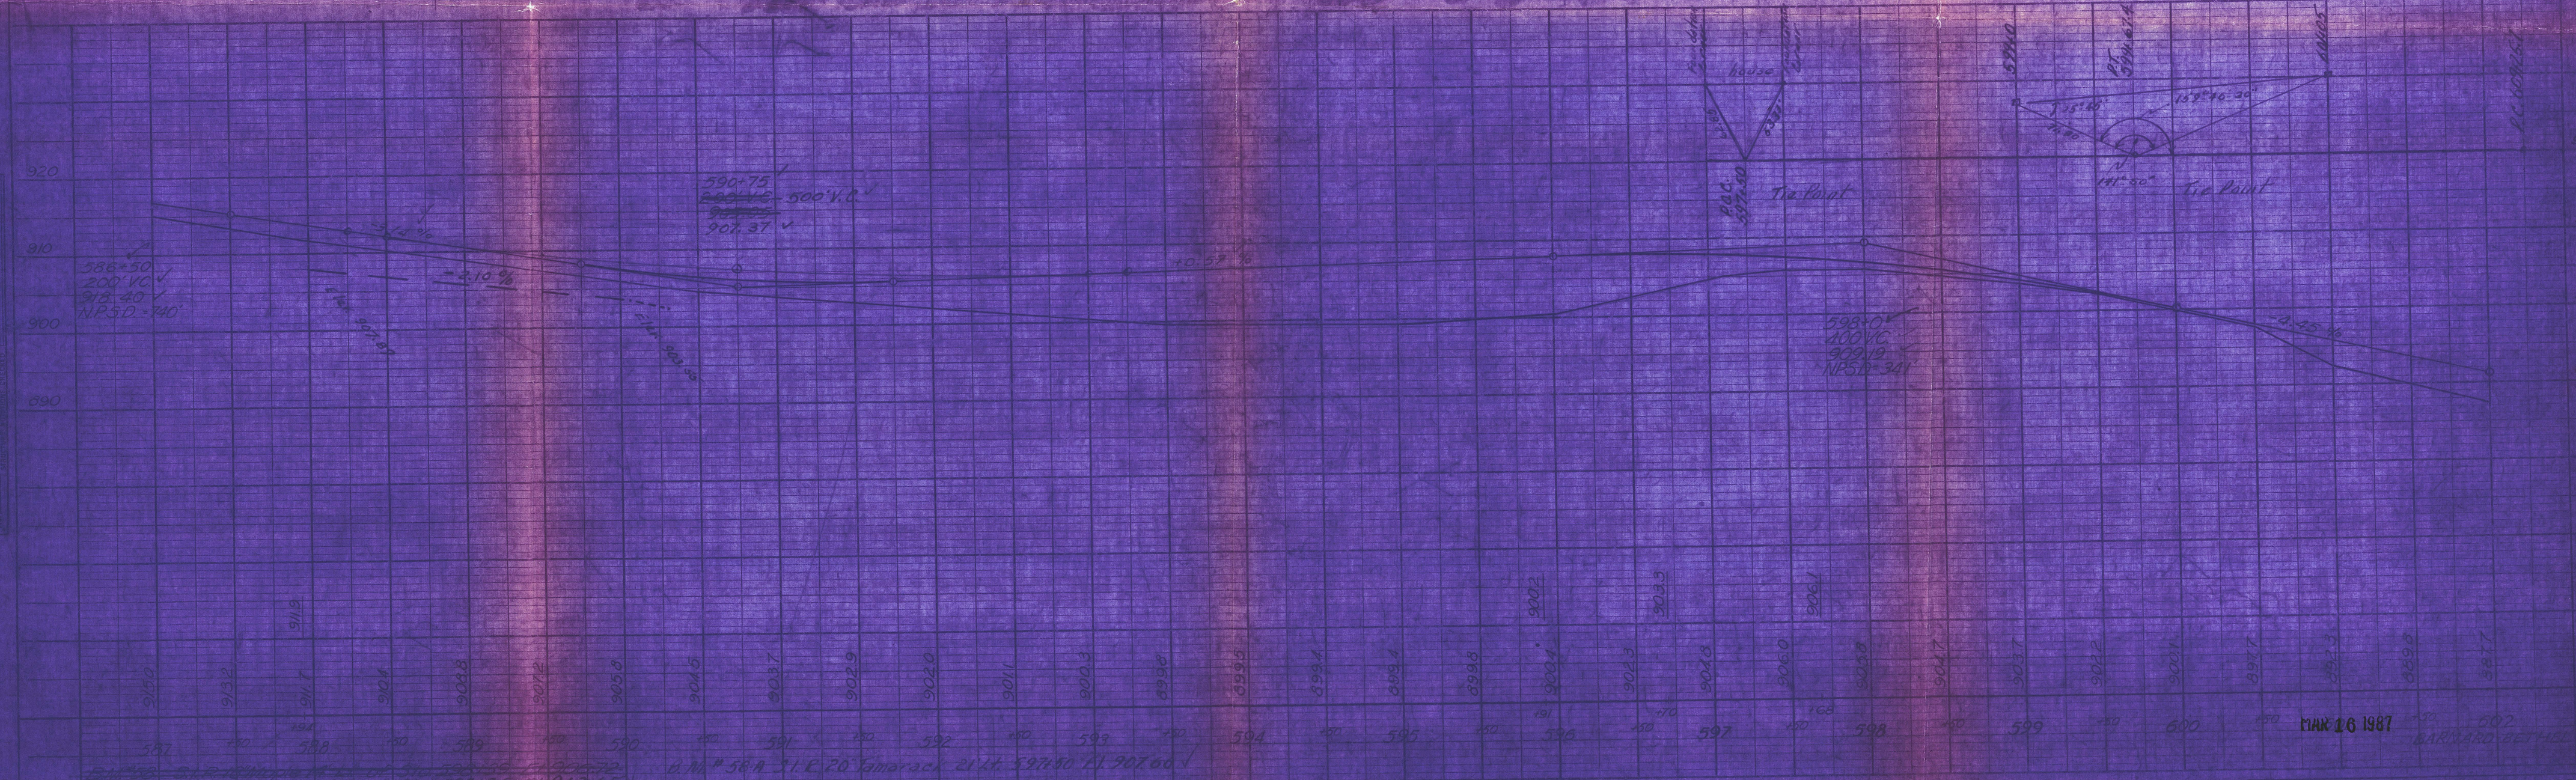

MAR 16 1987

THE CLARKE ENGINEERING CO., INC.
CONSULTING ENGINEERS
BOSTON MASSACHUSETTS

Project F142 (2) 99K432