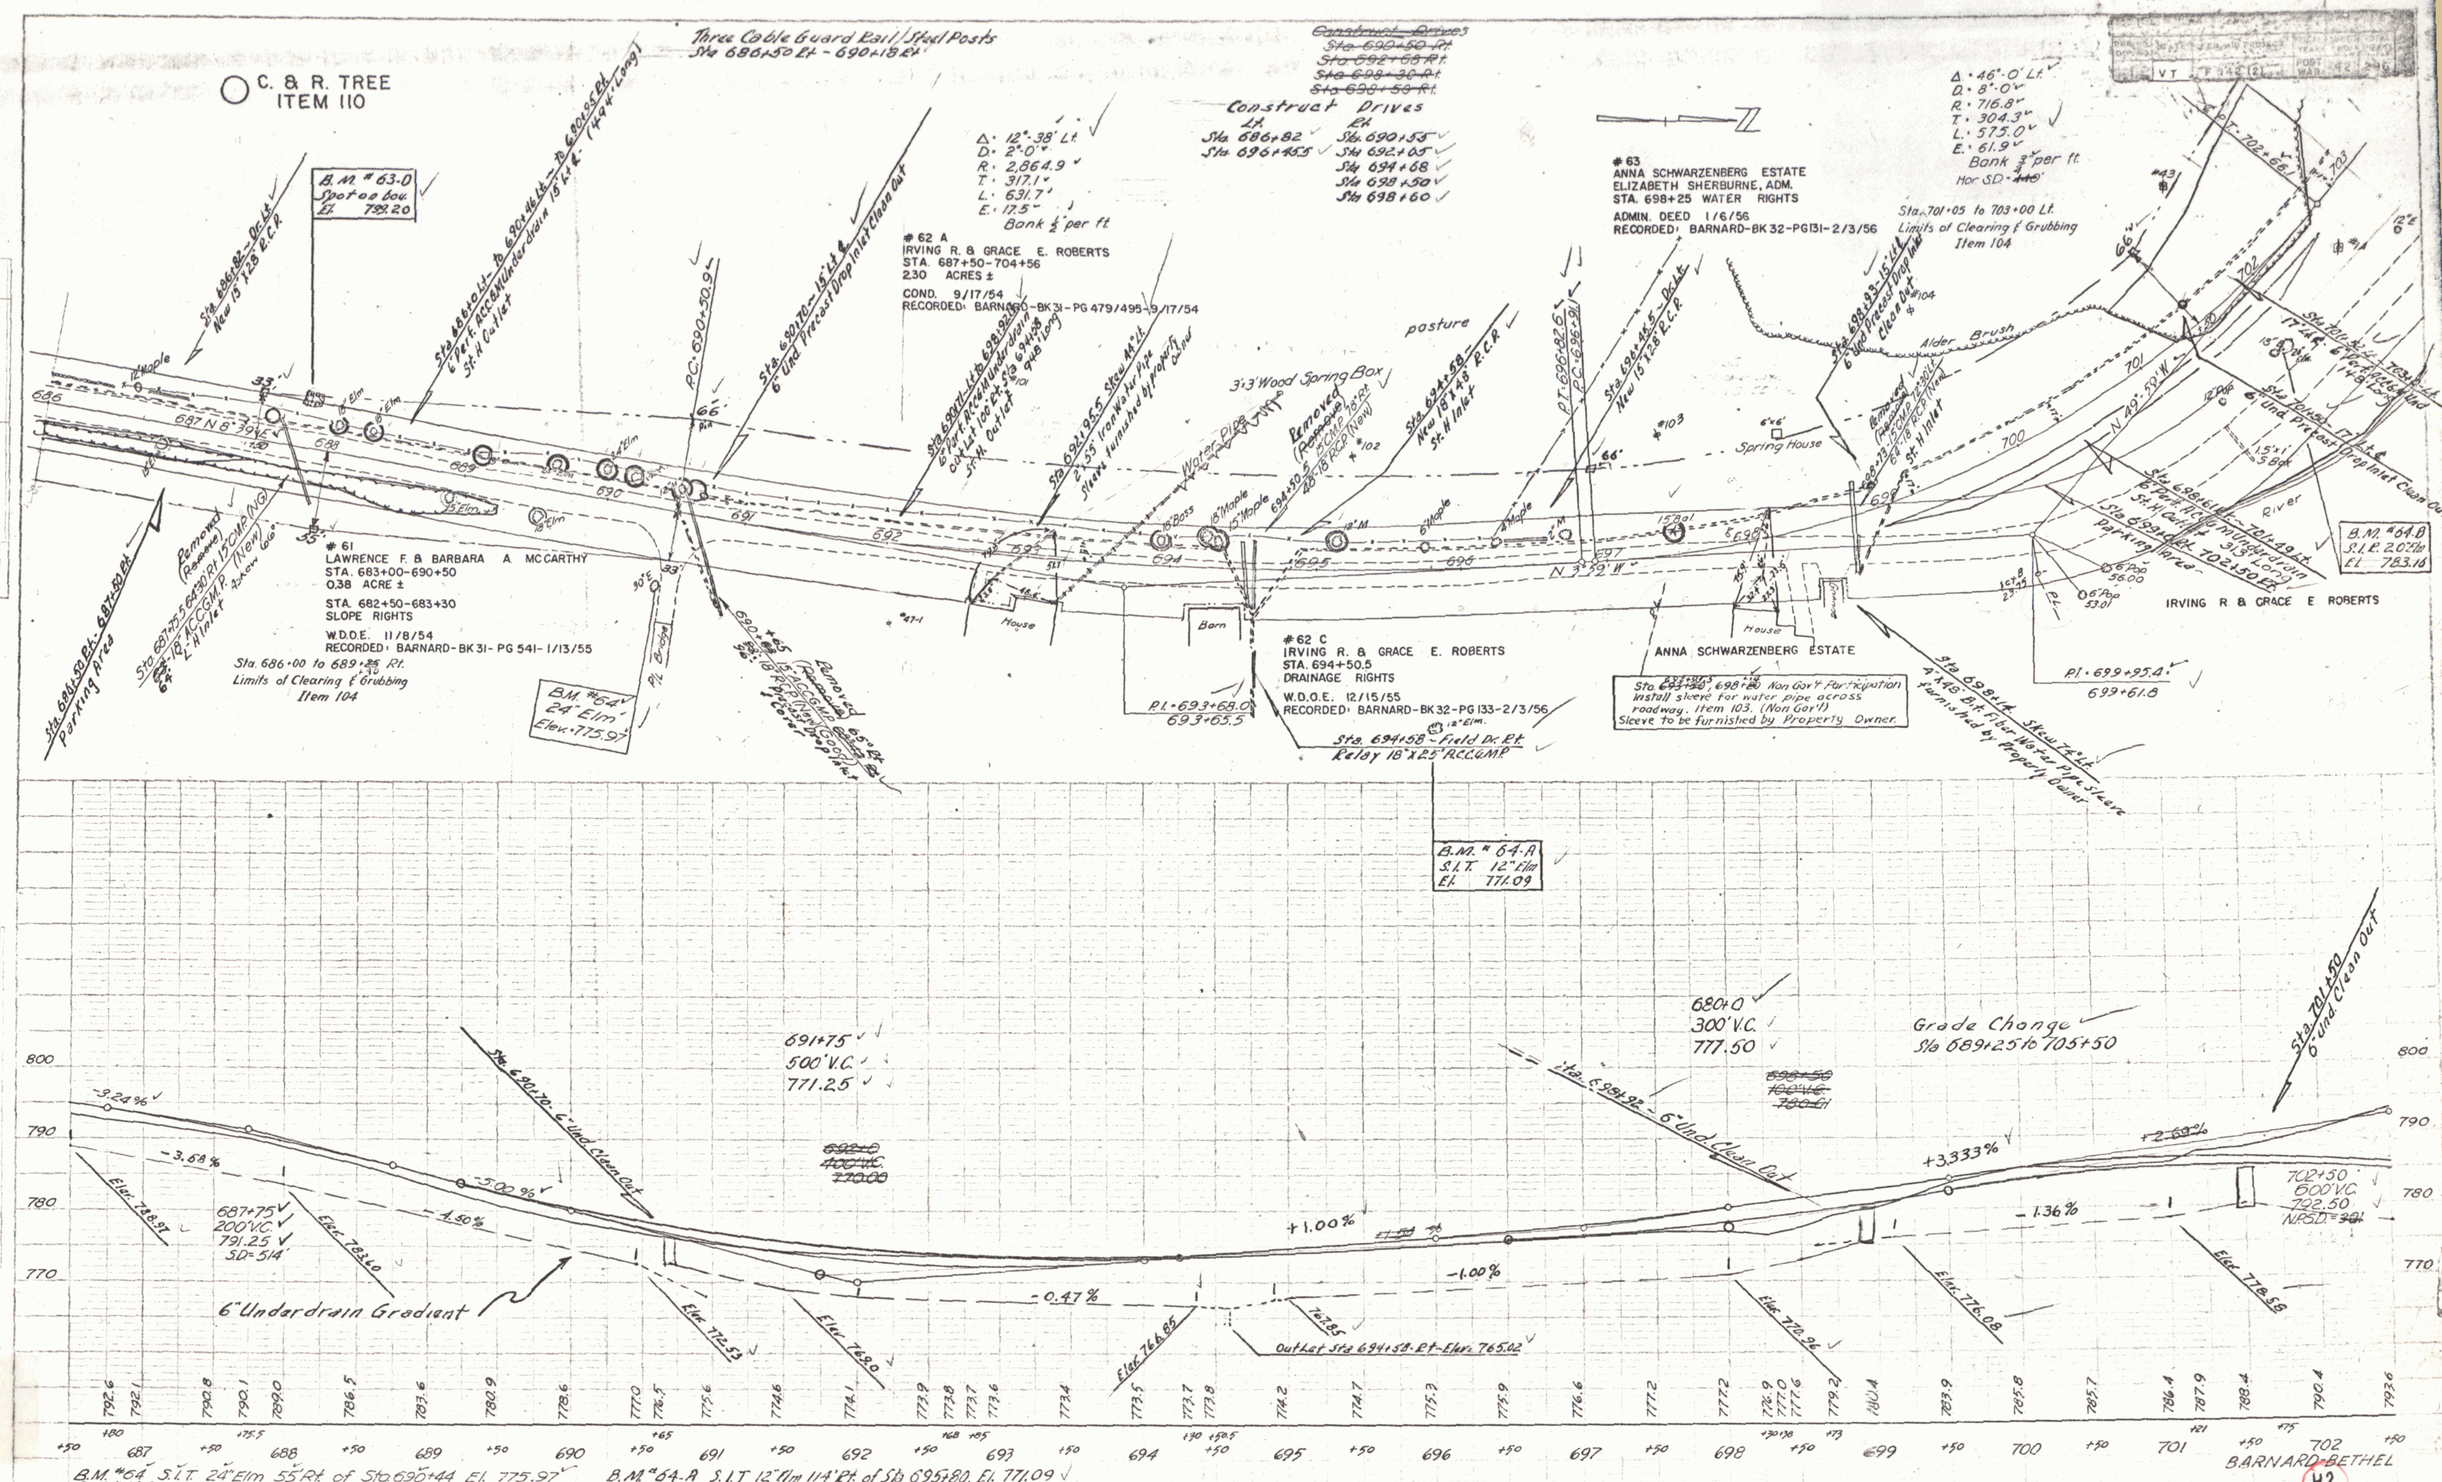
C. & R. TREE
ITEM 110
Three Cable Guard Rail/Steel Posts
Sta 686+50 Lt - 690+18 Lt
B.M. #63-D
Spot on bou.
El 789.20
Sta. 686+82 - Dr. Lt
New 15" RCP
Sta 686+10 Lt to 690+46 Lt - to 690+55 Rt
6" Perf. Acc. Underdrain
St. H Outlet
Sta. 690+70 - 18" Lt
6" Und. Precast Drop Inlet Clean Out
Sta. 690+50.9
PC: 690+50.9
Sta. 690+70 to 698+92
6" Perf. Acc. Underdrain
Out Let Inlet Sta 694+70
St. H. Outlet
Sta 694+95.5 Steel 44" Lt.
2.55 Iron Water Pipe
Steel turnstile by property owner
Sta. 694+58 - 18" Rt
New 18" RCP
St. H Inlet
PT: 696+82.6
PC: 696+91
Sta 694+45.5 - Dr. Lt
New 15" RCP
Sta 694+35 - 15" Lt
6" Und. Precast Drop Inlet
Clean Out
Sta. 698+35 - 15" Lt
6" Und. Precast Drop Inlet
Clean Out
Sta 698+35 - 15" Lt
6" Und. Precast Drop Inlet
Clean Out
Sta 698+61 Rt
6" Perf. Acc. Underdrain
St. H Inlet
Sta 698+61 Lt
6" Perf. Acc. Underdrain
St. H Out