7000 no 10%

No Dwg

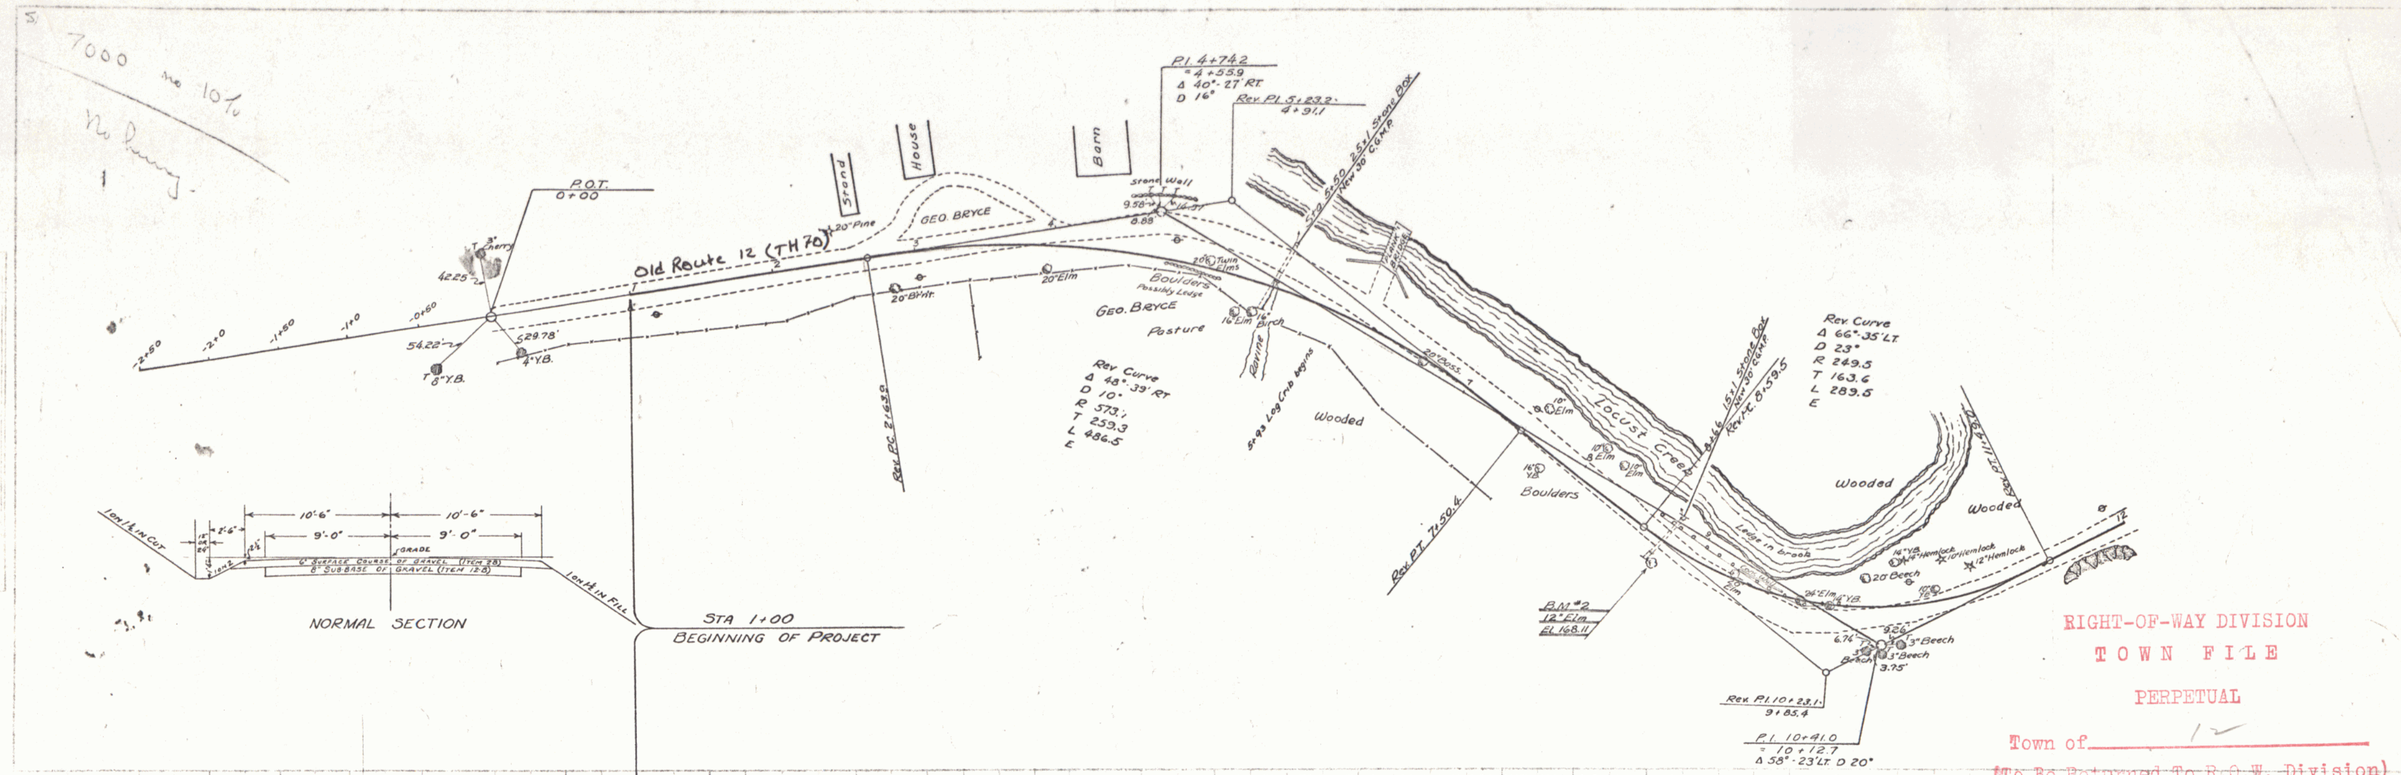

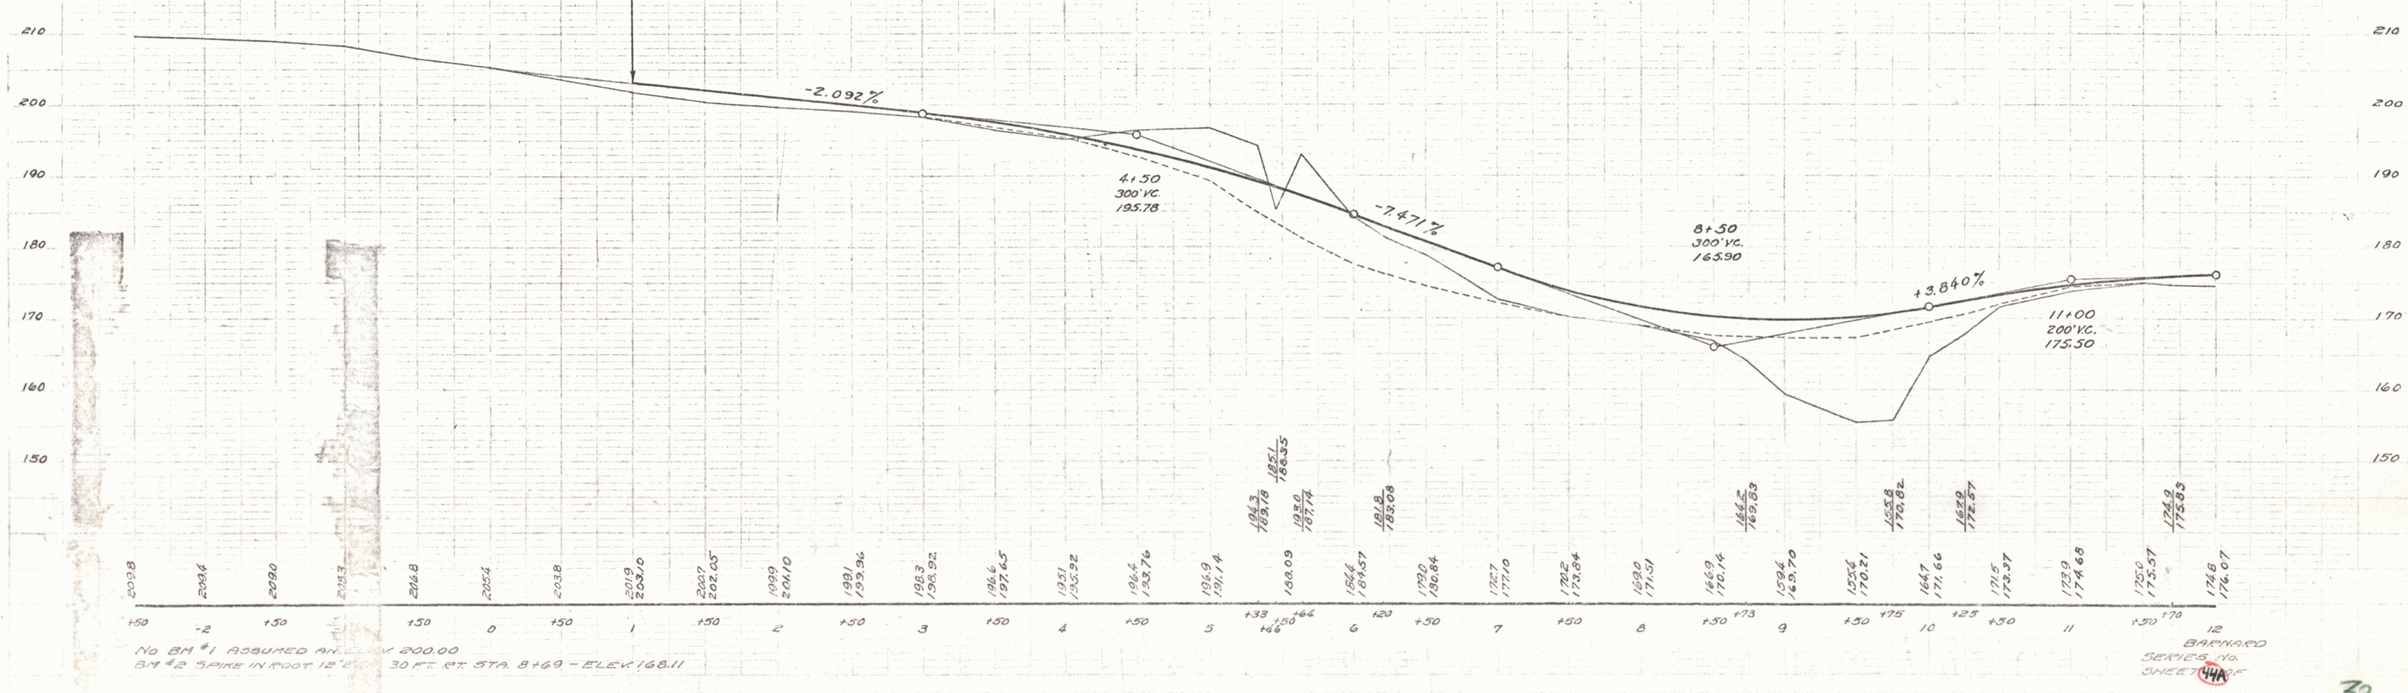

RIGHT-OF-WAY DIVISION
TOWN FILE
PERPETUAL
Town of 12
(To Be Returned To R.O.W. Division)

32

DIST. # 4 PLANS