24 CRM in wall

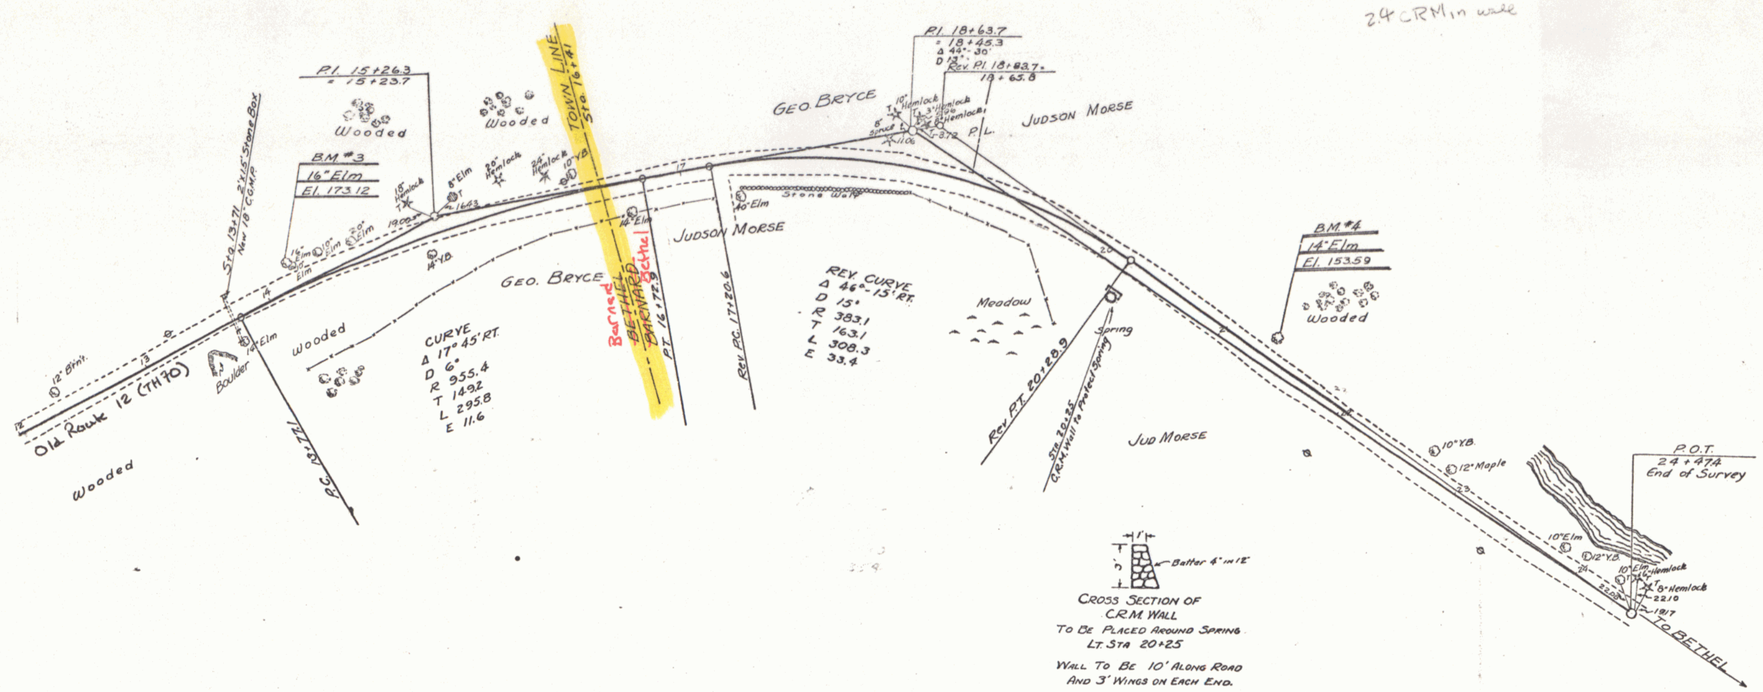

CROSS SECTION OF
C.R.M. WALL
TO BE PLACED AROUND SPRING
LT. STA 20+25

WALL TO BE 10' ALONG ROAD
AND 3' WINGS ON EACH END.

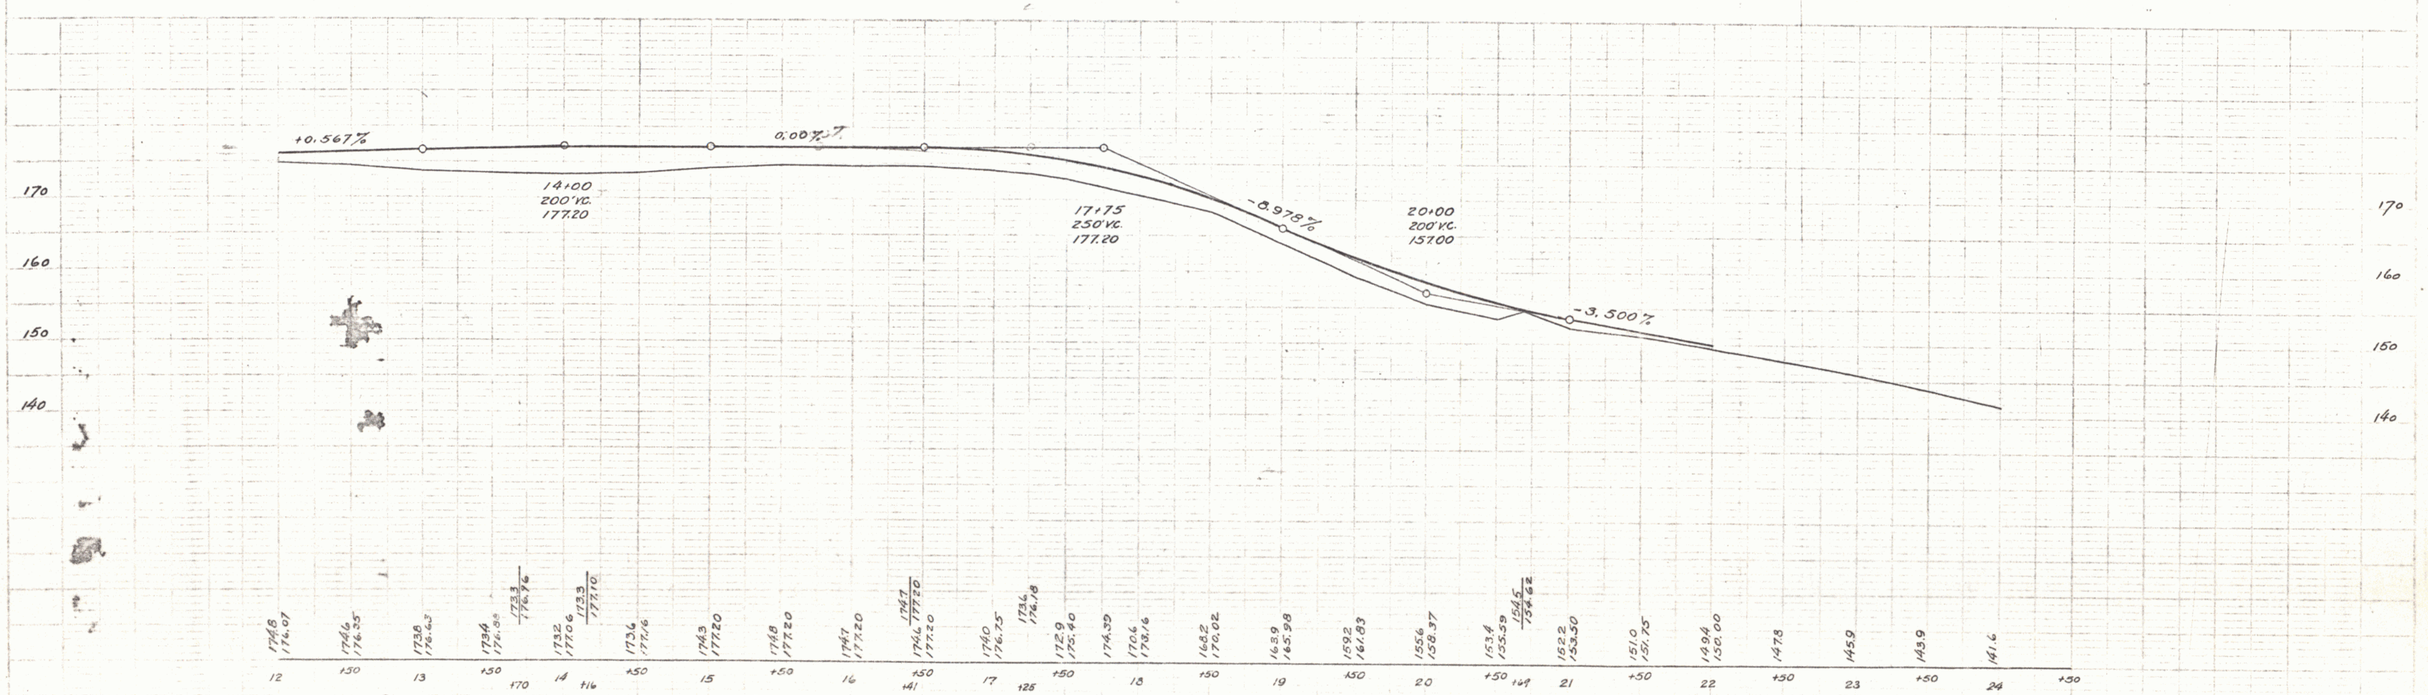

BM #3 SPIKE IN ROOT 16" ELM 15 FT. LT. STA. 14+ ELEV. 173.12
BM #4 SPIKE IN ROOT 14" ELM 22 FT. LT. STA. 21+ ELEV. 153.59

SERIES No.
SHEET 448 OF

BARNARD

33