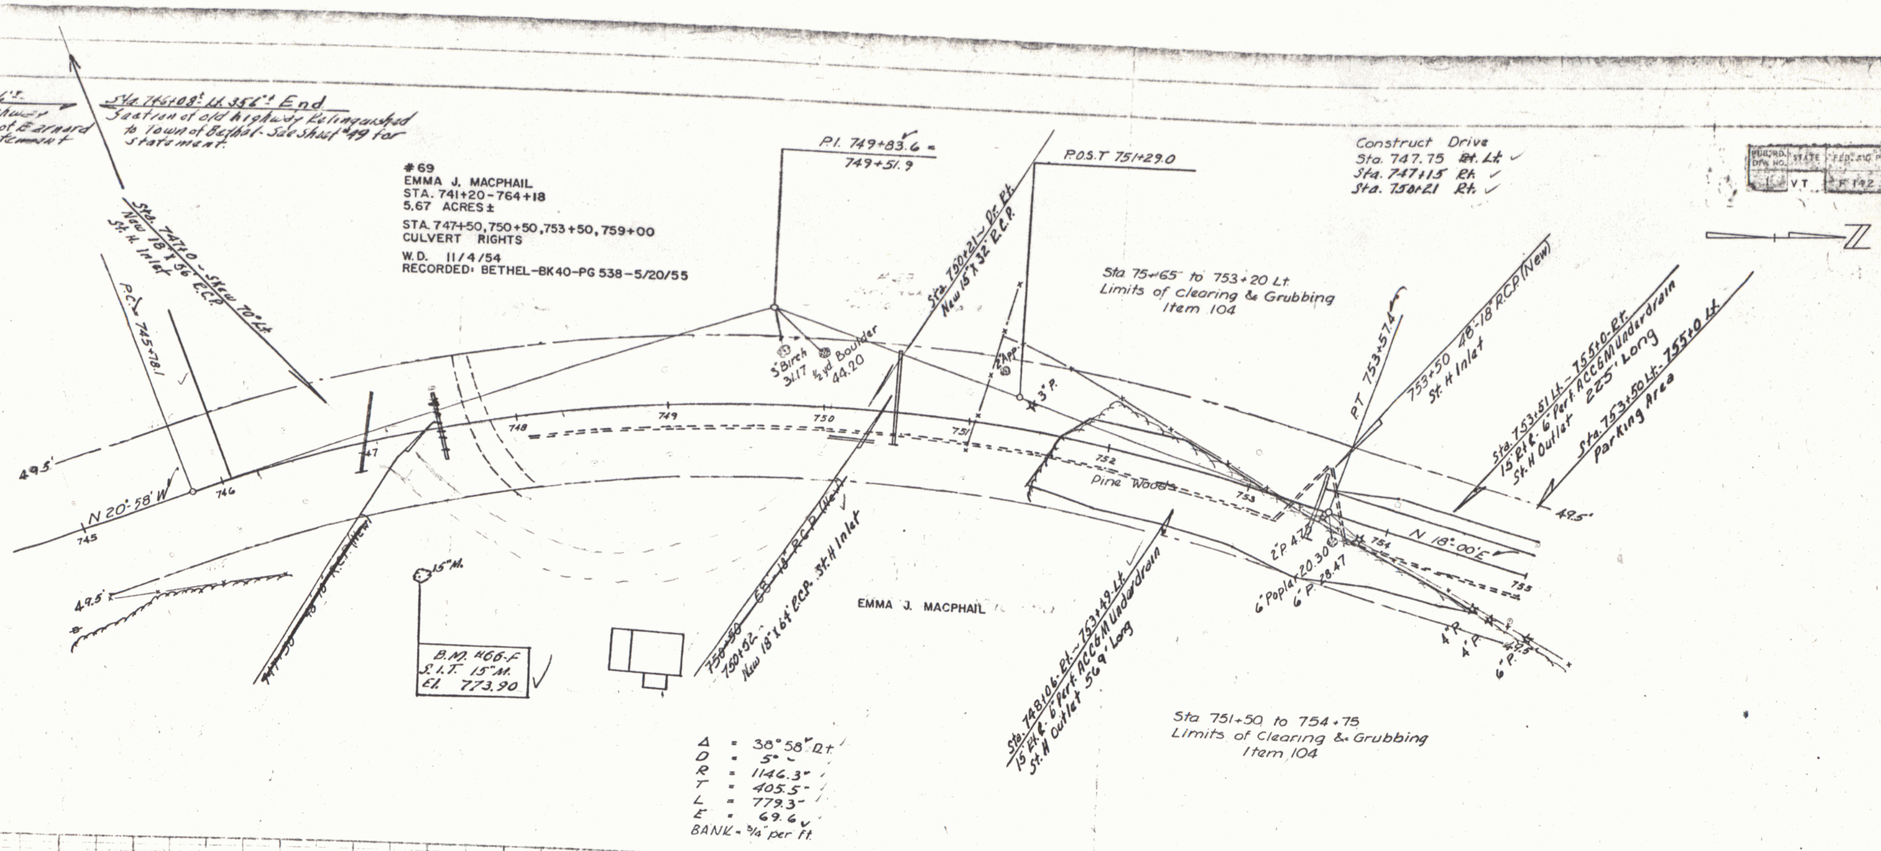

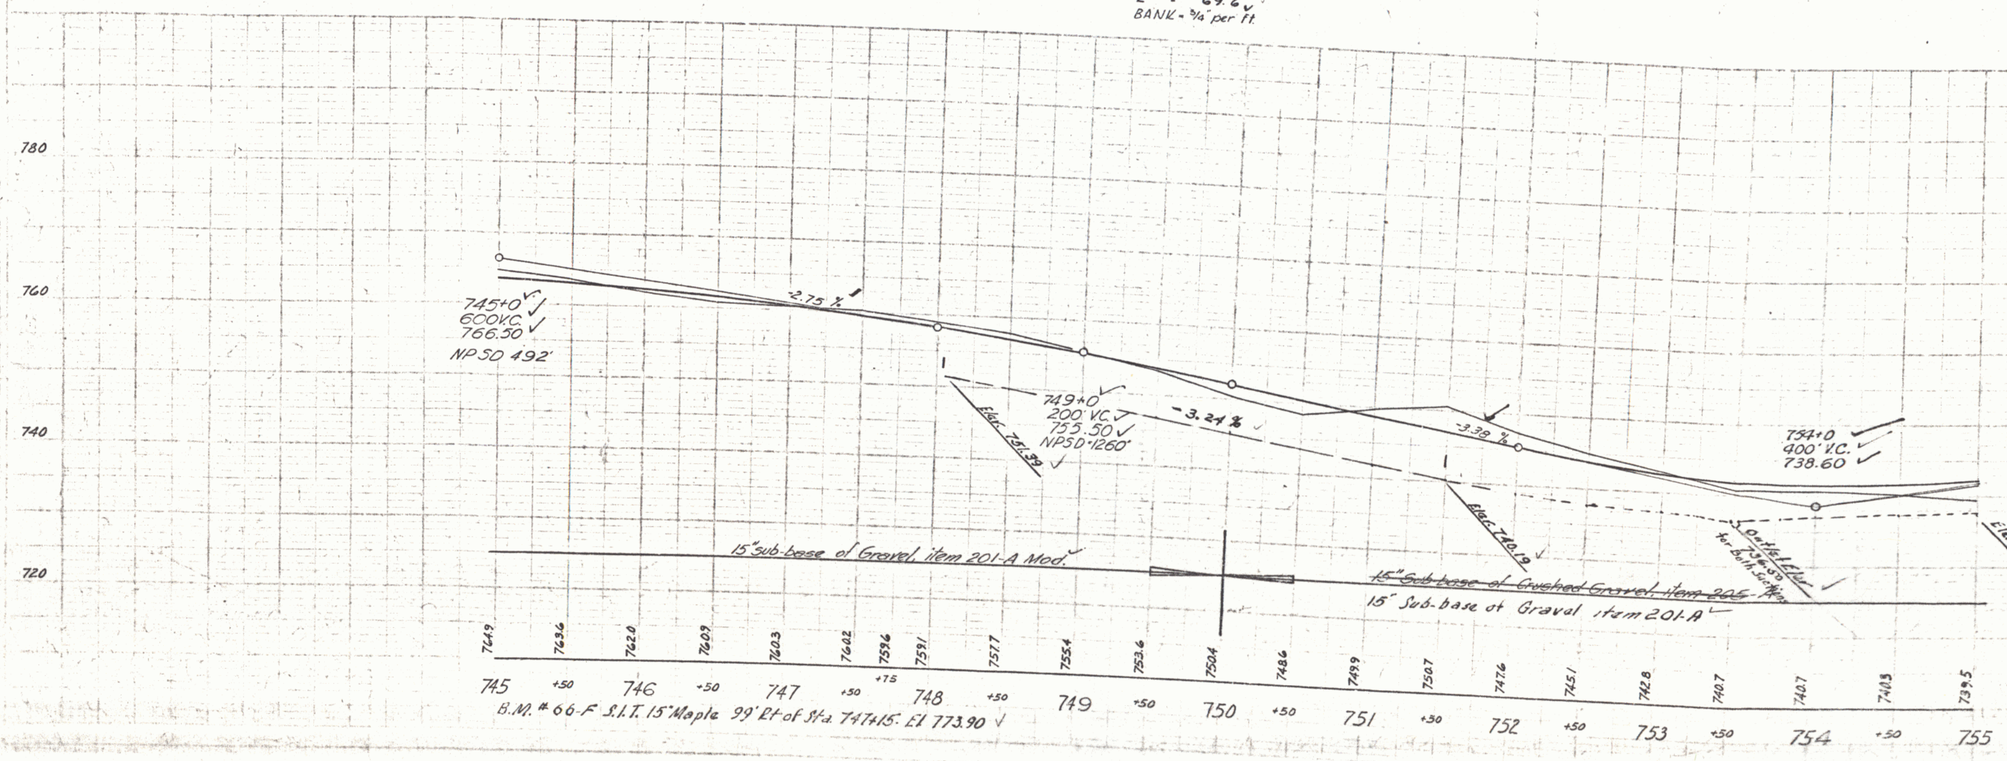

BARNARD-BE

46

THE CLARKESON ENGINEERING
CONSULTING ENGINEERS
BOSTON

35