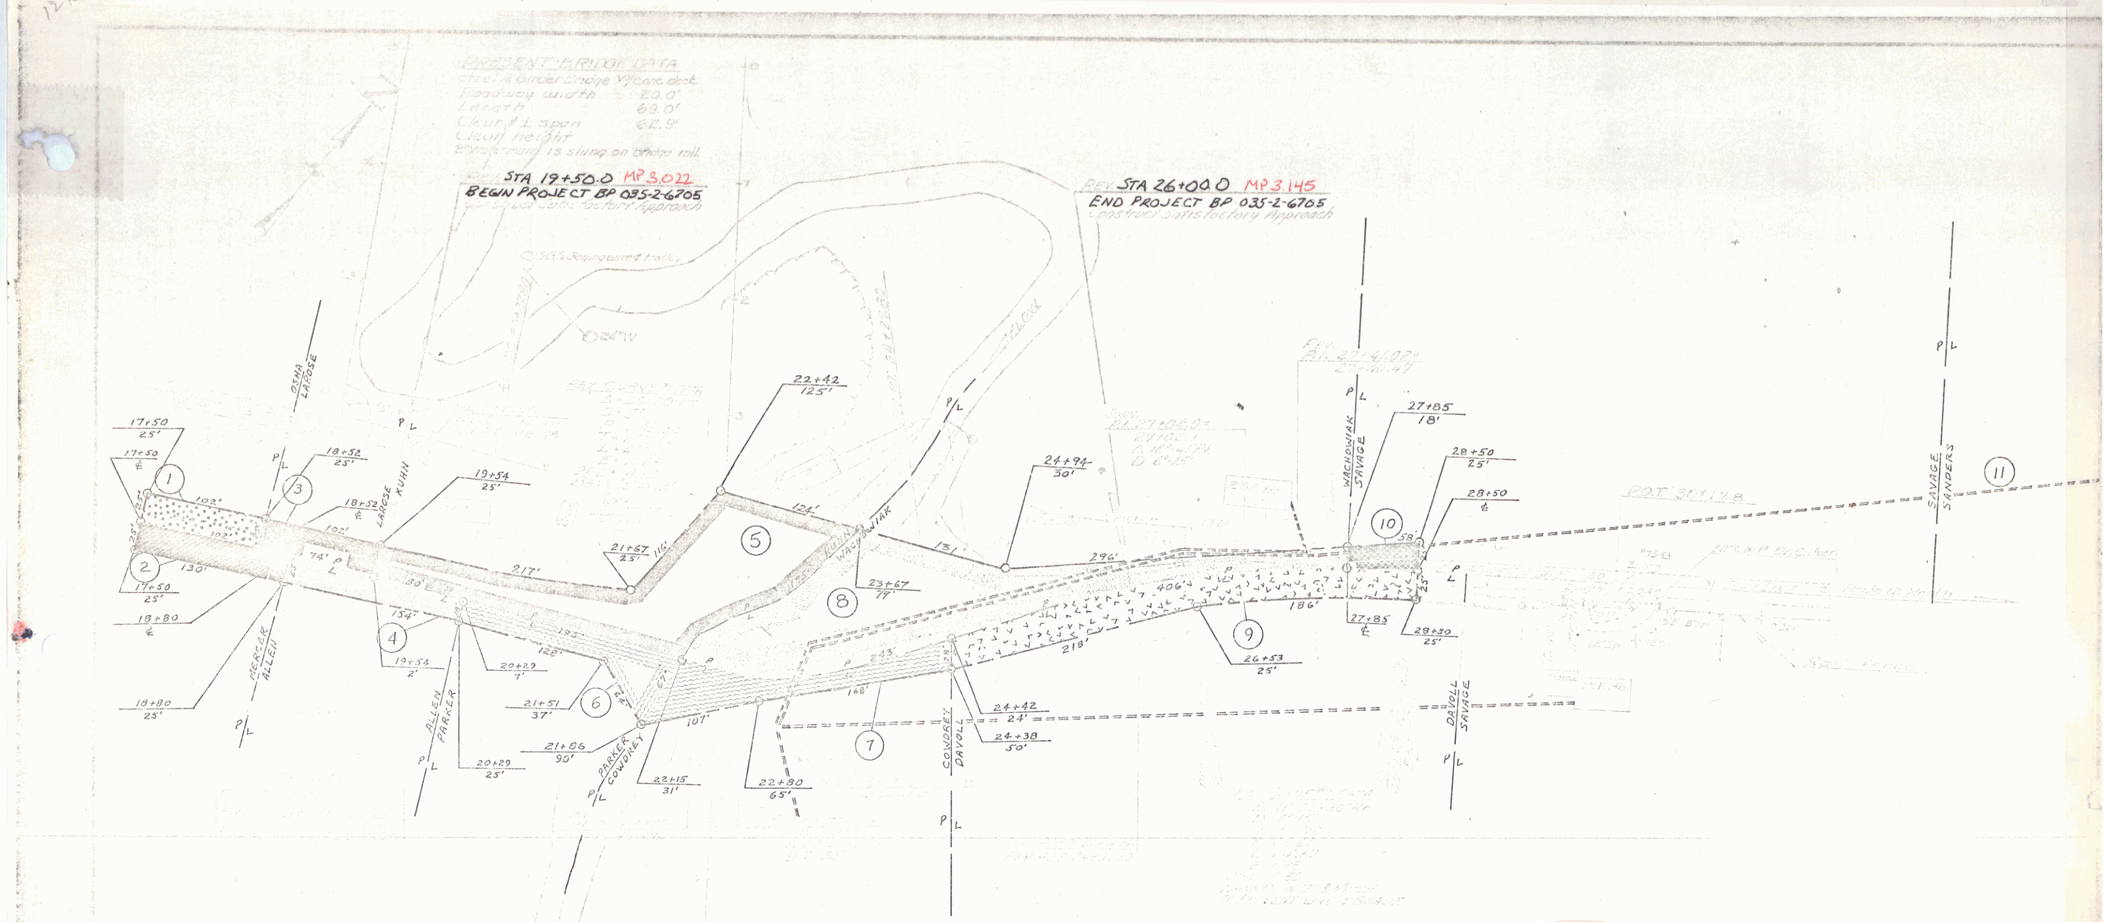

1/2/75
ROW not acquired

Pin# 99R943

STATE OF VERMONT
DEPARTMENT OF HIGHWAYS

TOWN OF RANDOLPH
ROAD No. VT12 BRIDGE No.
VT12 over AYERS BR
PLAN
SCALE
SURVEYED
DRAWN
PROJECT No.
SHEET 1

Project No. BP 035-2-6705

VT12 1