FED. ROAD DIST. NO.	STATE	FED. AID PROJ. NO.	FISCAL YEAR	SHEET NO.	TOTAL SHEETS
9	VT	113-C	1936	12	69

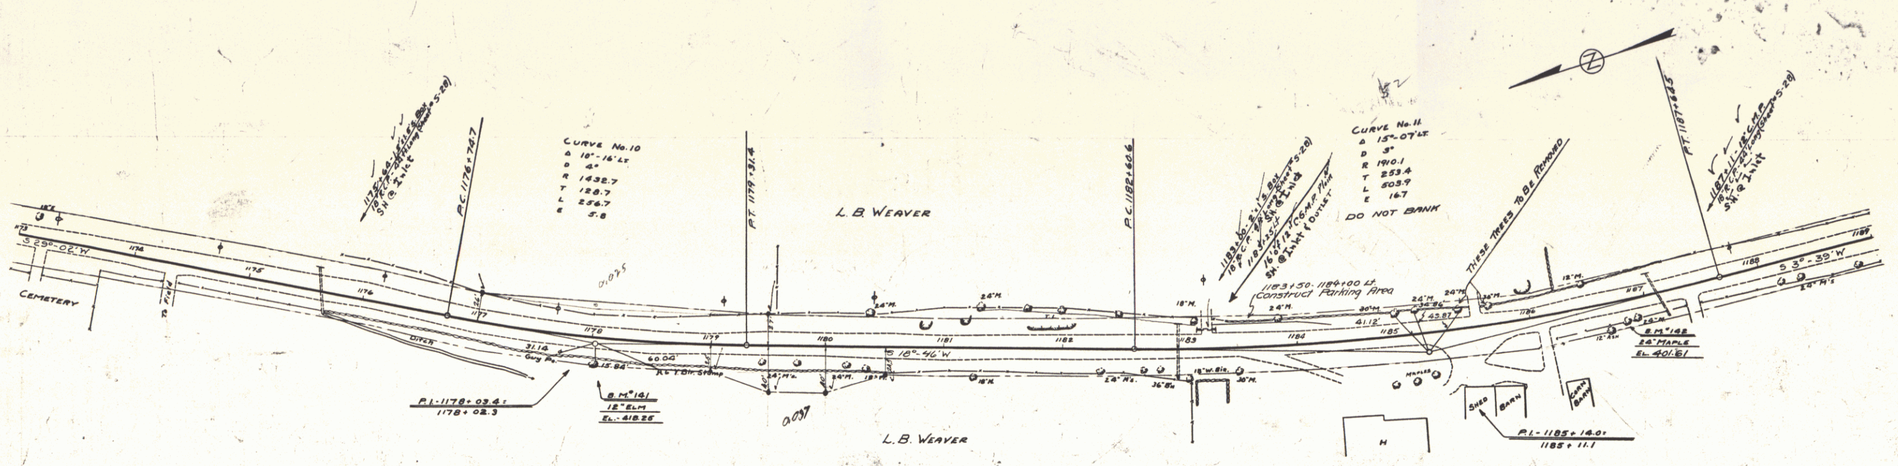

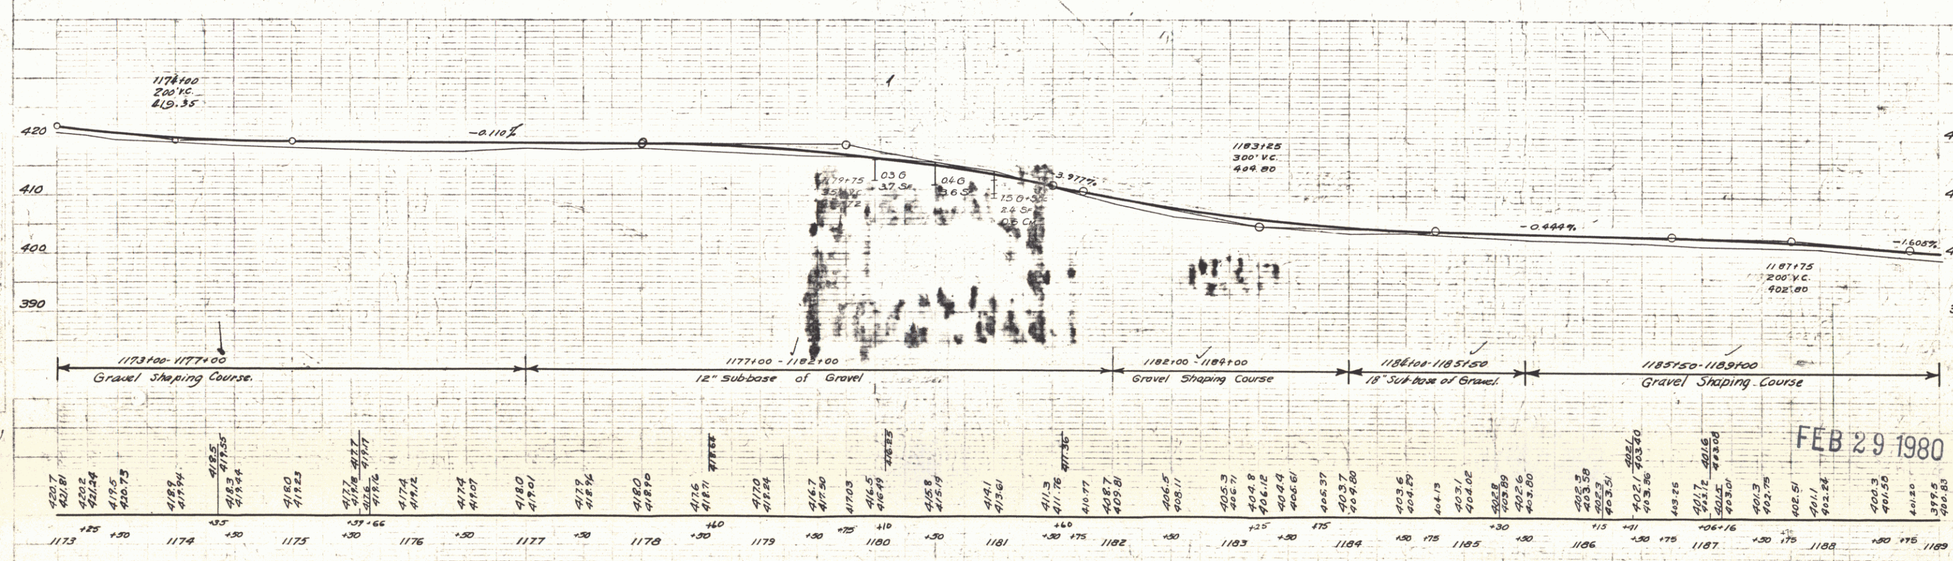

B.M. # 141 Spike in Root 12" Elm 21 ft. rt. Sta. 1178+02 Elev. 418.25
B.M. # 142 Spike in Root 24" Maple 15 ft. rt. Sta. 1186+81 Elev. 401.61

FEB 29 1980

SERIES F No 113C
SHEET 12 OF 69

10