



Parcel	Kind of Instrument	Date of Grant	Grantor	Grantee	Recorded Book & Page	Remarks
A48	QCD	7-31-33	Henry G. Baker	Shelby	26 386-7	8-3-33

STN.	STA.	RT.	LT.
861+00	862+00	128	128
861+00	862+00	74	74

STN.	RT.	LT.
865+10	3	
869+60	1	1

STN.	STA.	RT.	LT.
871+10	872+00	24	24
874+10	875+00	32	

LEG.	SCALE	STATE	FILE NO.	DATE	SHEET	TOTAL
				11/19/36	9	10
FAP No. 113-B-1936-4 9						

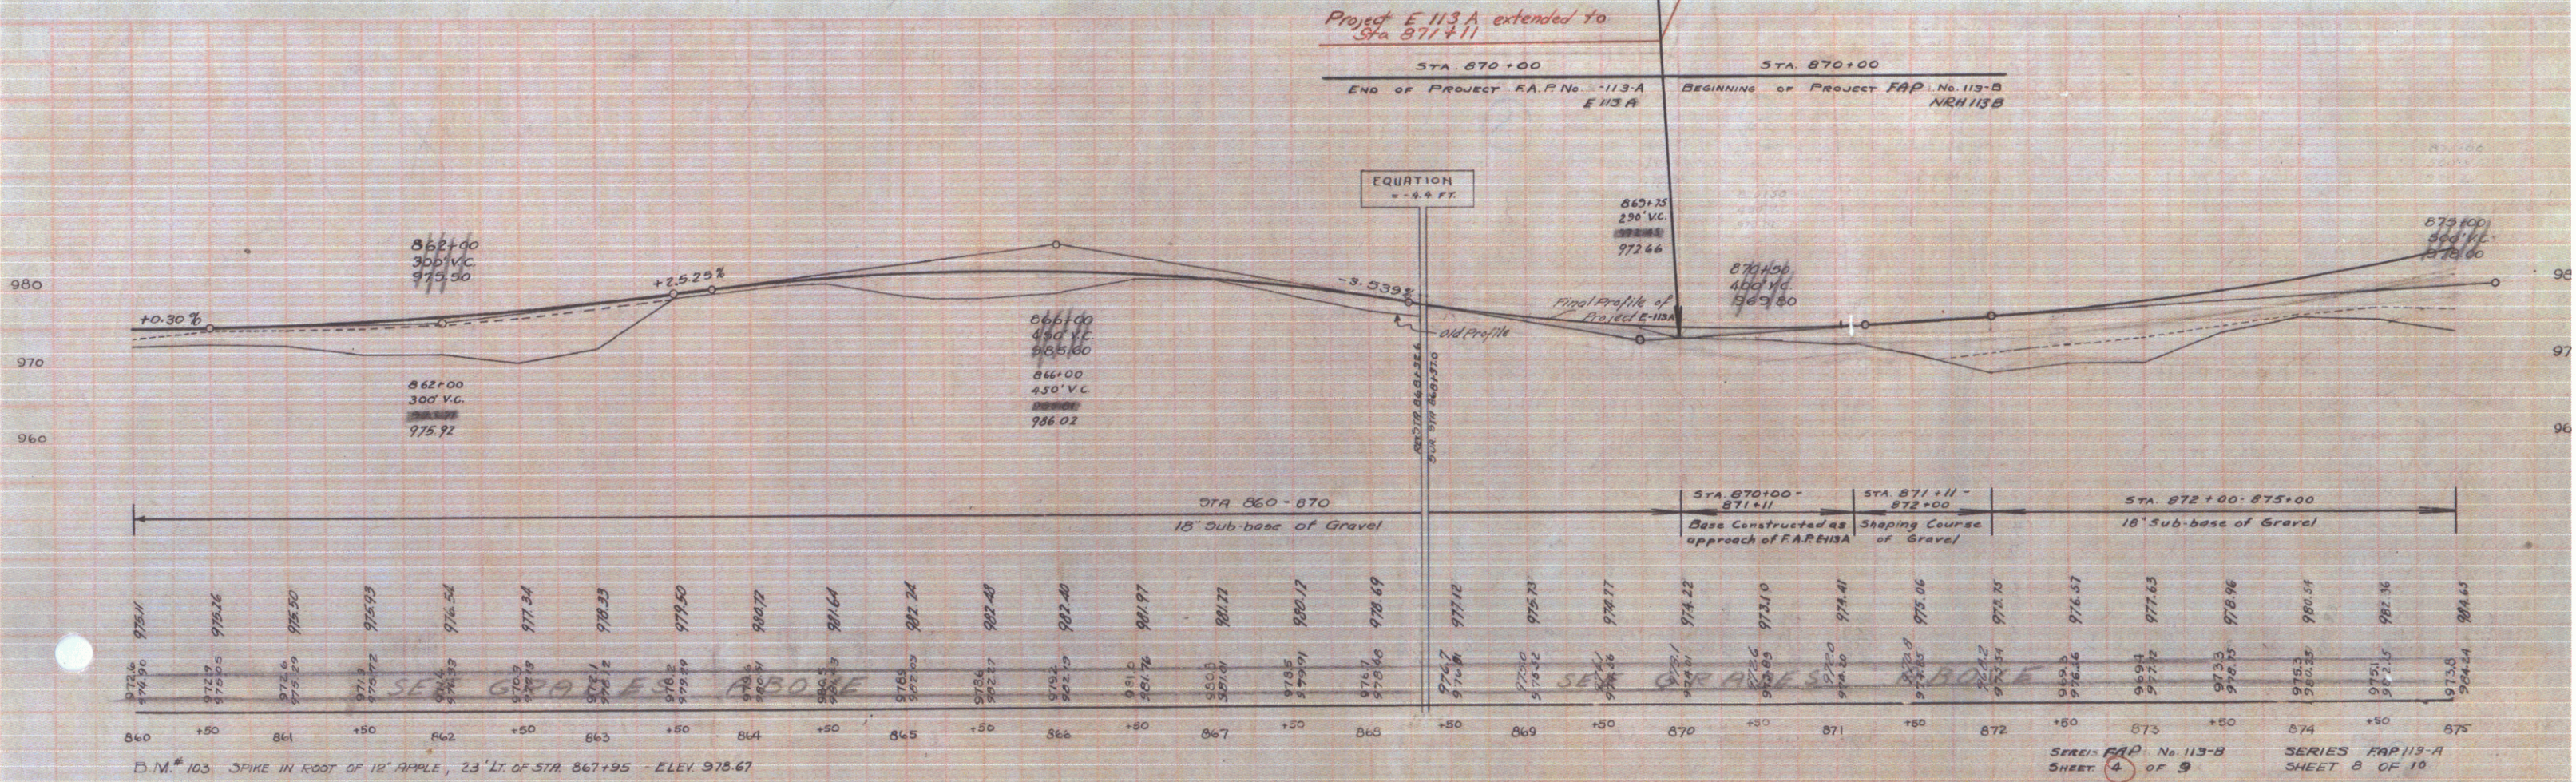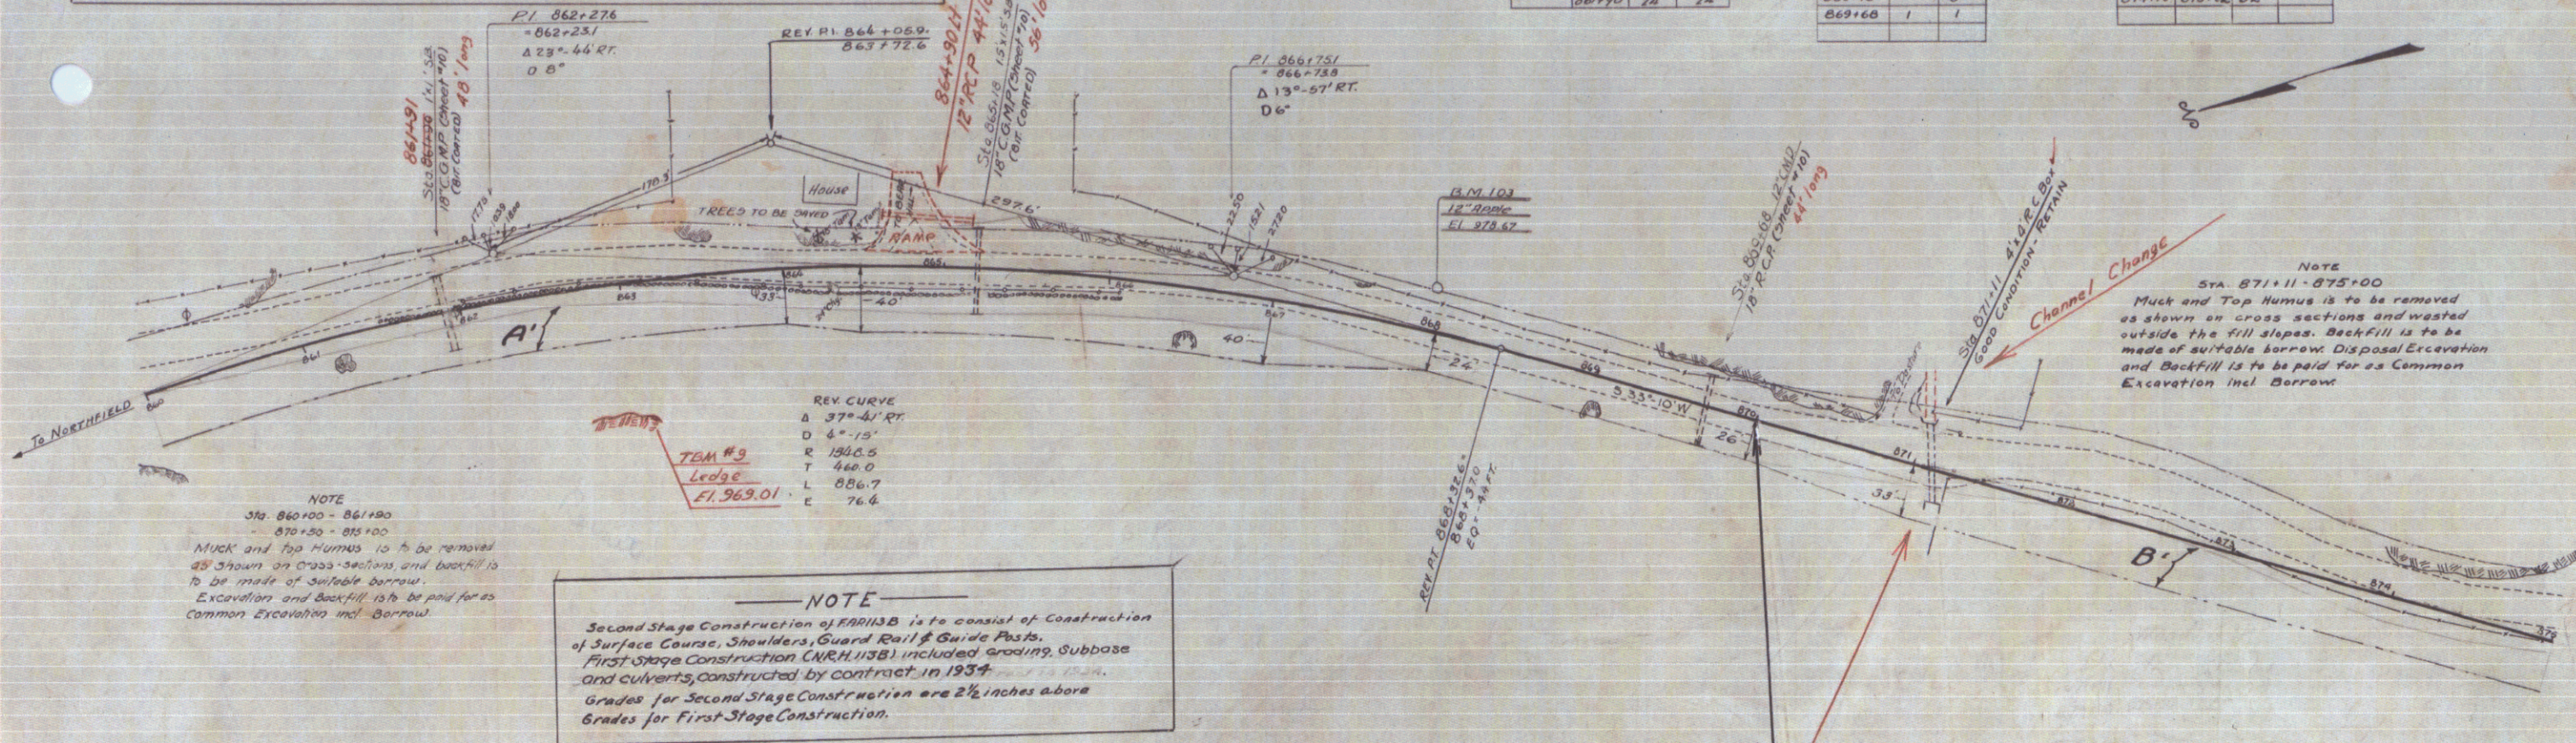

D.M. 103 SPIKE IN ROOT OF 12' APPLE, 23' LT. OF STA 867+95 - ELEV. 978.67

SERIES FAP No. 113-B SHEET 4 OF 9

SERIES FAP 113-A SHEET 8 OF 10