


Parcel Kind of Date of Granter Grantee Recorded Remarks  
 Instrument Cdr. # A25 Q.C.D. 7-25-35 C.J. Baker St of Vt. 27 1899 Book Page Date  
 8-28-35 Cdr. 5th 92840-2301-25

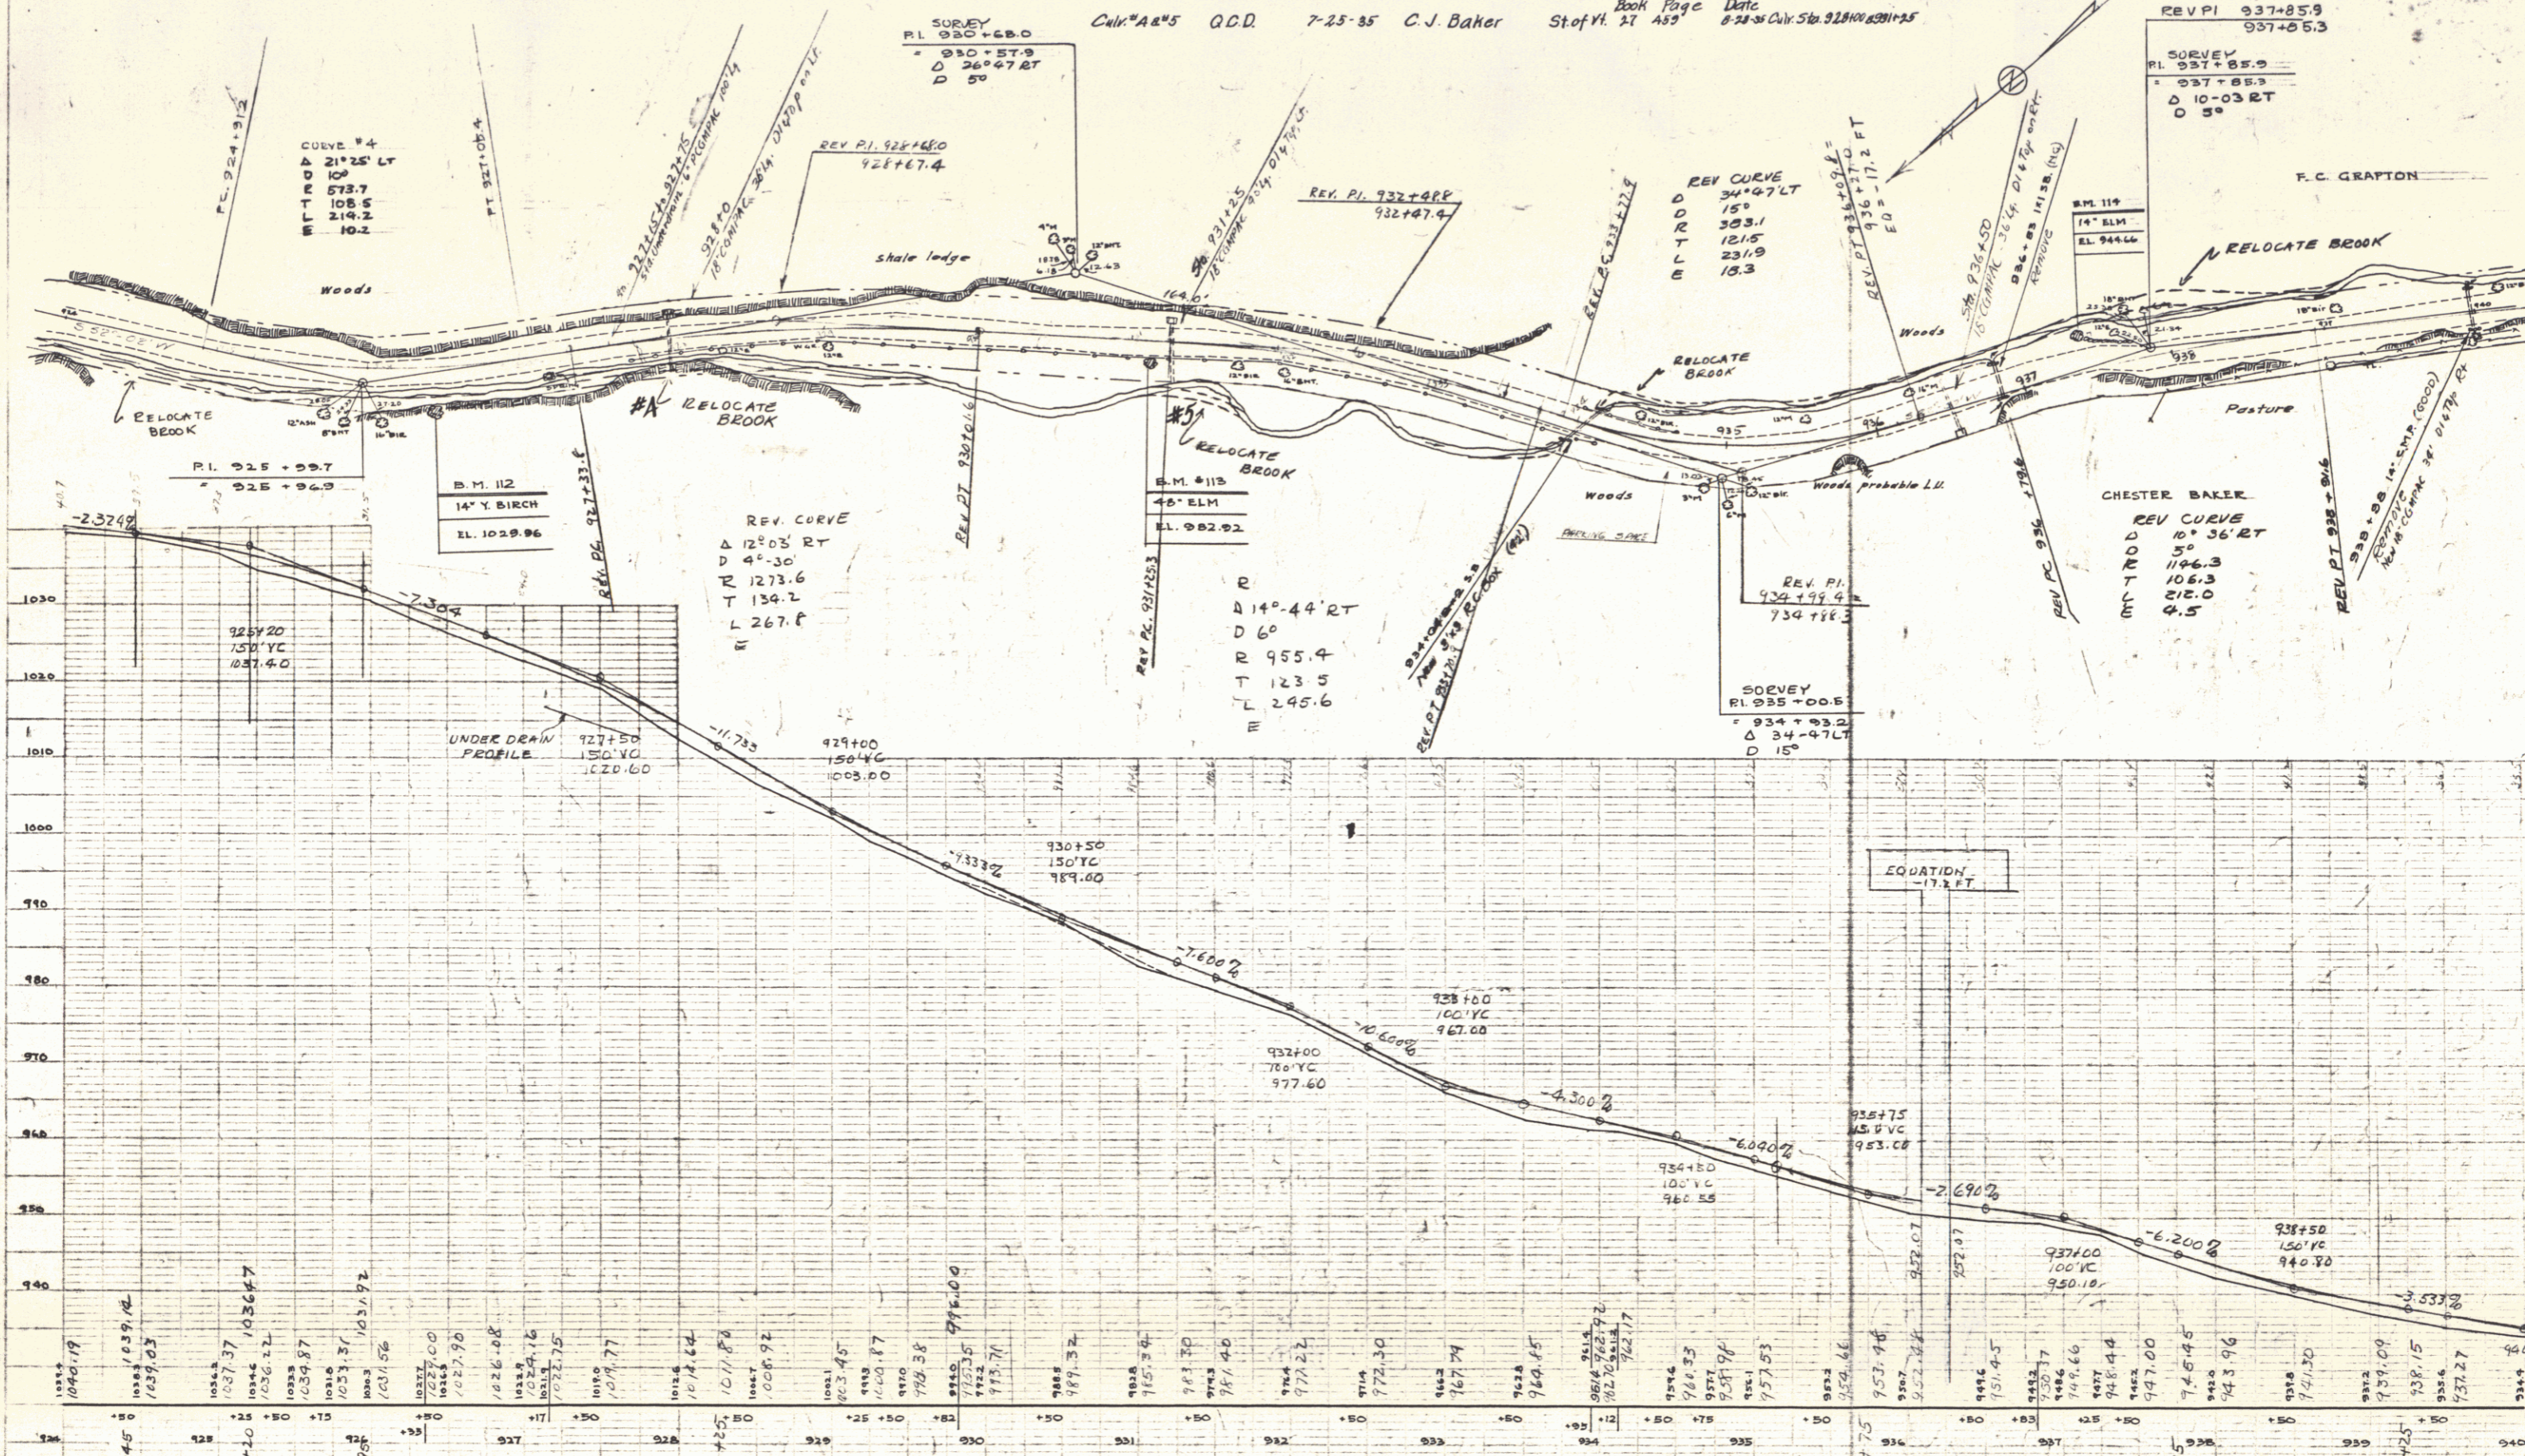

C. PUTNAM  
 S. MACCHI  
 D. MACCHI

S. PUTNAM  
 S. MACCHI

B.M. # 112	SPIKE	IN	ROOT	14"	BIRCH	25'	LT.	STA.	926+48	EL.	1029.96
B.M. # 113	"	"	TRUNK	40"	ELM	22'	RT.	STA.	931+15	EL.	982.92
B.M. # 114	"	"	ROOT	14"	ELM	21'	LT.	STA.	937+40	EL.	944.66

FEB 29 1980  
 SHEET 2

PLATE 1 - 1/2" = 100' - 1/4" = 100' - 1/8" = 100'