


PLAN
 C. E. PUTNAM
 D. MACCHI
 2/24
 3/24
 TRACED

PLAN
 C. E. PUTNAM
 D. MACCHI
 2/24
 3/24
 TRACED

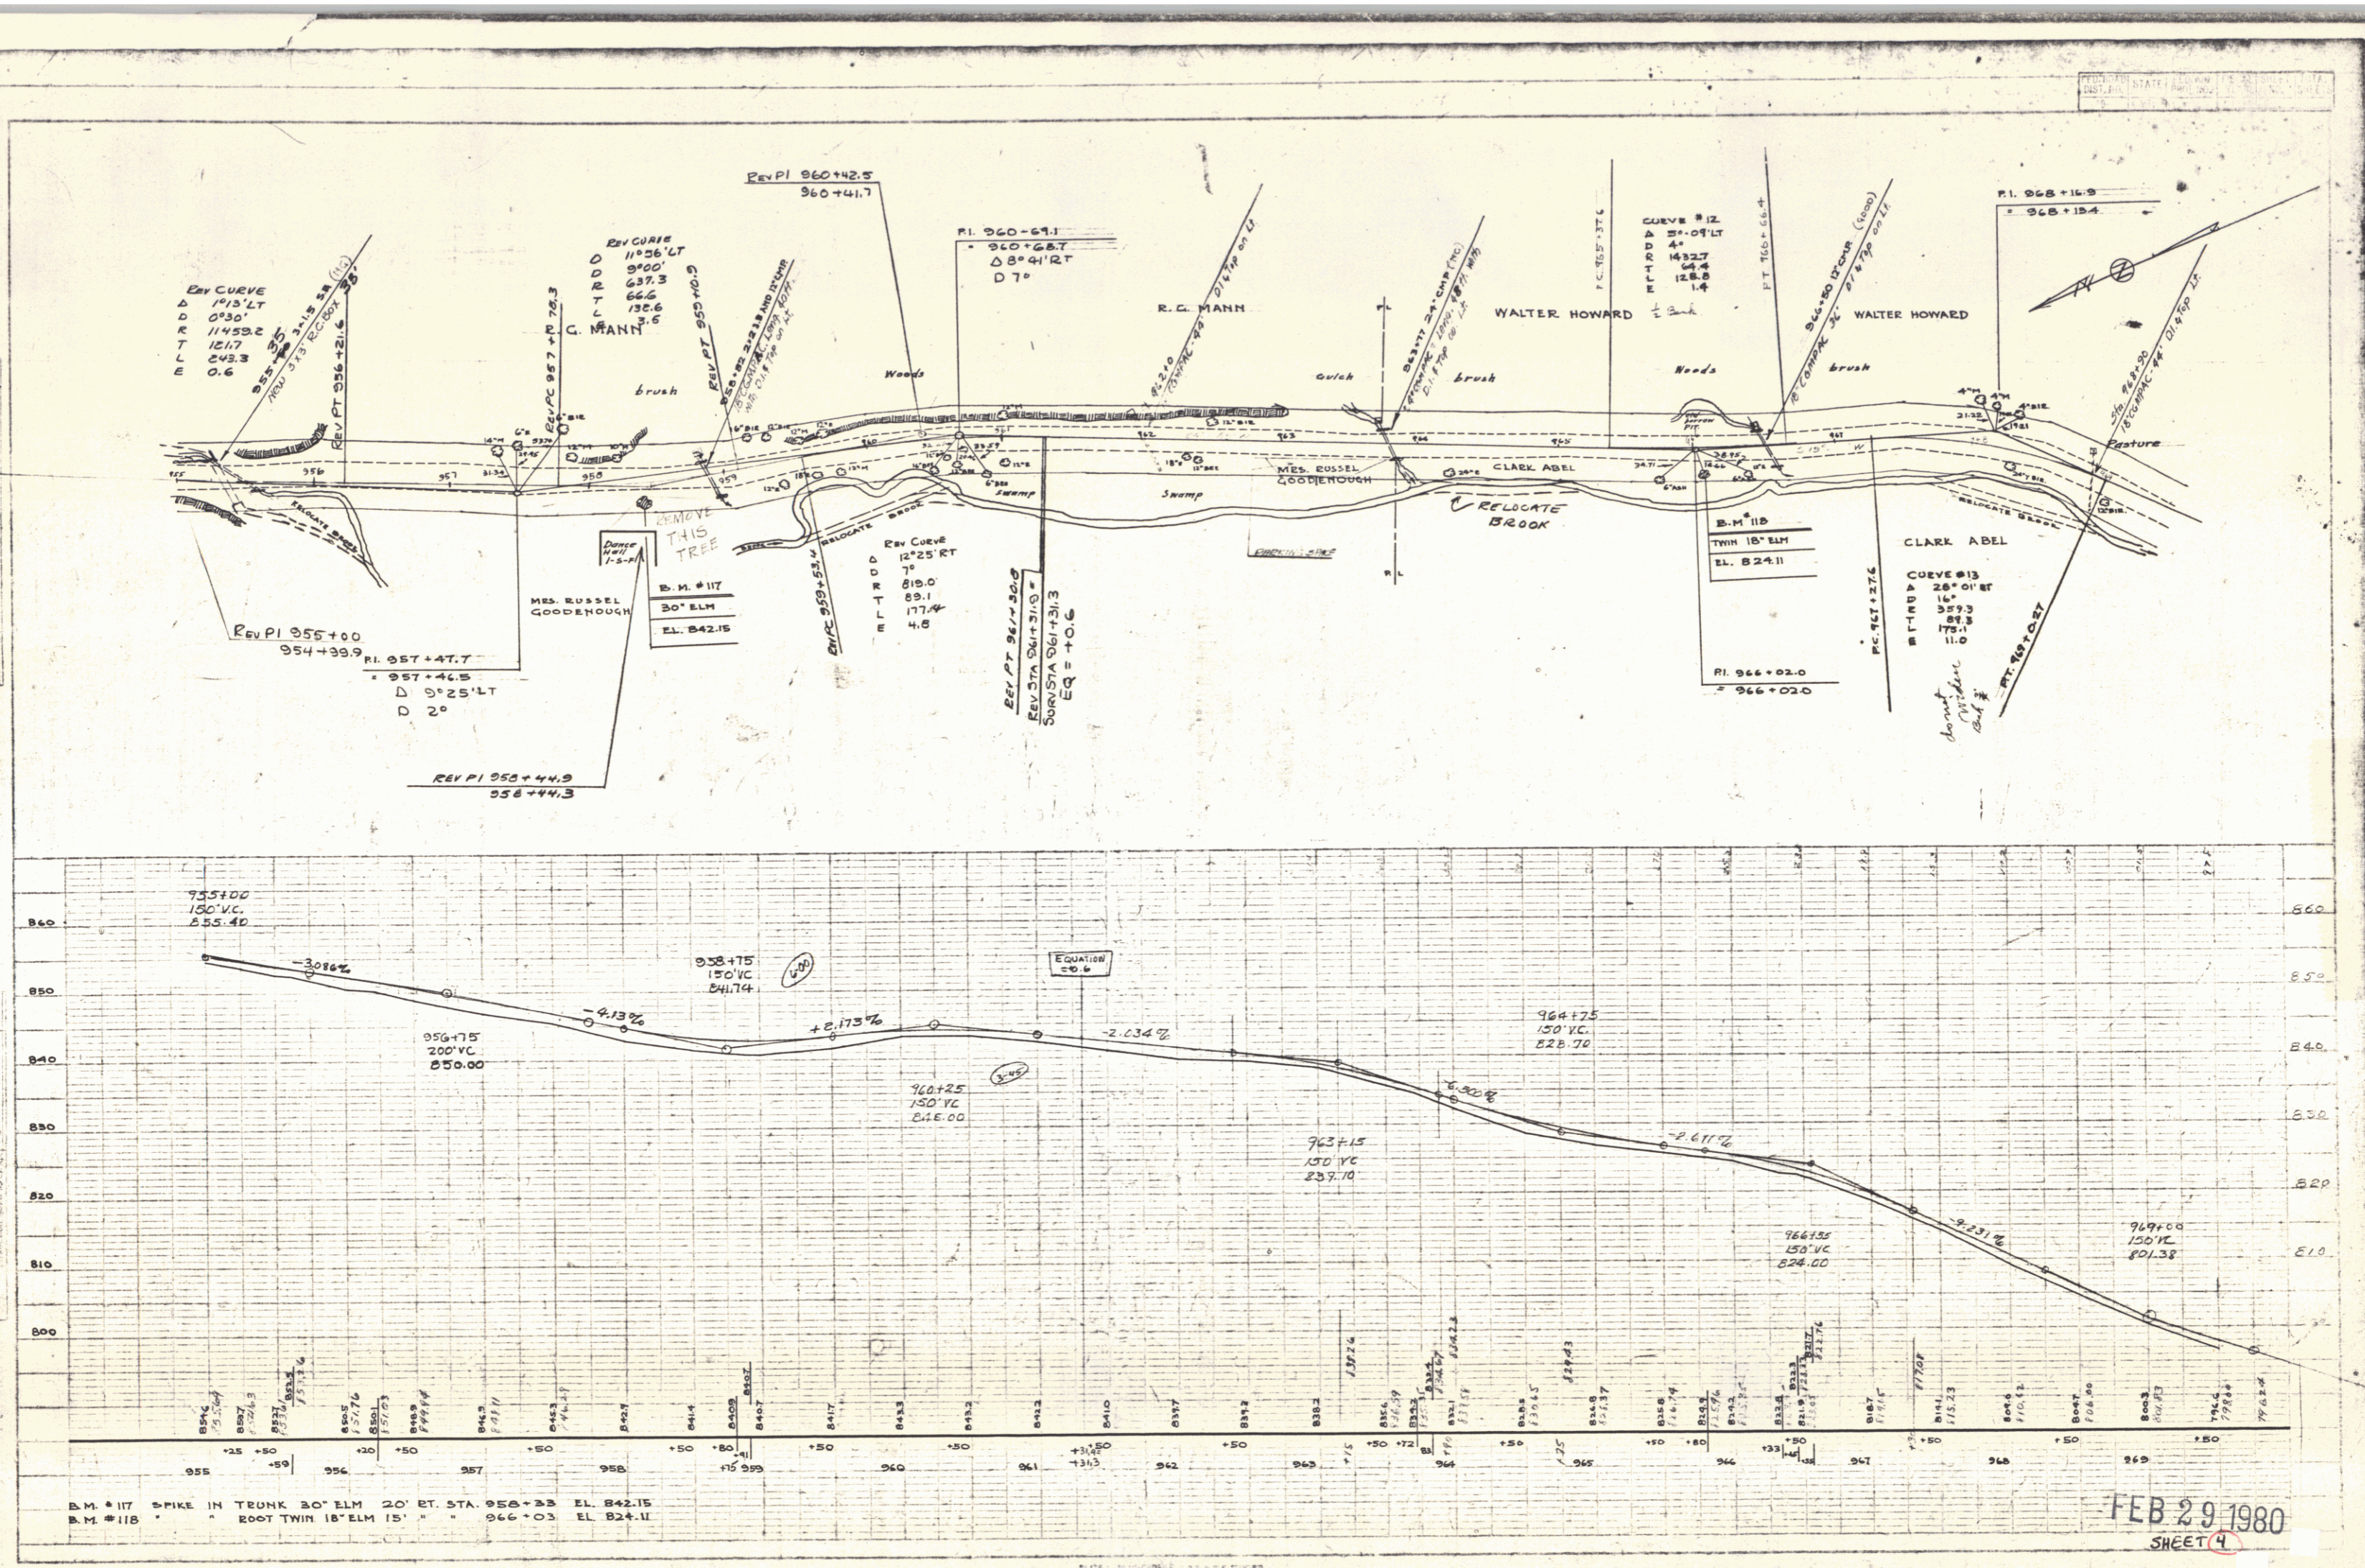

B.M. #117 SPIKE IN TRUNK 30' ELM 20' RT. STA. 958+33 EL. 842.15
 B.M. #118 ROOT TWIN 18' ELM 15' " 966+03 EL. 824.11

FEB 29 1980
 SHEET 4

4