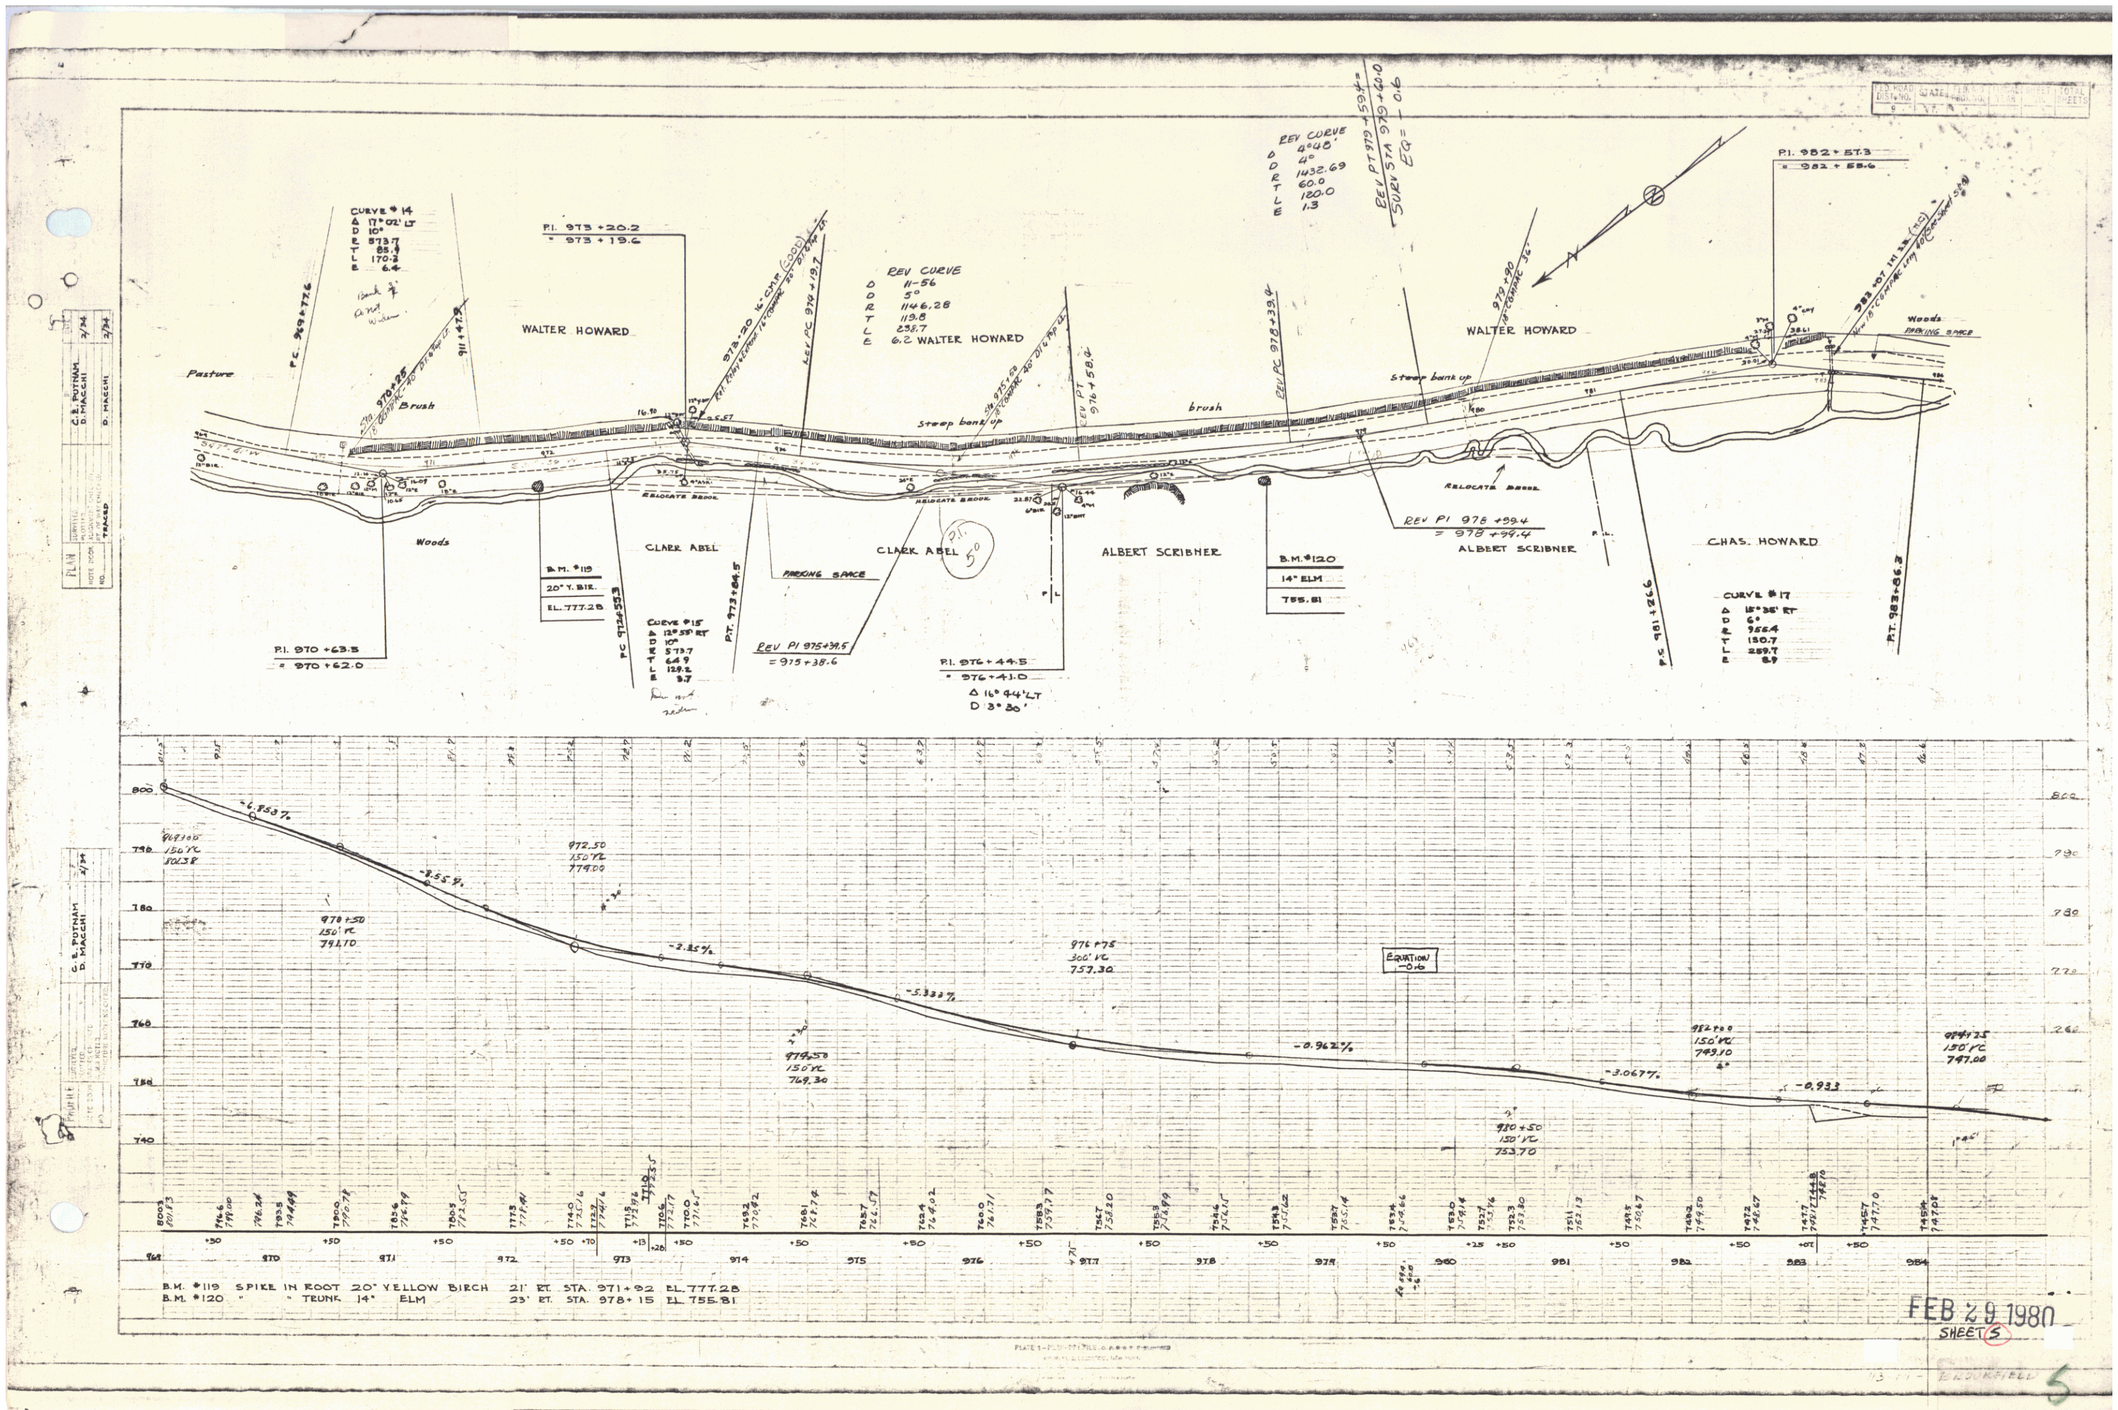
WALTER HOWARD
CLARK ABEL
ALBERT SCRIBNER
CHAS. HOWARD
Pasture
Brush
Woods
Steep bank up
RELOCATE BROOK
PARKING SPACE
B.M. #119
20" Y. BIR.
EL. 777.28
B.M. #120
14" ELM
755.81
P.I. 970 +63.3
= 970 +62.0
P.I. 973 +20.2
= 973 +19.6
P.I. 976 +44.5
= 976 +41.0
Δ 16° 44' LT
D 3° 30'
REV P.I. 975+39.5
= 975+38.6
REV P.I. 978 +39.4
= 978 +39.4
P.I. 982 + 57.3
= 982 + 55.6
EQUATION
-0.6
B.M. #119 SPIKE IN ROOT 20" YELLOW BIRCH 21' RT. STA. 971+92 EL. 777.28
B.M. #120 " " TRUNK 14" ELM 23' RT. STA. 978+15 EL. 755.81
FEB 20 1980
SHEET 5